INTERNAL UTILITIES

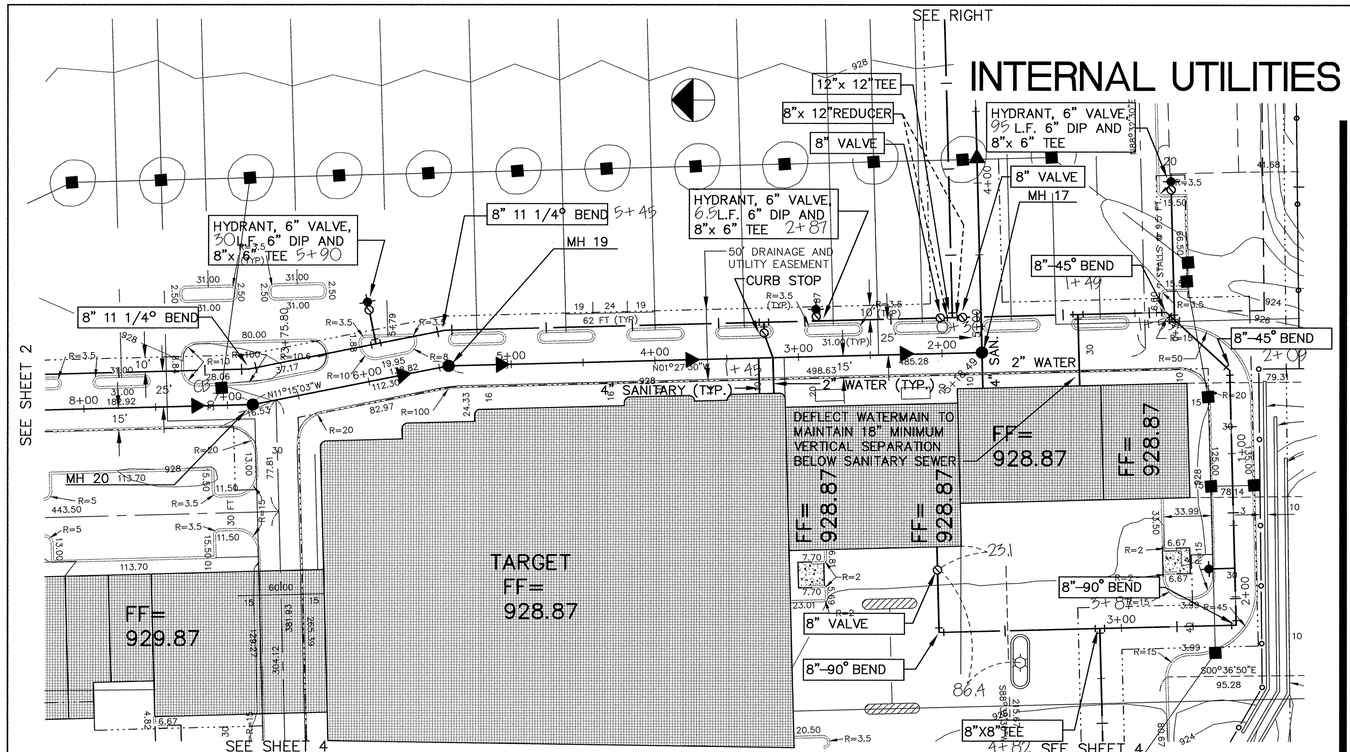

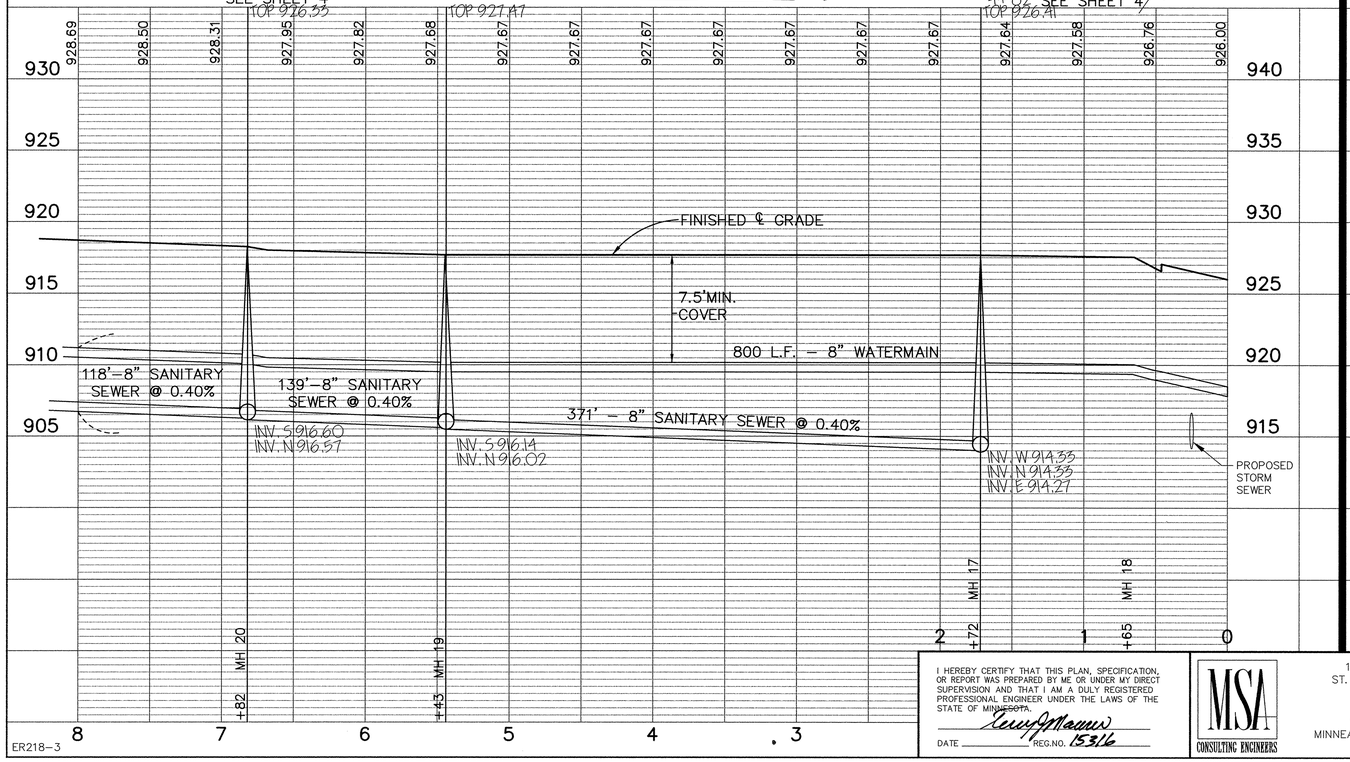

RECORD PLAN
MARCH 1997

I HEREBY CERTIFY THAT THIS PLAN, SPECIFICATION, OR REPORT WAS PREPARED BY ME OR UNDER MY DIRECT SUPERVISION AND THAT I AM A DULY REGISTERED PROFESSIONAL ENGINEER UNDER THE LAWS OF THE STATE OF MINNESOTA.

DATE _____ REG.NO. 15316

MSA CONSULTING ENGINEERS

1326 ENERGY PARK DRIVE
ST. PAUL, MINNESOTA 55108
(612) 644-4389

9800 SHELARD PARKWAY
MINNEAPOLIS, MINNESOTA 55441
(612) 546-0432

REVISIONS	DATE	DESCRIPTION

DESIGNED ____
CHECKED ____
DRAWN CLS
GRAPHIC SCALE
0 HORIZ. 50
0 VERT. 5

CITY OF ELK RIVER
ELK PARK CENTER
SANITARY SEWER AND WATERMAIN
INTERNAL UTILITIES

STA.
0+00 TO 5+18
0+00 TO 8+00

DATE MAY 1994 | SHEET 1 OF 6 SHEETS | PROJECT NO. 230-218

ER218-3

1153

DRAWING NUMBER
SAFCO PRODUCTS • NEW HOPE, MINNESOTA
REORDER BY PART NUMBER 15092
POSITIVE CLOSE OFF PANEL MR 1995 LABEL

DRAWING NUMBER
SAFCO PRODUCTS • NEW HOPE, MINNESOTA
REORDER BY PART NUMBER 15092
POSITIVE CLOSE OFF PANEL MR 1995 LABEL

DRAWING NUMBER
ELKPA 94
2
(1 of 6)
SAFCO PRODUCTS • NEW HOPE, MINNESOTA
REORDER BY PART NUMBER 15092
POSITIVE CLOSE OFF PANEL MR 1995 LABEL

D:\CAD\ElkRiver\ER218\Er218-3.dwg Tue Dec 30 11:11:29 1997