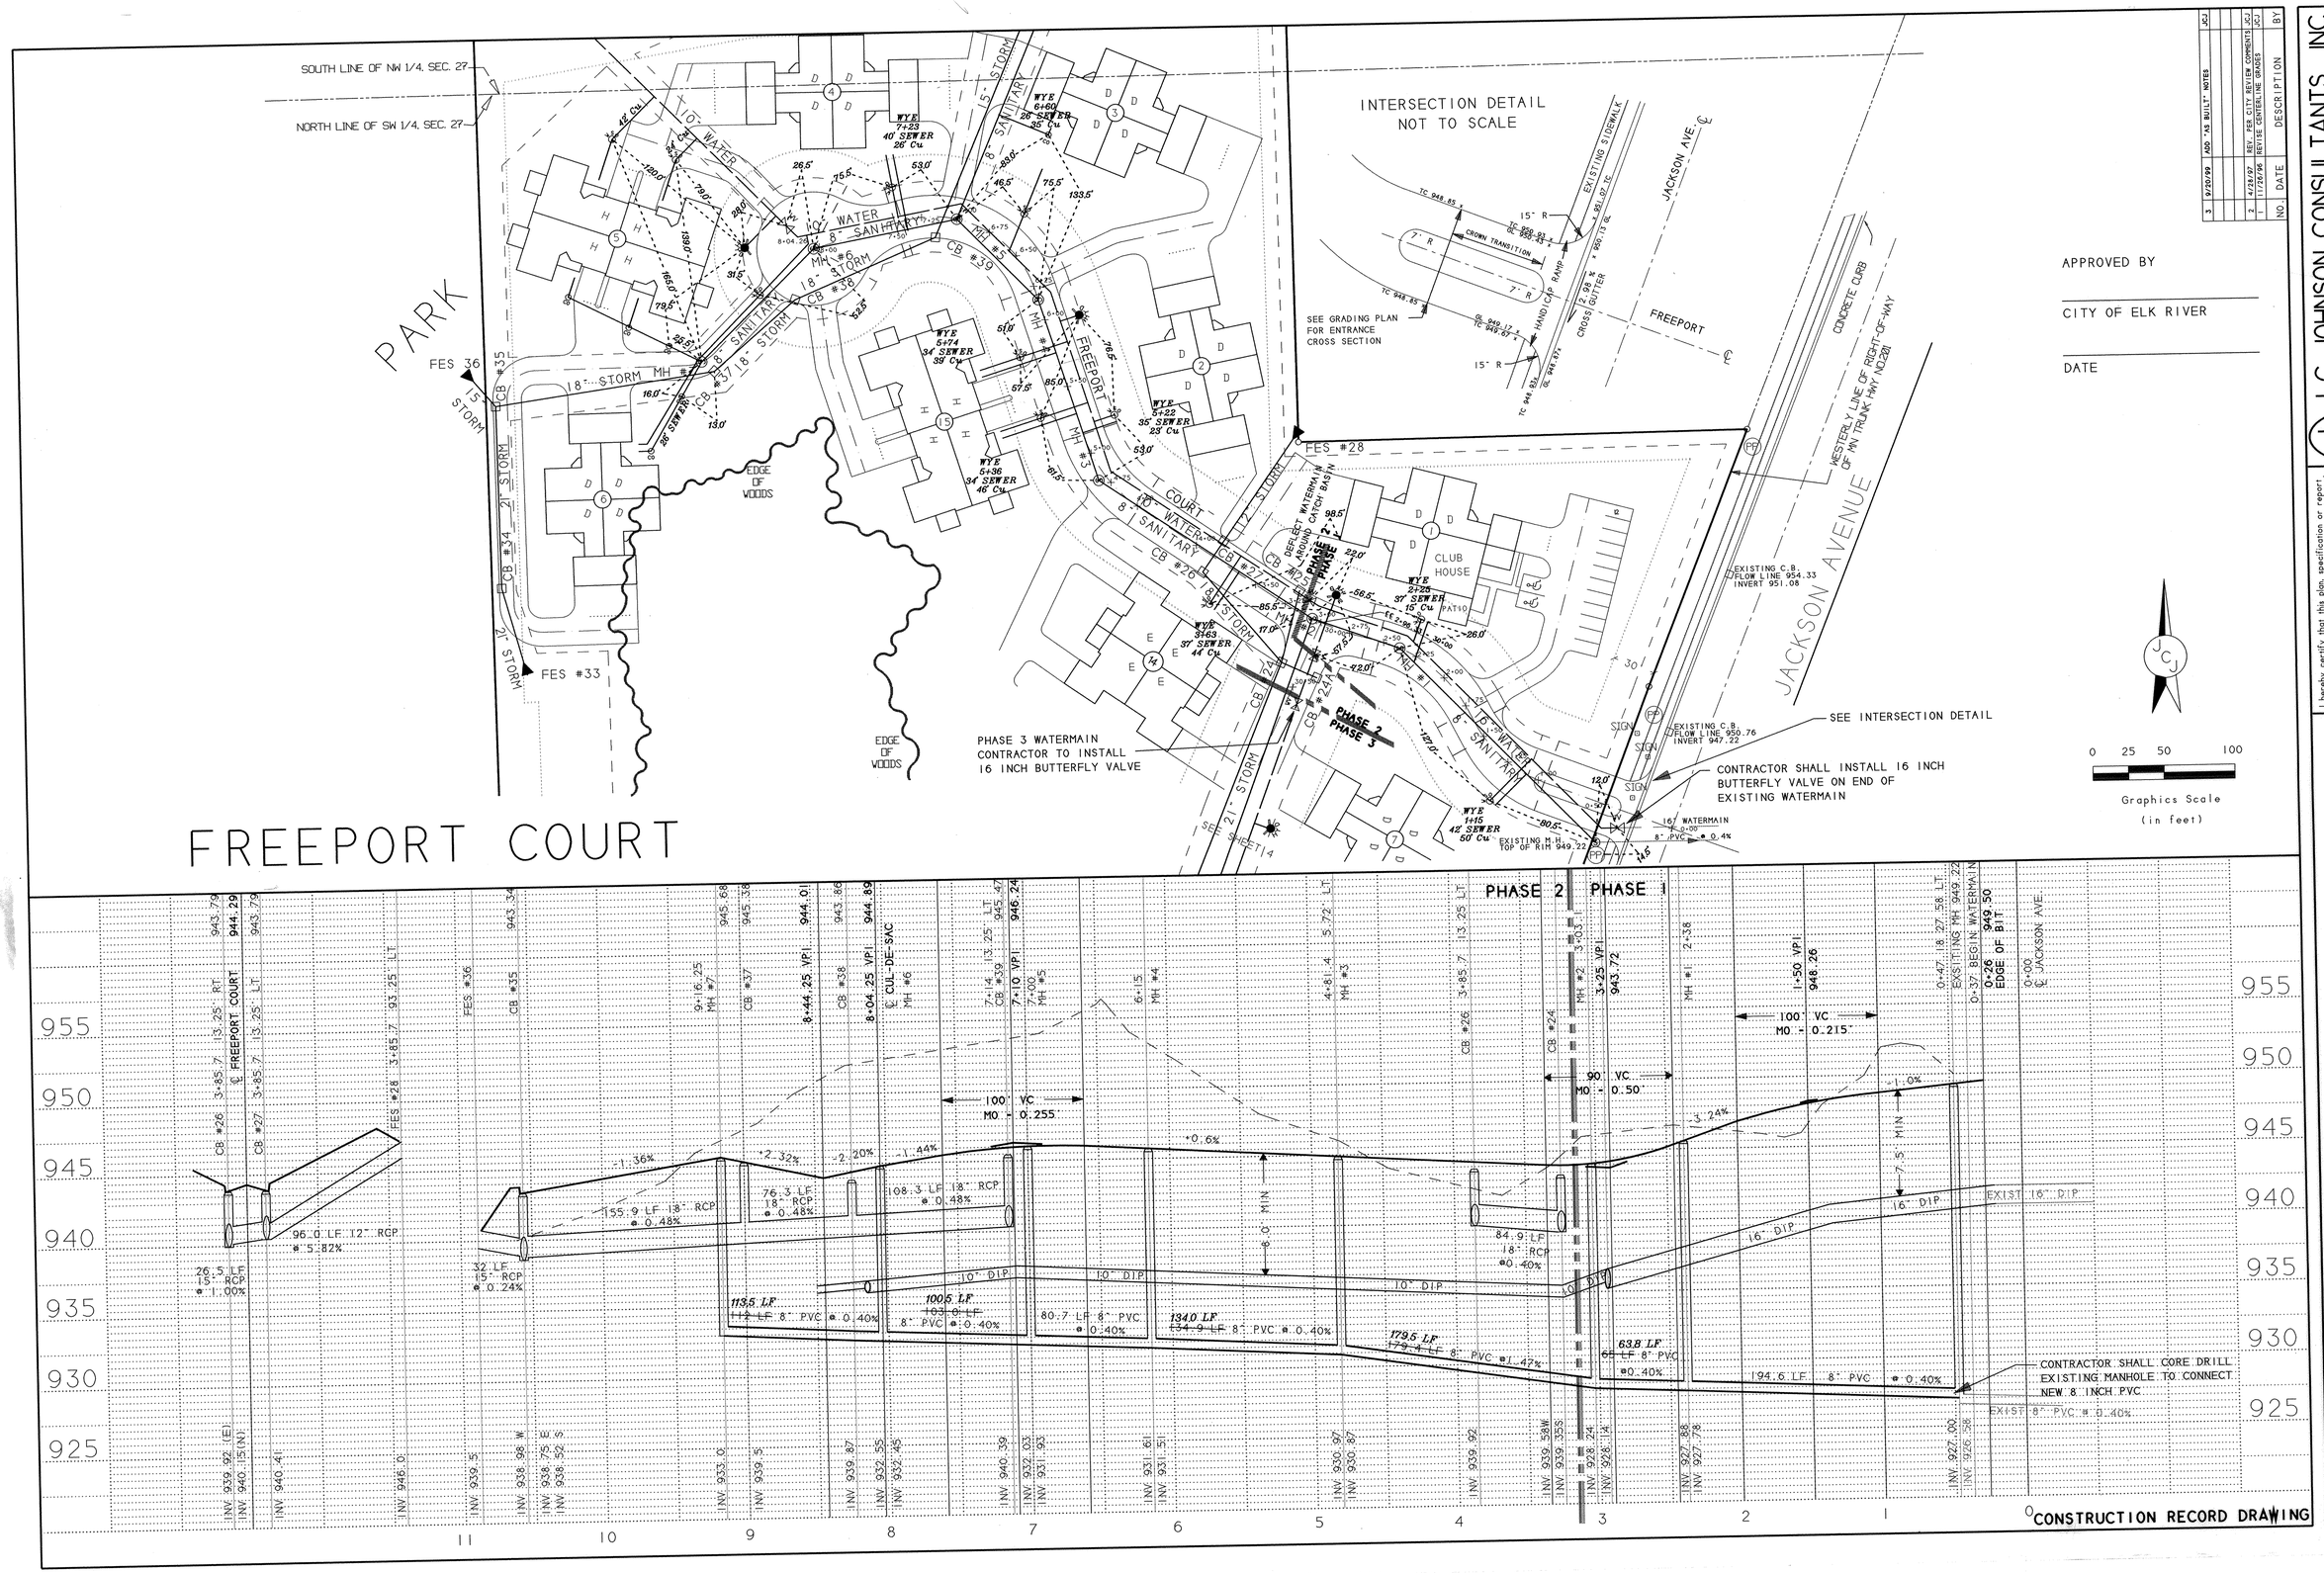


| NO. | DATE | DESCRIPTION | BY |
|---|---|---|---|
| 3 | 9/20/99 | ADD "AS BUILT" NOTES | JCJ |
| 2 | 4/25/97 | REV. PER CITY REVIEW COMMENTS | JCJ |
| 1 | 11/26/96 | REVISE CENTERLINE GRADES | JCJ |

I hereby certify that this plan, specification or report was prepared by me or under my direct supervision and that I am a duly Registered Professional Engineer under the laws of the State of Minnesota.

Reg. No. 11546 Date 9/20/99


J C JOHNSON CONSULTANTS, INC.
SITE PLANNING AND DESIGN
8618 Maryland Ave N Brooklyn Park, MN 55445
Phone: (612) 391-0243 FAX: (612) 391-0245


ELK RUN
PROFILE - FREEPORT COURT
COTTAGE HOMESTEADS OF ELK RIVER, INC
Sta. 0+00.00 - 9+66.25
Elk River, MN

DATE: 11/15/96
PROJECT NO. 950302
CADD FILE: PRO-1
SHEET 1 OF 5

DRAWING NUMBER

ELKRU 99
1

1359