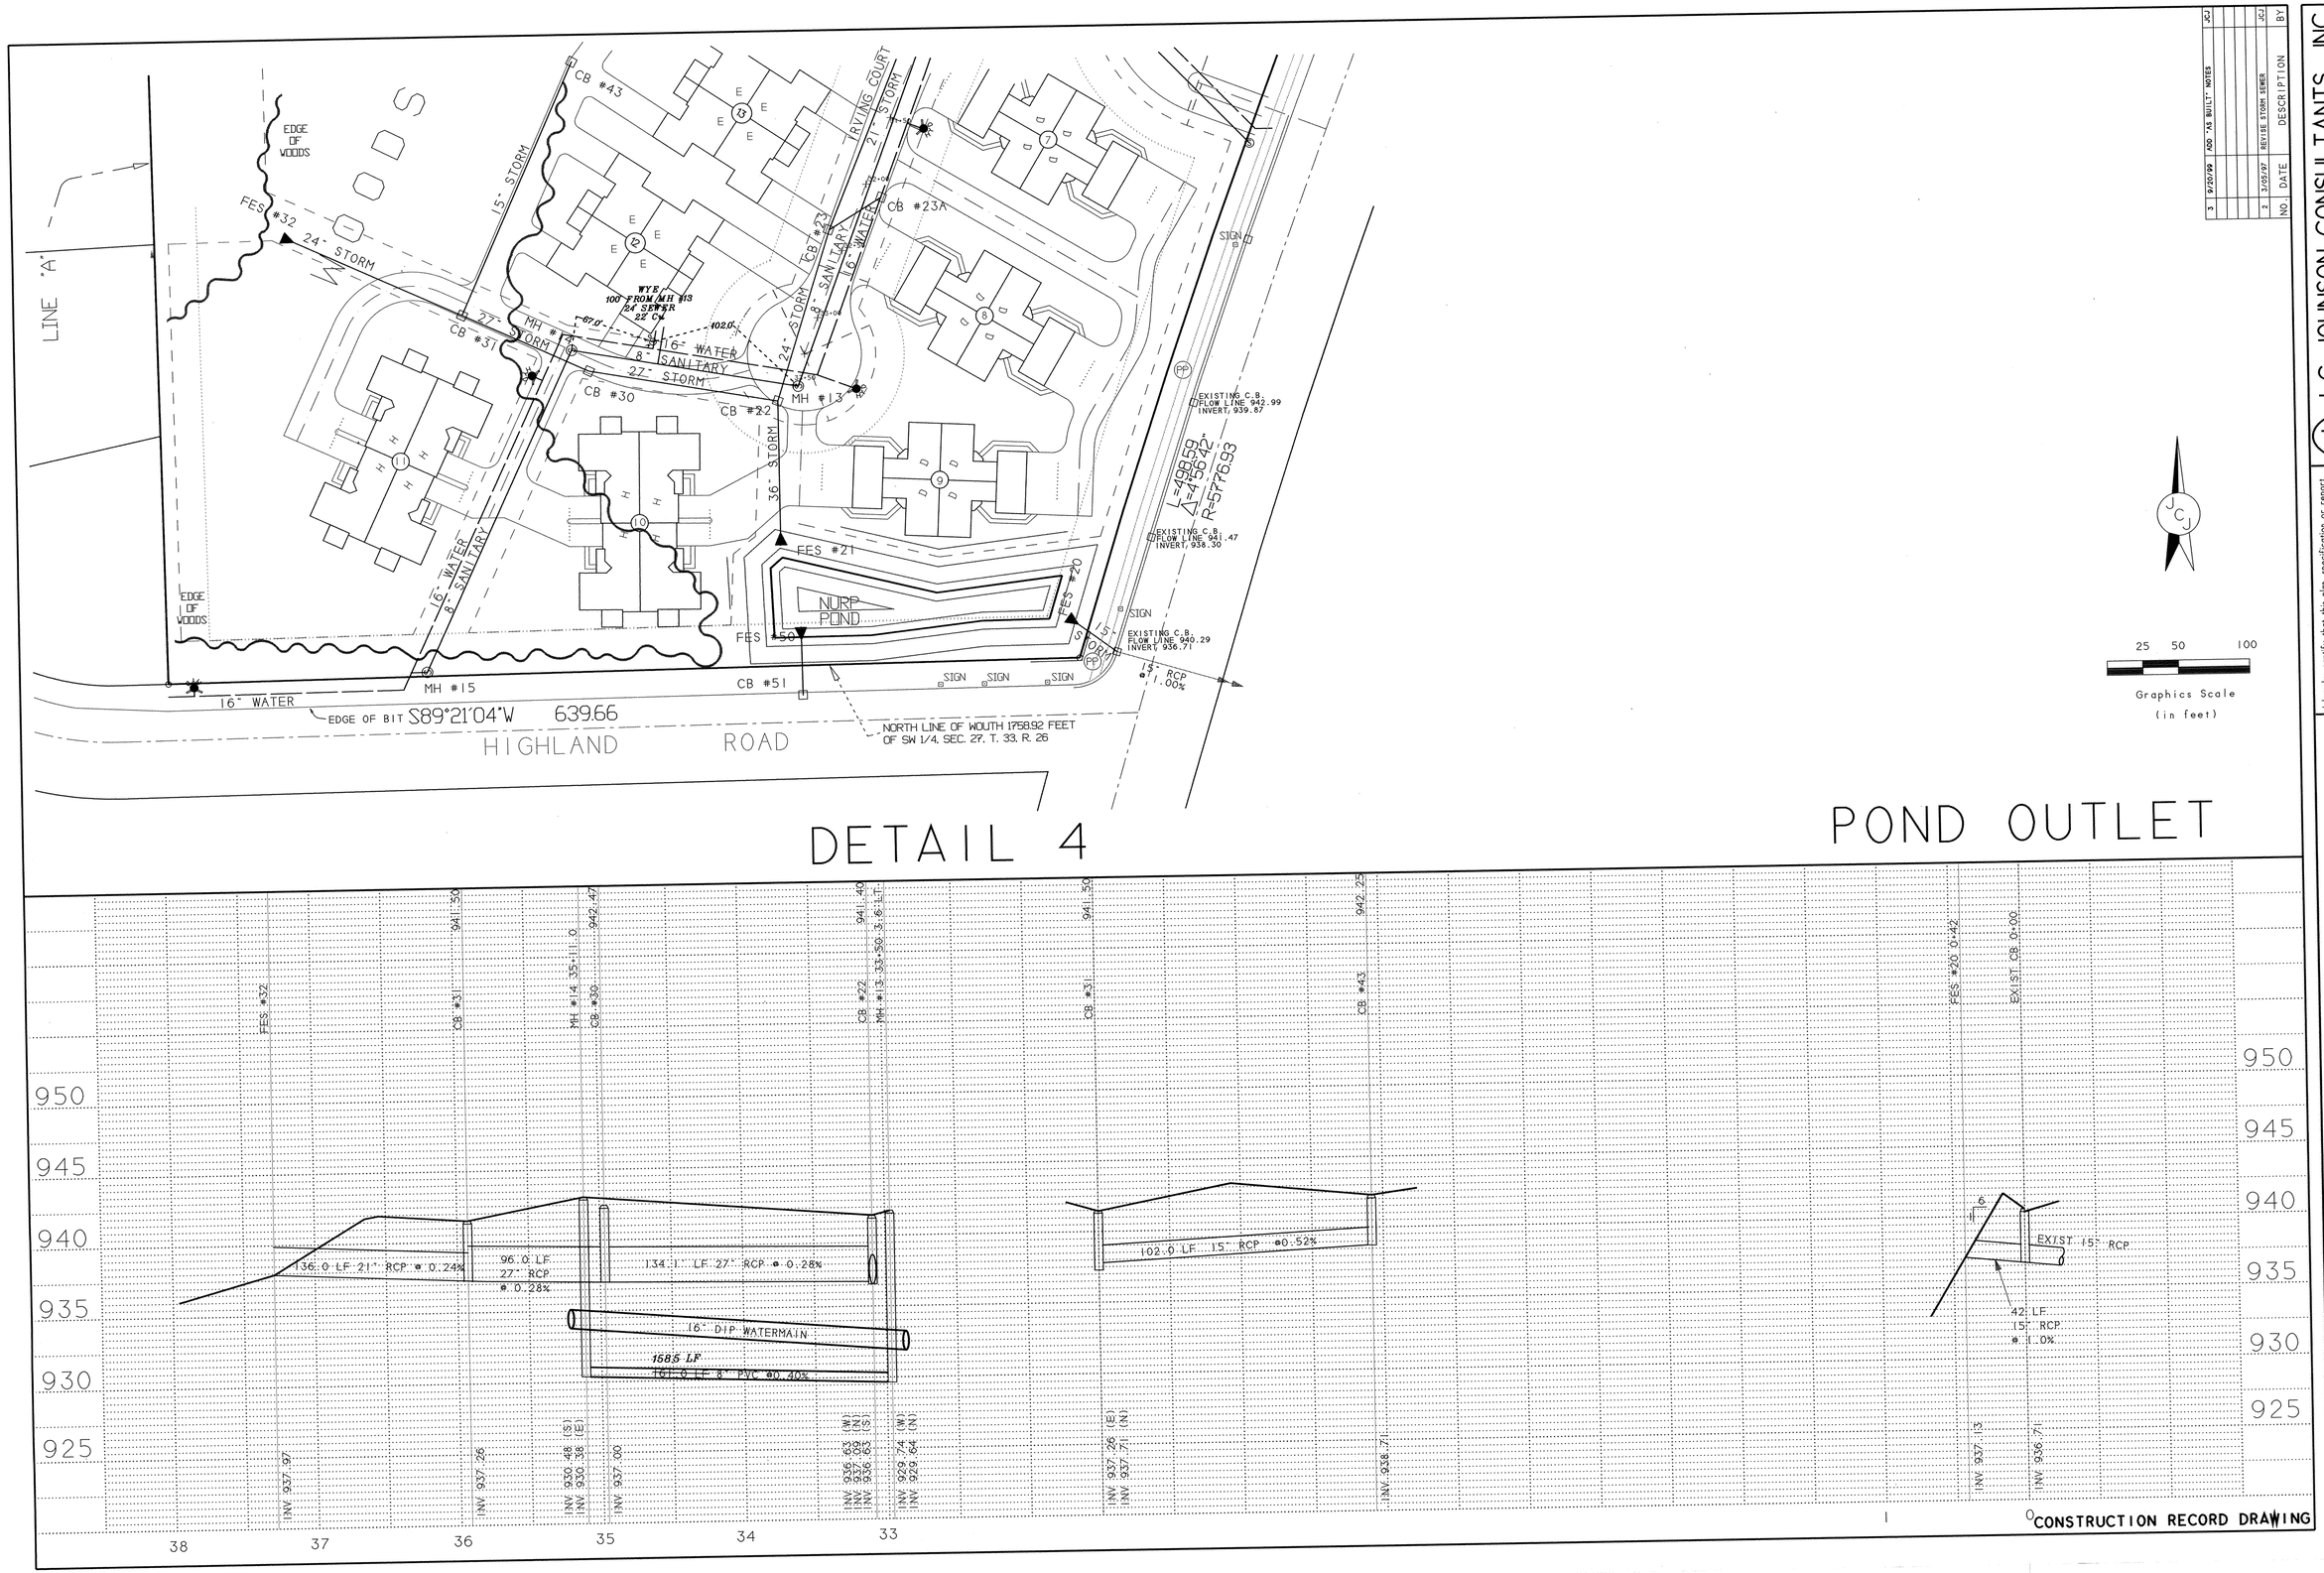

NO.	DATE	DESCRIPTION	BY
3	9/20/99	ADD "AS BUILT" NOTES	JCJ
2	3/05/97	REVISE STORM SEWER	JCJ

J C JOHNSON CONSULTANTS, INC.
SITE PLANNING AND DESIGN
8618 Maryland Ave N Brooklyn Park, MN 55445
Phone: (612) 391-0243 FAX: (612) 391-0245

I hereby certify that this plan, specification or report was prepared by me or under my direct supervision and that I am a duly registered Professional Engineer under the laws of the State of Minnesota.

Reg. No. 11546 Date 9/20/99

ELK RUN
PROFILE - DETAIL 4 & POND OUTLET
COTTAGE HOMESTEADS OF ELK RIVER, INC.
0+00.00 -
Detail 4

DATE: 10/1/96
PROJECT NO.: 950302
CADD FILE: PRO-5

SHEET 5 / 5

DRAWING NUMBER
SAFCO PRODUCTS • NEW HOPE, MINNESOTA
REORDER BY PART NUMBER 8552

DRAWING NUMBER
SAFCO PRODUCTS • NEW HOPE, MINNESOTA
REORDER BY PART NUMBER 8552

ELKRU.99
5

1355