JOPLIN STREET

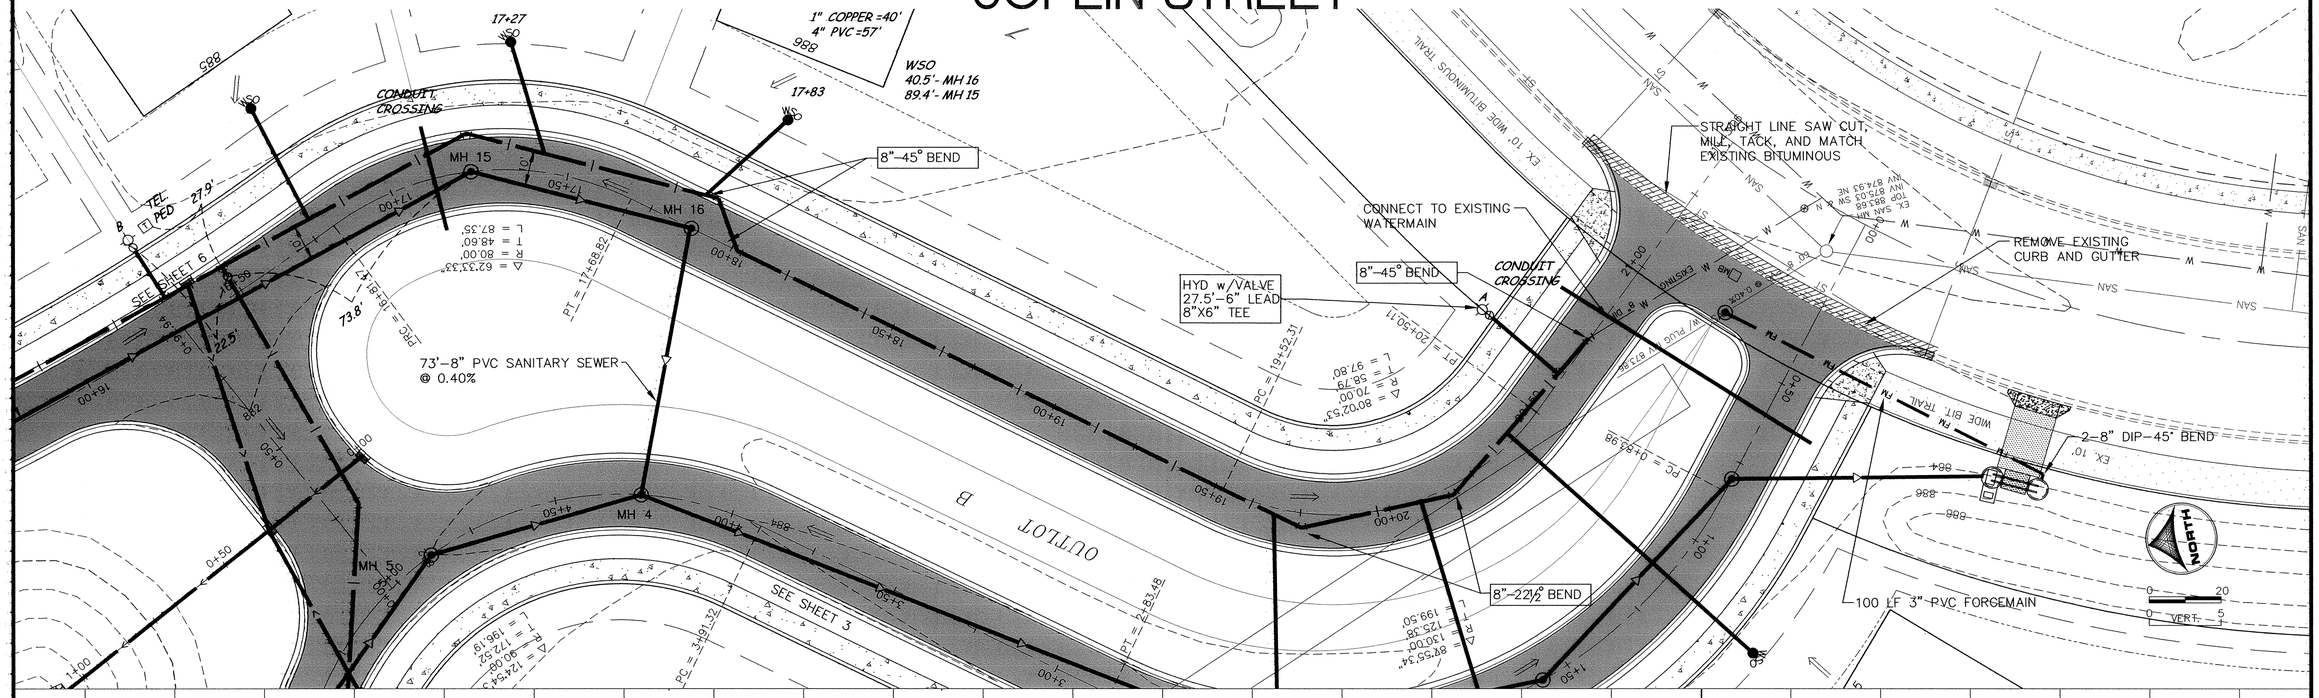

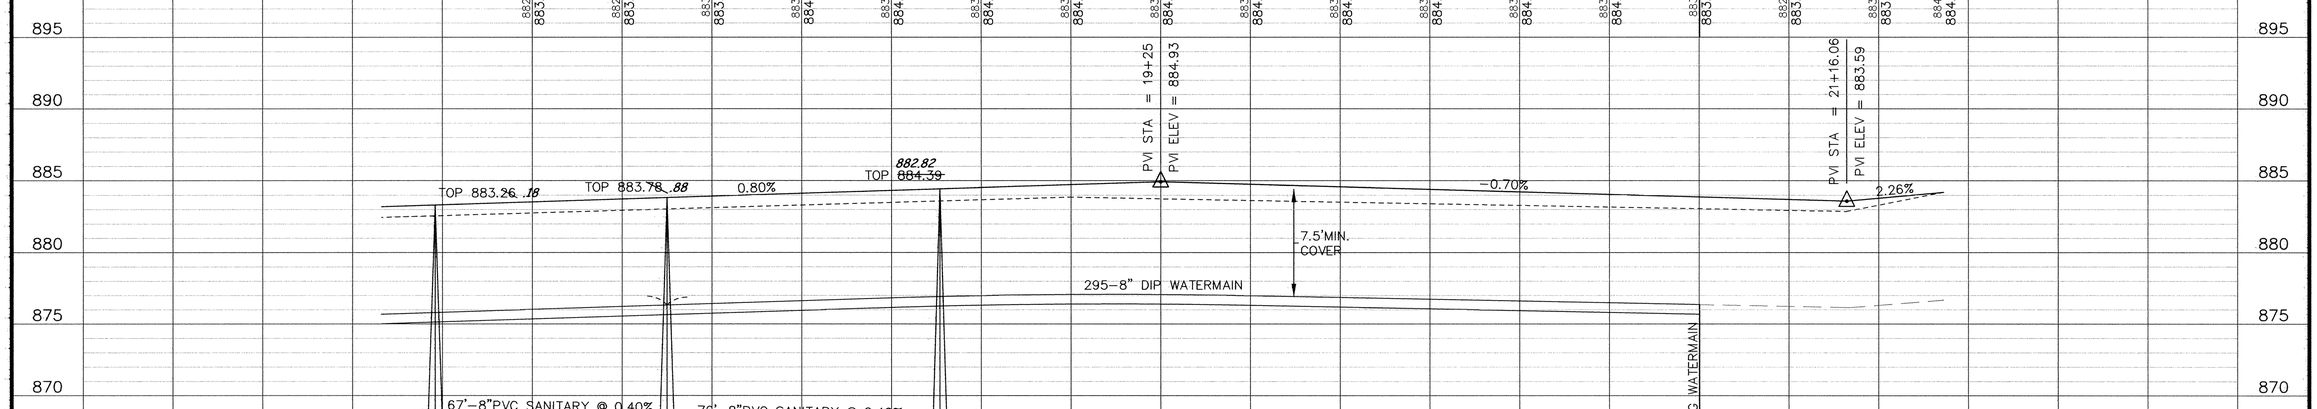

Xrefs: 810641ASBUILT-BASE.DWG

DESIGNED BY: _____ DRAWN BY: LK
APPROVED BY: _____ JOB NUMBER 810641J
CAD DATE: January 20, 2005 2:18:23 p.m.
CAD FILE: 810641J\asbuilts\810641P6A.DWG (JCUNNIN)

I HEREBY CERTIFY THAT THIS PLAN, SPECIFICATION, OR REPORT WAS PREPARED BY ME OR UNDER MY DIRECT SUPERVISION AND THAT I AM A DULY LICENSED PROFESSIONAL ENGINEER UNDER THE LAWS OF THE STATE OF MINNESOTA.

SIGNATURE _____ DATE 2/2/05

PRINTED NAME JOHN M. ANDERSON LIC.NO. 25889

NO.	DATE	BY	REVISION DESCRIPTION

1326 ENERGY PARK DRIVE
ST. PAUL, MINNESOTA 55108
(612) 644-4389
Howard R. Green Company
CONSULTING ENGINEERS

FOX HAVEN

CITY OF ELK RIVER

PLAN AND PROFILE

JOPLIN STREET

STA. 17+50 TO 21+43.06

SHEET NO. 7

DRAWING NUMBER FOXHA.05 7

SAFCO PRODUCTS • NEW HOPE, MINNESOTA
REORDER BY PART NUMBER 6502
POSITION EDGE OF PRINT ON THIS LINE