WATERMAIN EAST

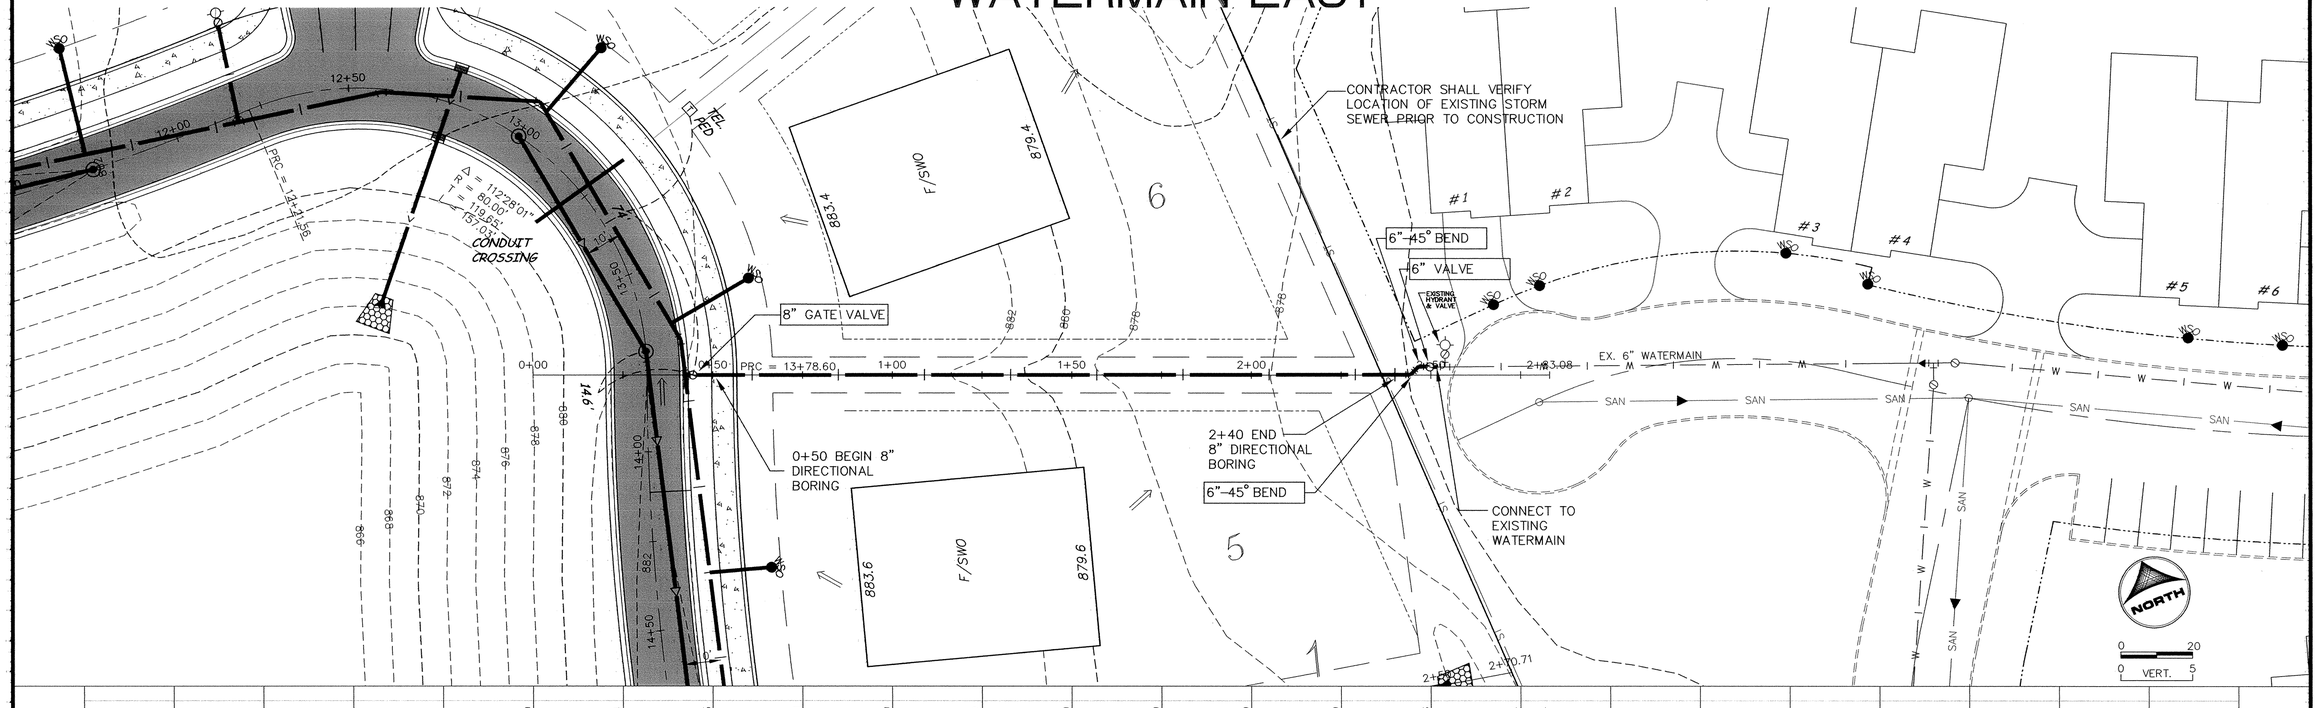

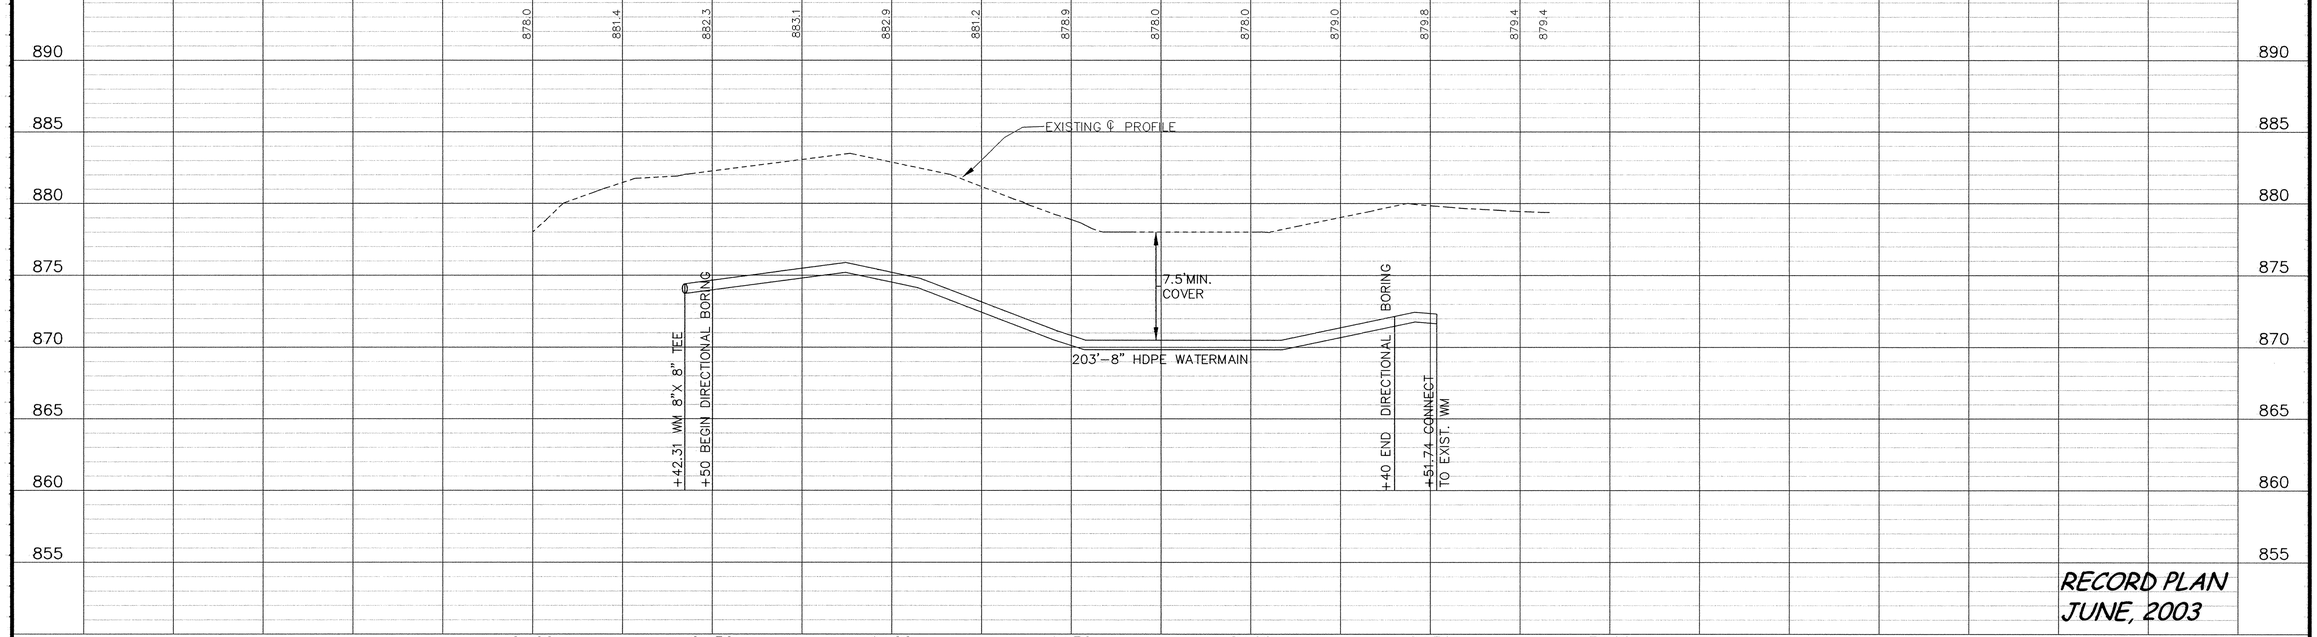

RECORD PLAN
JUNE, 2003

Xrefs: 810641ASBUILT-BASE.DWG

DESIGNED BY: _____ DRAWN BY: LK
APPROVED BY: _____ JOB NUMBER 810641J
CAD DATE: January 20, 2005 2:19:34 p.m.
CAD FILE: 810641J\asbuilts\810641P7A.DWG (JCUNNIN)

I HEREBY CERTIFY THAT THIS PLAN, SPECIFICATION, OR REPORT WAS PREPARED BY ME OR UNDER MY DIRECT SUPERVISION AND THAT I AM A DULY LICENSED PROFESSIONAL ENGINEER UNDER THE LAWS OF THE STATE OF MINNESOTA.

SIGNATURE _____ DATE 2/2/05
PRINTED NAME JOHN M. ANDERSON LIC.NO. 25889

NO.	DATE	BY	REVISION DESCRIPTION

Howard R. Green Company
CONSULTING ENGINEERS
1326 ENERGY PARK DRIVE
ST. PAUL, MINNESOTA 55108
(612) 644-4389

FOX HAVEN
CITY OF ELK RIVER

PLAN AND PROFILE
WATERMAIN EAST
STA. 0+00 TO 2+51.71

SHEET NO.
8

DRAWING NUMBER
8
FOXHA.05

SAPCO PRODUCTS • NEW HOPE, MINNESOTA
REORDER BY PART NUMBER 6560
POSITION SIDE OF PRINT ON THIS LINE