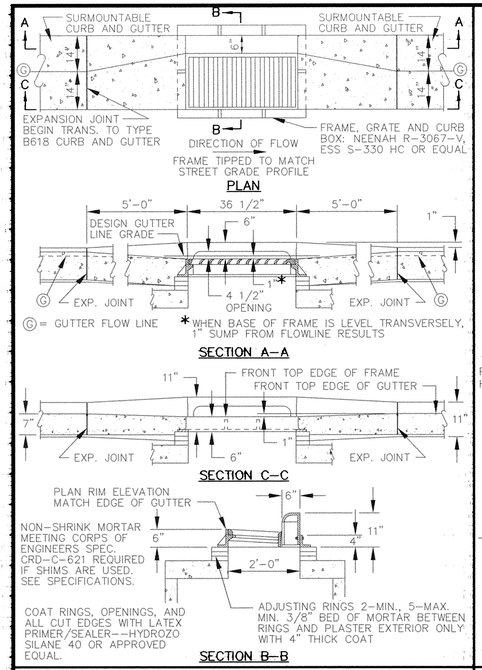

CATCH BASIN FRAME PLACEMENT
SURMOUNTABLE CURB AND GUTTER

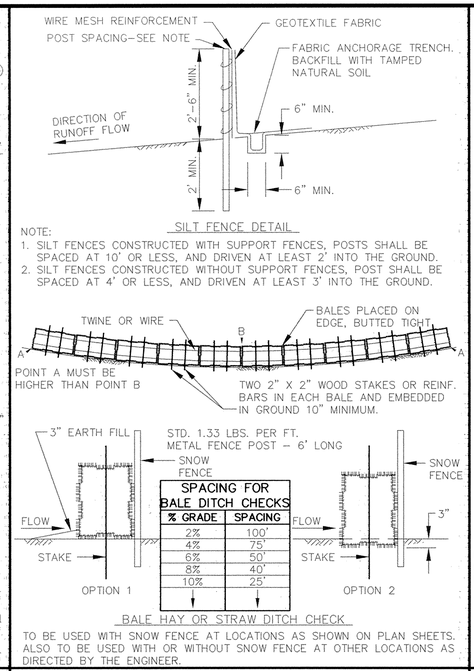

EROSION CONTROL DETAIL

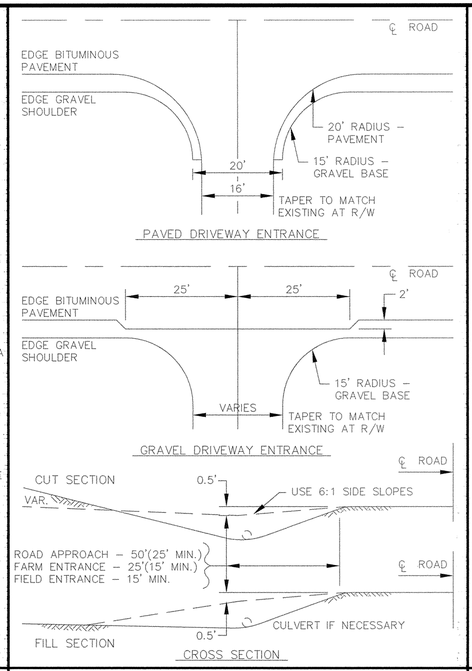

RURAL DRIVEWAY ENTRANCE

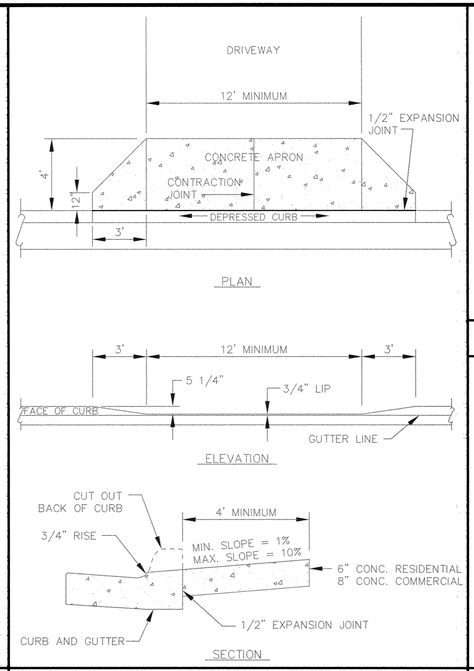

DEPRESSED CURB WITH DRIVEWAY APRON

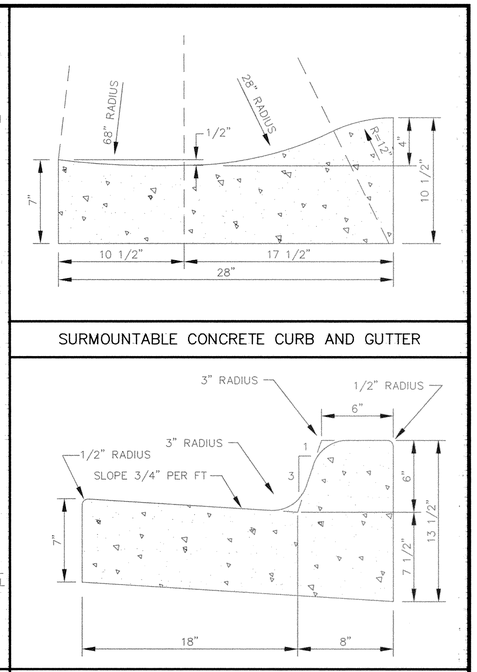

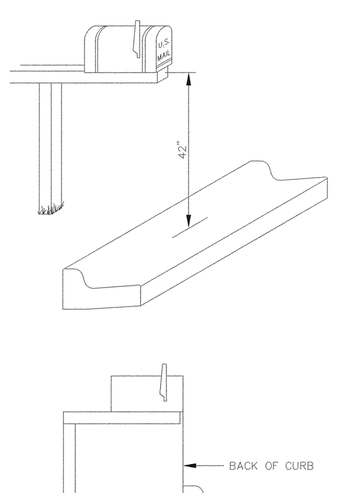

MAIL BOX

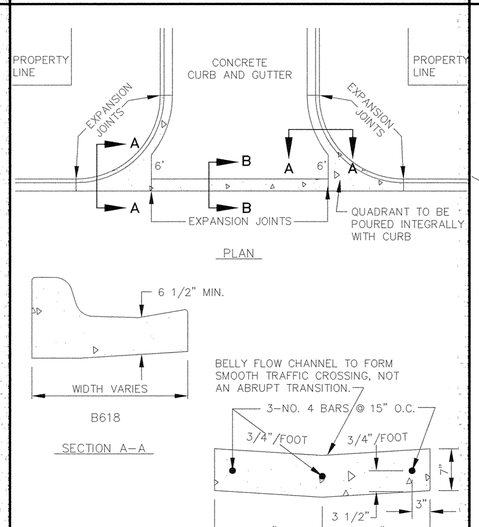

CONCRETE "V" GUTTER

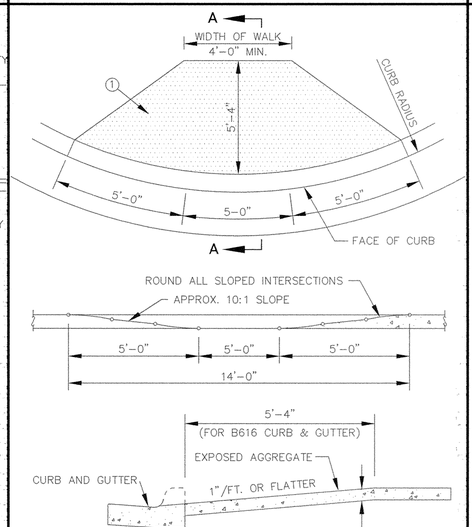

① SURFACE TREATMENT - AFTER NORMAL CONCRETE FINISHING, THE CONCRETE SHALL BE LIGHTLY RINSED TO EXPOSE AGGREGATE. THE EXPOSED AGGREGATE SHALL PROTRUDE AT LEAST 3/16" ABOVE THE CONCRETE SURFACE.

② PEDESTRIAN RAMPS SHALL BE 6" THICK

PEDESTRIAN CURB RAMPS FOR SIDEWALKS

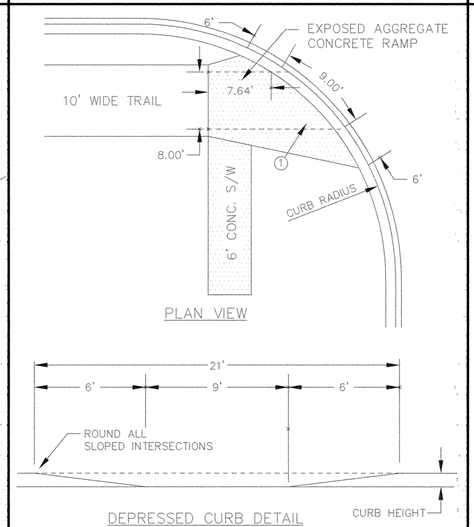

① SURFACE TREATMENT - AFTER NORMAL CONCRETE FINISHING, THE CONCRETE SHALL BE LIGHTLY RINSED TO EXPOSE AGGREGATE. THE EXPOSED AGGREGATE SHALL PROTRUDE AT LEAST 3/16" ABOVE THE CONCRETE SURFACE.

② PEDESTRIAN RAMPS SHALL BE 6" THICK

PEDESTRIAN CURB RAMPS FOR TRAILS

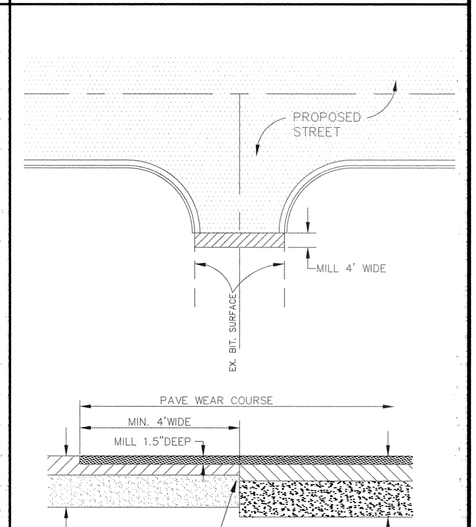

RECORD PLAN
JUNE, 2003

MATCH EXISTING BITUMINUOUS SURFACING

DESIGNED BY: _____ DRAWN BY: LK
APPROVED BY: _____ JOB NUMBER 810641J
CAD DATE: January 24, 2005 2:05:48 p.m.
CAD FILE: 810641J\asbuilts\810641-D3A.DWG (JCUNNIN)

I HEREBY CERTIFY THAT THIS PLAN, SPECIFICATION, OR REPORT WAS PREPARED BY ME OR UNDER MY DIRECT SUPERVISION AND THAT I AM A DULY LICENSED PROFESSIONAL ENGINEER UNDER THE LAWS OF THE STATE OF MINNESOTA.

SIGNATURE _____ DATE _____
PRINTED NAME JOHN M. ANDERSON LIC.NO. 25889

NO.	DATE	BY	REVISION DESCRIPTION

1326 ENERGY PARK DRIVE
ST. PAUL, MINNESOTA 55108
(612) 644-4389
Howard R. Green Company
CONSULTING ENGINEERS

FOX HAVEN

CITY OF ELK RIVER

STREET DETAILS

SHEET NO. D3

DRAWING NUMBER
FOXHA.05
13

SAFCO PRODUCTS • NEW HOPE, MINNESOTA
REORDER BY PART NUMBER 83552
POSITION EDGE OF PRINT ON THIS LINE