Fed. Proj. No.

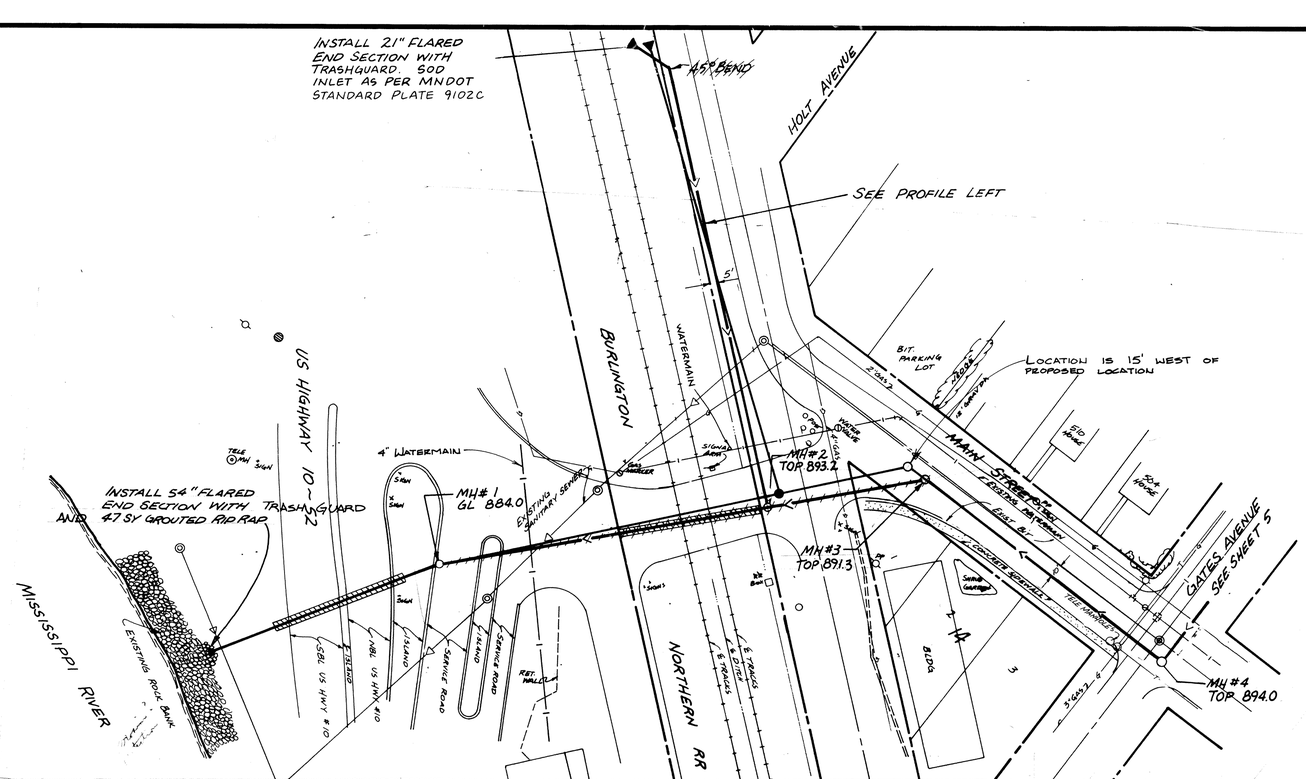

AS-BUILT
DRAWN BY: MRK Date 12-26-84
CHECKED BY:
INSPECTOR TJM Date 2-1-85
DESIGN ENGR. [illegible] Date 2-11-85
PARTY CHIEF [illegible] Date 2-11-85

I hereby certify that this plan, specification or report was prepared by me or under my direct supervision and that I am a duly Registered Professional Engineer under State of Minn Statutes Sections 326.02 to 326.16
Terry J. Maurer
Date 3/1/83 Minn. Reg. No. 15316

consulting engineers diversified inc.
civil municipal planning environmental land surveying geotechnics
p o box | osseo minnesota 55369 • 612/425-2181

REVISIONS

GRAPHIC SCALE
HORIZ 50'
VERT 5'

DESIGNED BY TJM
CHECKED BY TJM
DRAWN BY MRJ

CITY OF ELK RIVER
RIVER TO GATES AVENUE
PHASE 1
STORM SEWER

BK LOOSE PG LEAF | DATE DEC. 1982 | SHEET 4 OF 27 SHEETS | FILE NO. ER302.02

State Proj. No. 204-124-01

Sheet No. of Sheets

93

DRAWING NUMBER

DRAWING NUMBER
GATES 83
4