Fed. Proj. No.

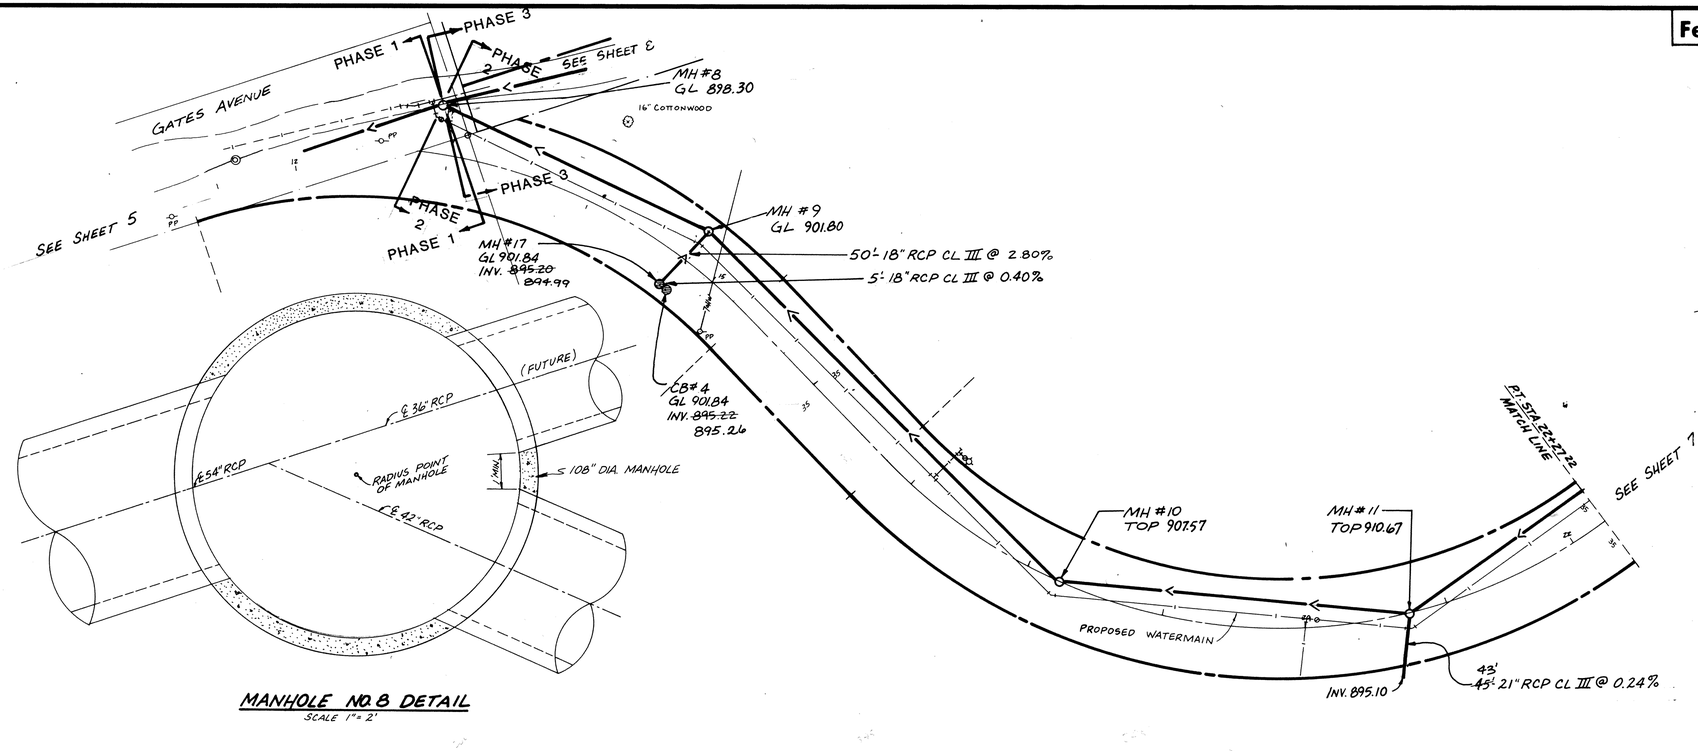

MANHOLE NO. 8 DETAIL

SCALE 1" = 2'

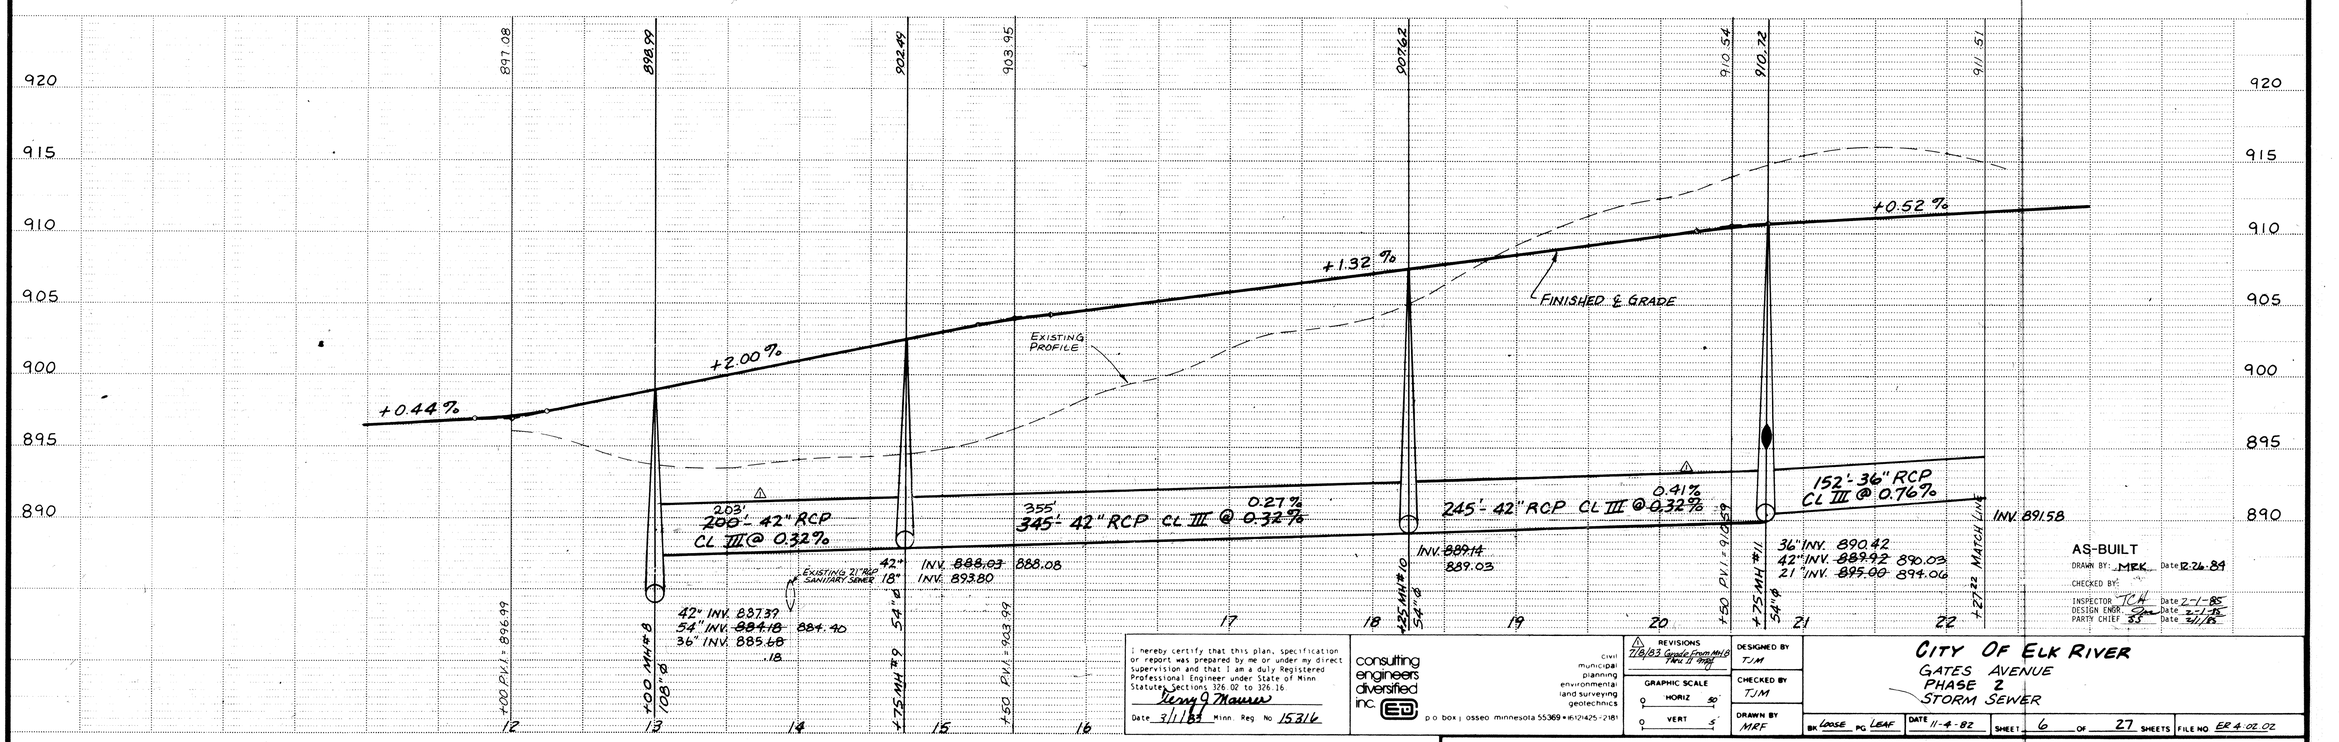

AS-BUILT
DRAWN BY: MRK Date 12-26-89
CHECKED BY:
INSPECTOR JCH Date 2-1-85
DESIGN ENGR Date 2-1-85
PARTY CHIEF Date 2/1/85

I hereby certify that this plan, specification or report was prepared by me or under my direct supervision and that I am a duly Registered Professional Engineer under State of Minn. Statute, Sections 326.02 to 326.16.
Date 3/1/83 Minn. Reg. No. 15316

consulting engineers diversified inc.
civil, municipal, planning, environmental, land surveying, geotechnics
p.o. box | osseo minnesota 55369 • (612)425-2181

REVISIONS
7/6/83 Grade from MH 8 thru 11 mod.

GRAPHIC SCALE
HORIZ 50
VERT 5

DESIGNED BY TJM
CHECKED BY TJM
DRAWN BY MRF

CITY OF ELK RIVER
GATES AVENUE
PHASE 2
STORM SEWER

BK LOOSE PG LEAF | DATE 11-4-82 | SHEET 6 OF 27 SHEETS | FILE NO ER 4-02.02

State Proj. No. 204-124-01

Sheet No. of Sheets

DRAWING NUMBER
SAFCO PRODUCTS • NEW HOPE, MINNESOTA
REORDER BY PART NUMBER 6583

DRAWING NUMBER
GATES 83
6
SAFCO PRODUCTS • NEW HOPE, MINNESOTA
REORDER BY PART NUMBER 6583