


NOTE:
EXISTING POND TO BE FILLED & COMPACTED IN LIFTS IN ACCORDANCE WITH SPECIFICATIONS

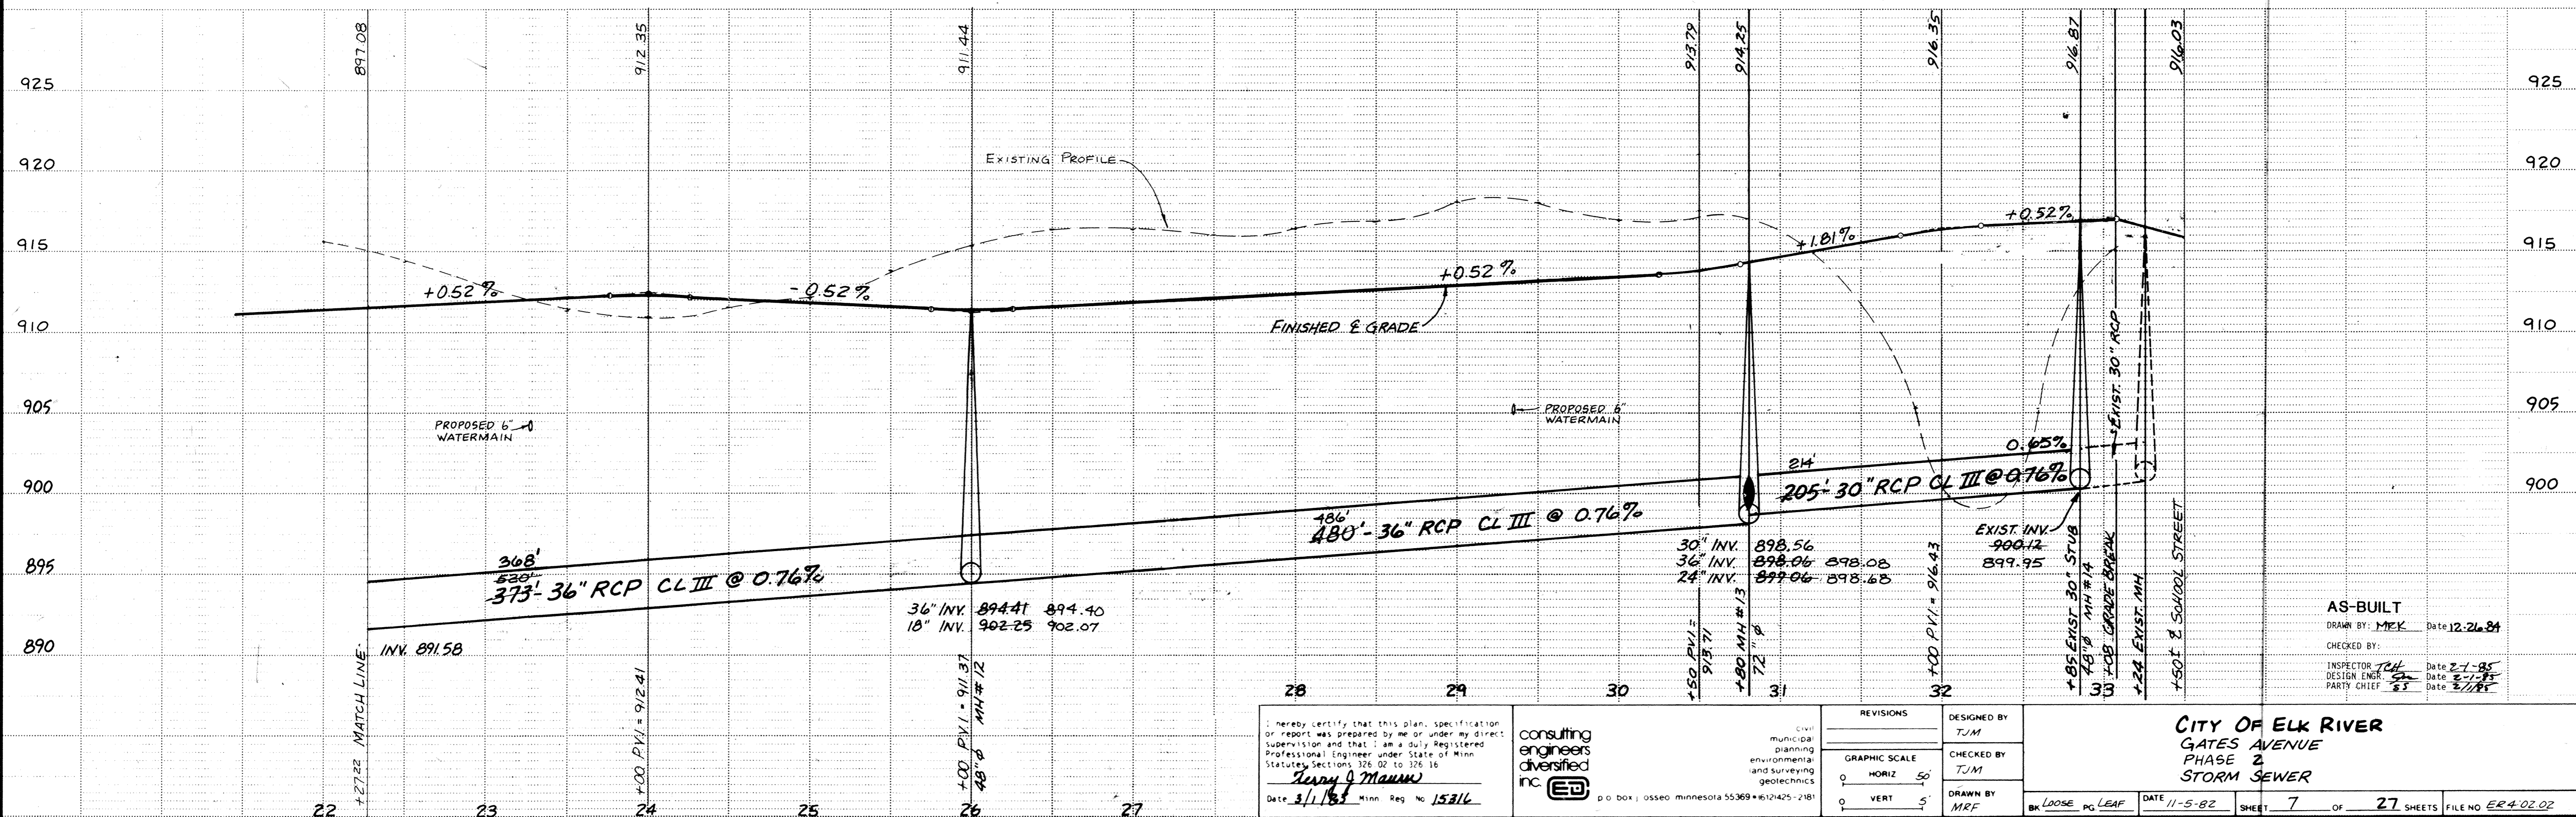

I hereby certify that this plan, specification or report was prepared by me or under my direct supervision and that I am a duly Registered Professional Engineer under State of Minnesota Statute Sections 376.02 to 376.16
LEAHY J. MANN

consulting engineers diversified inc.
civil, municipal, planning, environmental, and surveying geotechnics
p.o. box 1, osseo, minnesota 55369 • 612/425-2181

DESIGNED BY TJM	CHECKED BY TJM
DRAWN BY MRF	

CITY OF ELK RIVER
GATES AVENUE
PHASE 2
STORM SEWER

REVISIONS

GRAPHIC SCALE
0 HORIZ 50'
0 VERT 5'

DATE 11-5-82 SHEET 7 OF 27 SHEETS FILE NO. ER4-02.02