Fed. Proj. No.

6TH STREET & IRVING AVENUE

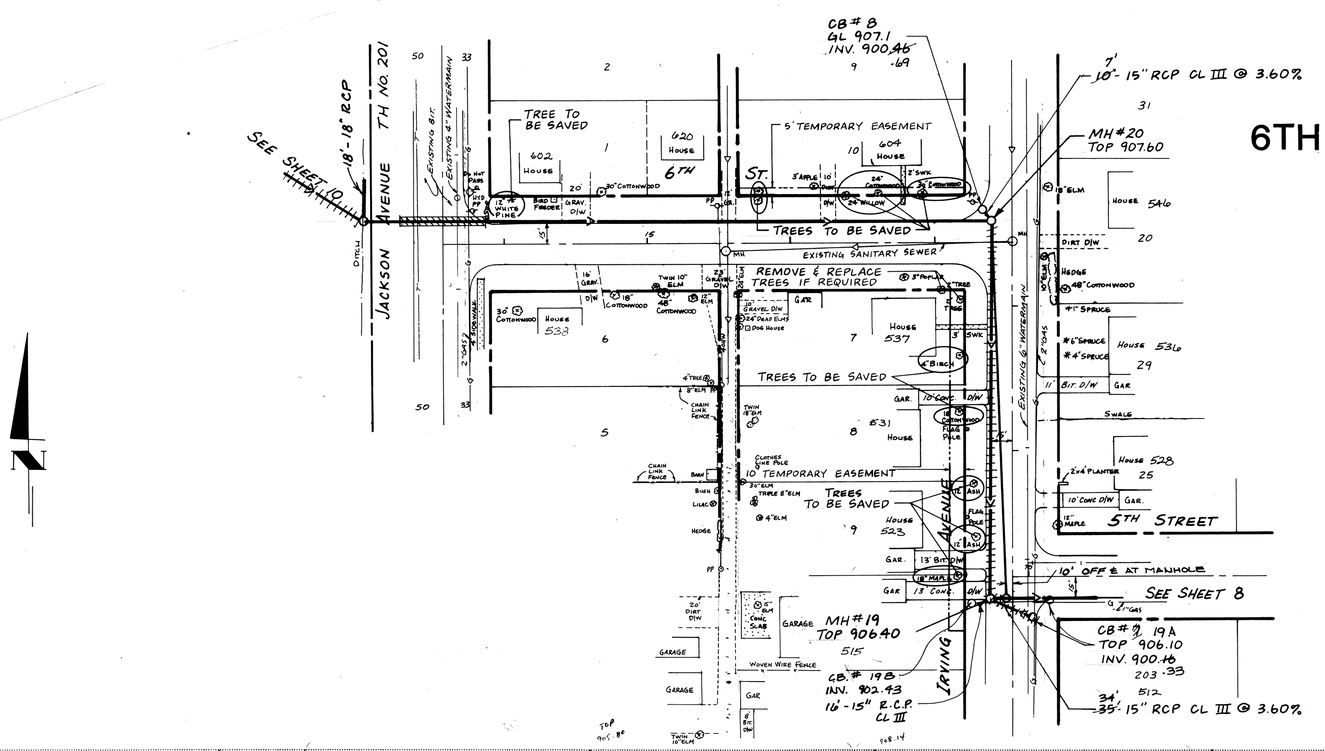

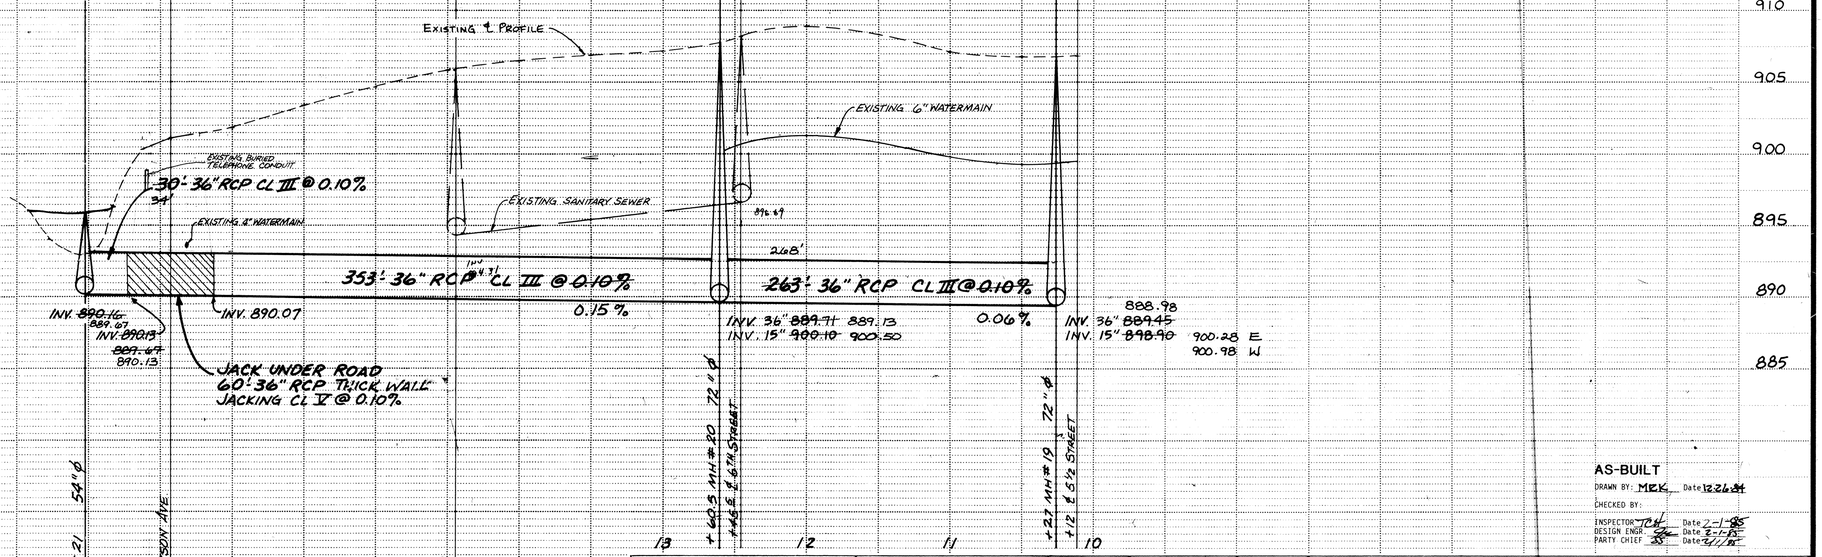

AS-BUILT
DRAWN BY: MEK Date 12-26-84
CHECKED BY:
INSPECTOR TCH Date 2-1-85
DESIGN ENGR. TJM Date 2-1-85
PARTY CHIEF JS Date 2-11-85

I hereby certify that this plan, specification or report was prepared by me or under my direct supervision and that I am a duly Registered Professional Engineer under State of Minn. Statutes, Sections 326.02 to 326.16.
Terry J. Mauss
Date 3/1/85 Minn. Reg. No 15316

consulting engineers diversified inc.
civil municipal planning environmental land surveying geotechnics
p.o. box j osseo minnesota 55369 • 6121425-2181

REVISIONS

GRAPHIC SCALE HORIZ 50' VERT 5'

DESIGNED BY TJM
CHECKED BY TJM
DRAWN BY MRF

CITY OF ELK RIVER
6TH STREET & IRVING AVENUE
PHASE 3
STORM SEWER

BK LOOSE PG LEAF | DATE 11-3-82 | SHEET 9 OF 27 SHEETS | FILE NO ER4-02.02

State Proj. No. | Sheet No. of Sheets

88

DRAWING NUMBER
SAFCO PRODUCTS • NEW HOPE, MINNESOTA
REORDER BY PART NUMBER 6550

DRAWING NUMBER
SAFCO PRODUCTS • NEW HOPE, MINNESOTA
REORDER BY PART NUMBER 6553

DRAWING NUMBER
SAFCO PRODUCTS • NEW HOPE, MINNESOTA
REORDER BY PART NUMBER 6553

3ATES.83
9