Fed. Proj. No.

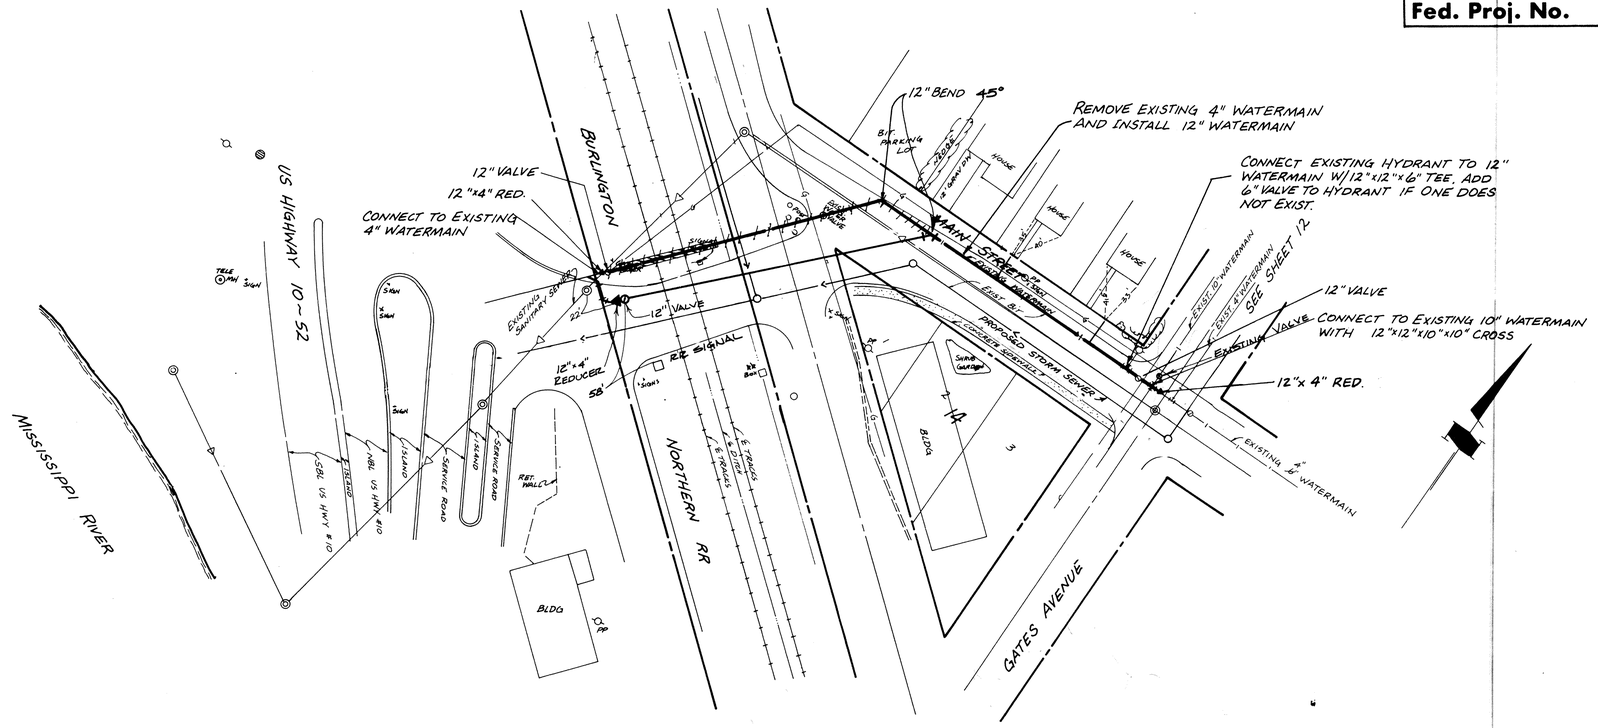

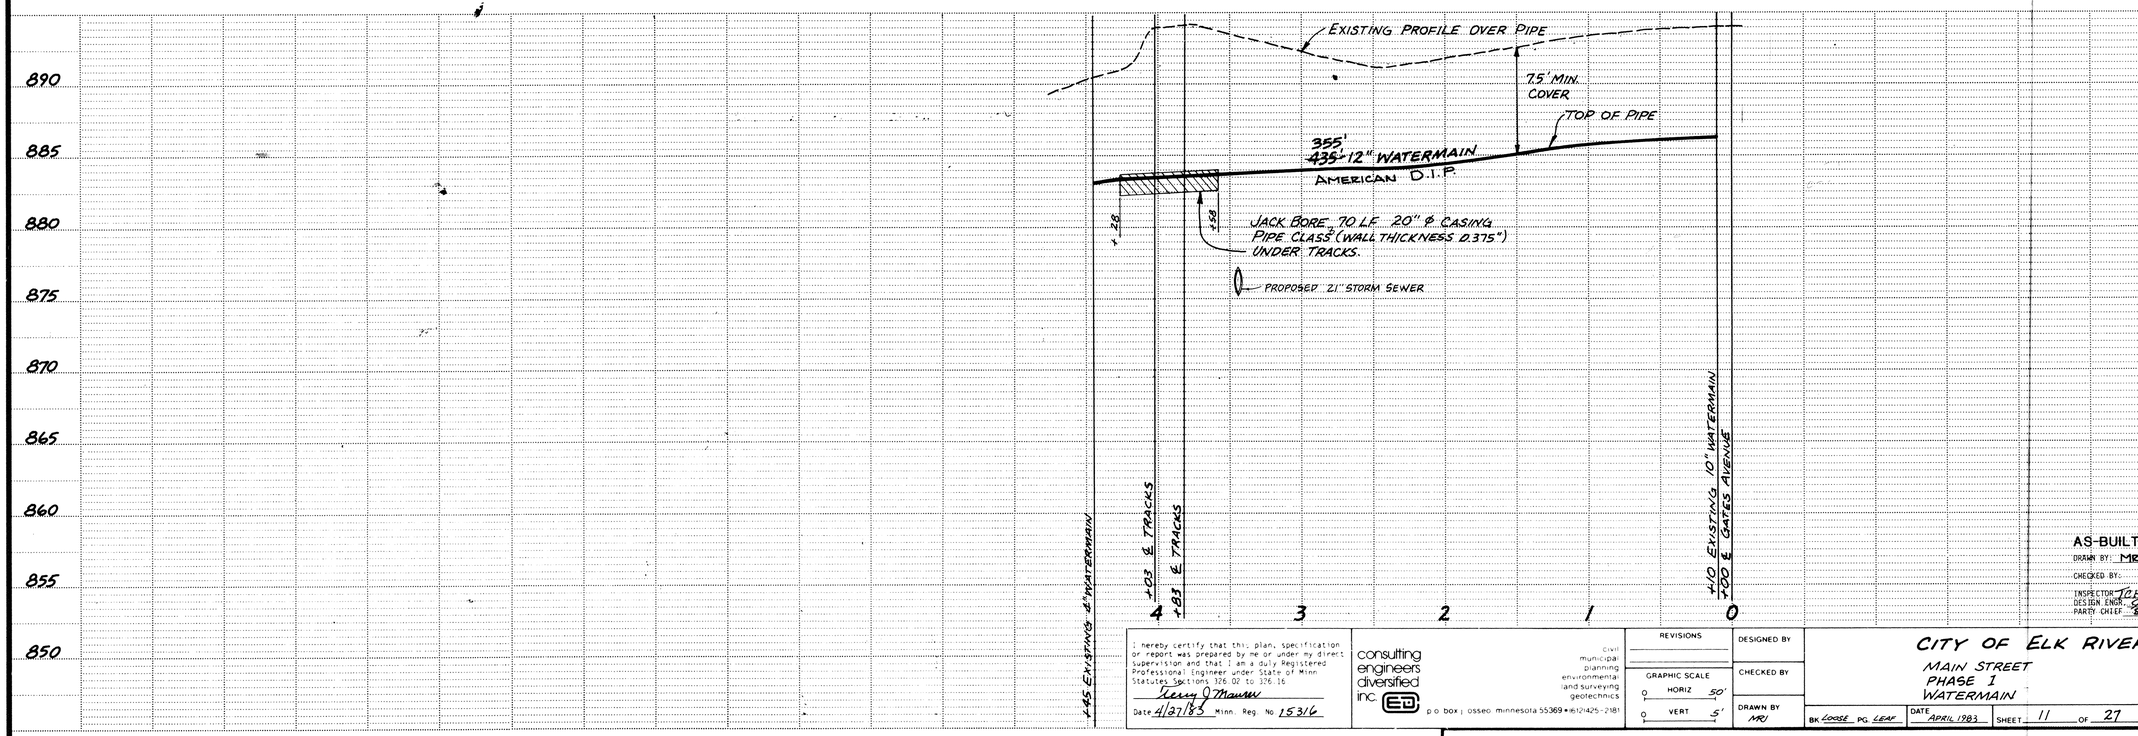

AS-BUILT
DRAWN BY: MRK Date 12-26-84
CHECKED BY:
INSPECTOR TCH Date 2-1-85
DESIGN ENGR. Date 2-1-85
PARTY CHIEF Date 2/1/85

I hereby certify that this plan, specification or report was prepared by me or under my direct supervision and that I am a duly Registered Professional Engineer under State of Minn Statutes Sections 326.02 to 326.16
Terry J. Maurer
Date 4/27/83 Minn. Reg. No. 15316

consulting engineers diversified inc.
civil
municipal
planning
environmental
land surveying
geotechnics
p.o. box j osseo minnesota 55369 • (612) 425-2181

REVISIONS
GRAPHIC SCALE
HORIZ 0 50'
VERT 0 5'
DESIGNED BY
CHECKED BY
DRAWN BY MRJ

CITY OF ELK RIVER
MAIN STREET
PHASE 1
WATERMAIN

BK LOOSE PG. LEAF DATE APRIL 1983 SHEET 11 OF 27 SHEETS FILE NO. ER402.02

State Proj. No. Sheet No. of Sheets

85

DRAWING NUMBER
DRAWING NUMBER
DRAWING NUMBER
DRAWING NUMBER
GATES 83
11