Fed. Proj. No.

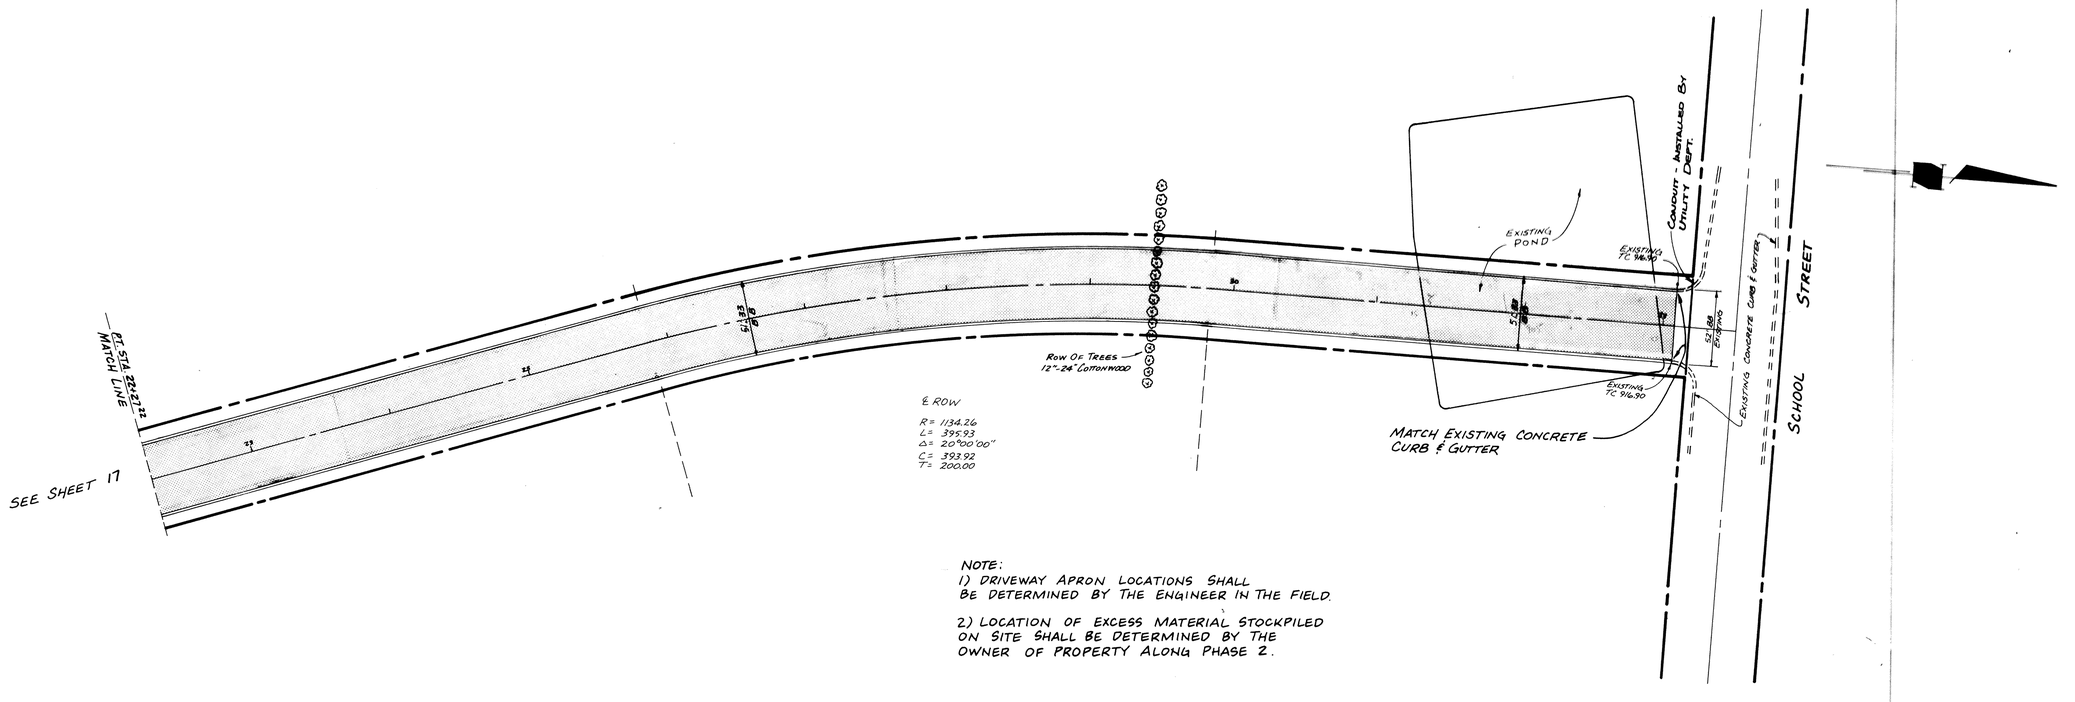

NOTE:
1) DRIVEWAY APRON LOCATIONS SHALL BE DETERMINED BY THE ENGINEER IN THE FIELD.

2) LOCATION OF EXCESS MATERIAL STOCKPILED ON SITE SHALL BE DETERMINED BY THE OWNER OF PROPERTY ALONG PHASE 2.

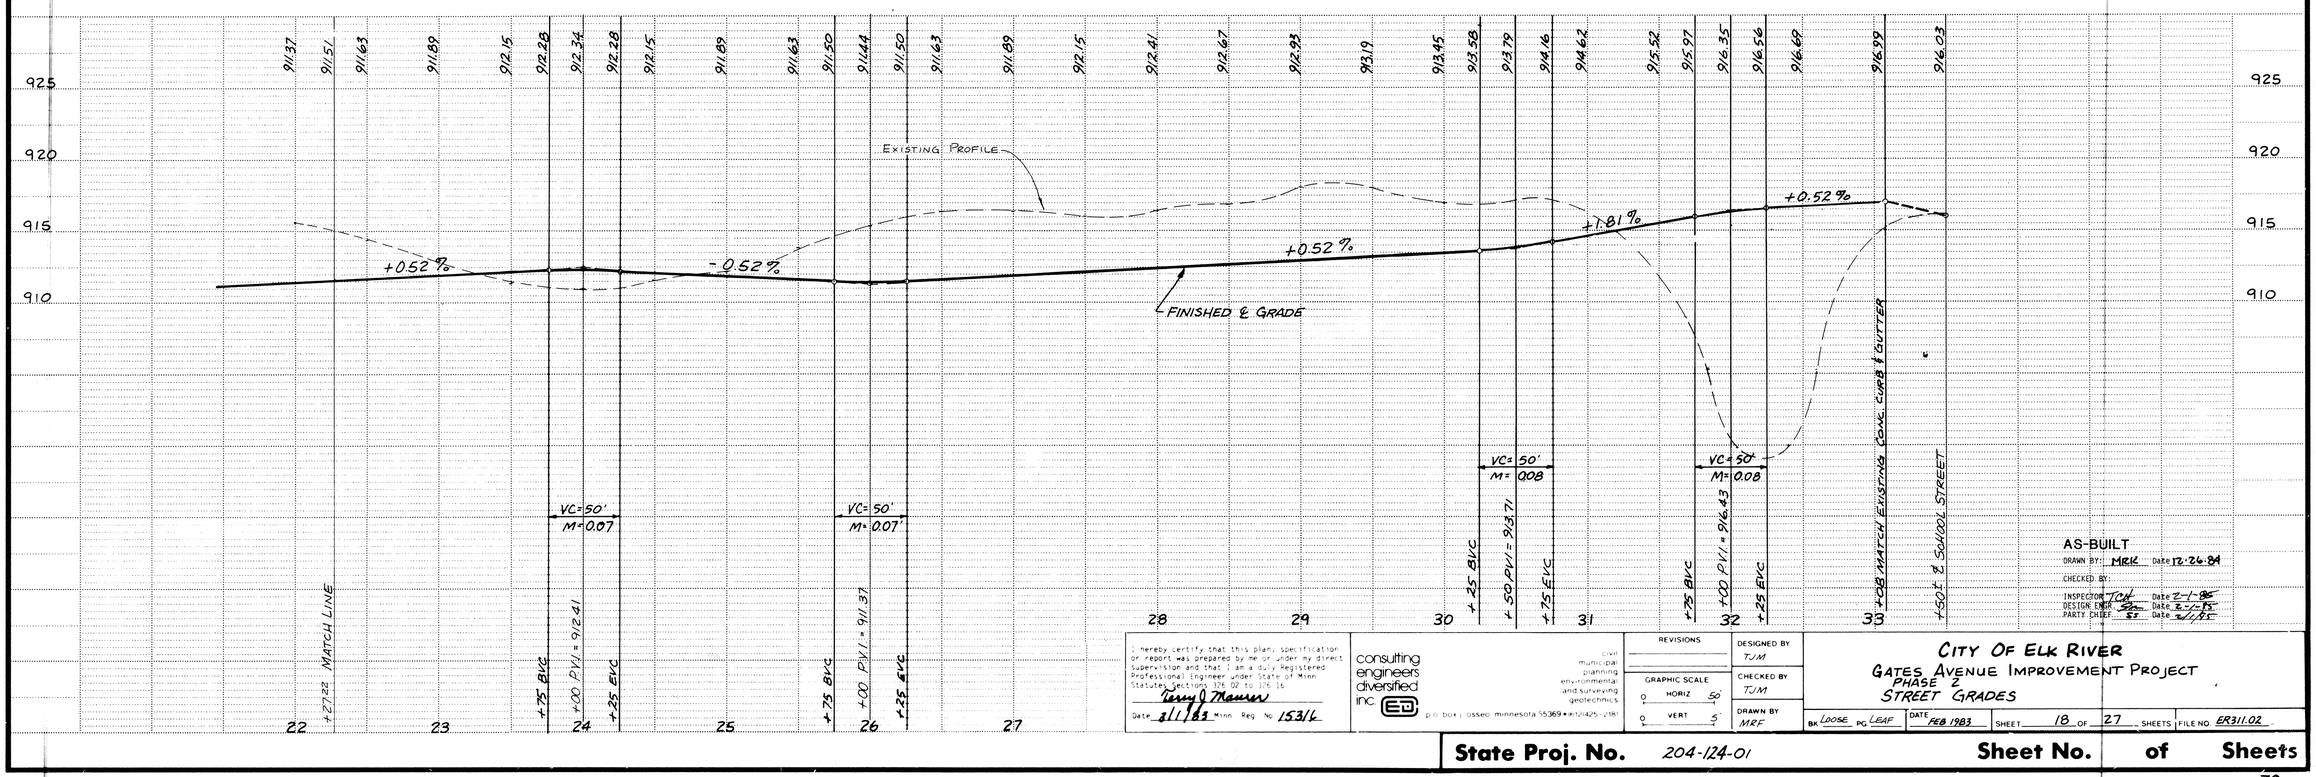

AS-BUILT
DRAWN BY: MRK Date 12-26-84
CHECKED BY:
INSPECTOR TCH Date 2-1-85
DESIGN ENGR SM Date 2-1-85
PARTY CHIEF SB Date 2/1/85

I hereby certify that this plan, specification or report was prepared by me or under my direct supervision and that I am a duly Registered Professional Engineer under State of Minn. Statutes Section 326.02 to 326.16
Terry J. Maurer
Date 3/1/83 Minn. Reg. No. 15316

consulting engineers diversified inc
civil municipal planning environmental and surveying geotechnics
p.o. box | osseo minnesota 55369 • (612)425-2181

REVISIONS

GRAPHIC SCALE
0 HORIZ 50'
0 VERT 5'

DESIGNED BY TJM
CHECKED BY TJM
DRAWN BY MRF

CITY OF ELK RIVER
GATES AVENUE IMPROVEMENT PROJECT
PHASE 2
STREET GRADES

BK LOOSE PG LEAF | DATE FEB 1983 | SHEET 18 OF 27 SHEETS | FILE NO. ER311.02

State Proj. No. 204-124-01

Sheet No. of Sheets

DRAWING NUMBER
GATES.83
18