Fed. Proj. No.

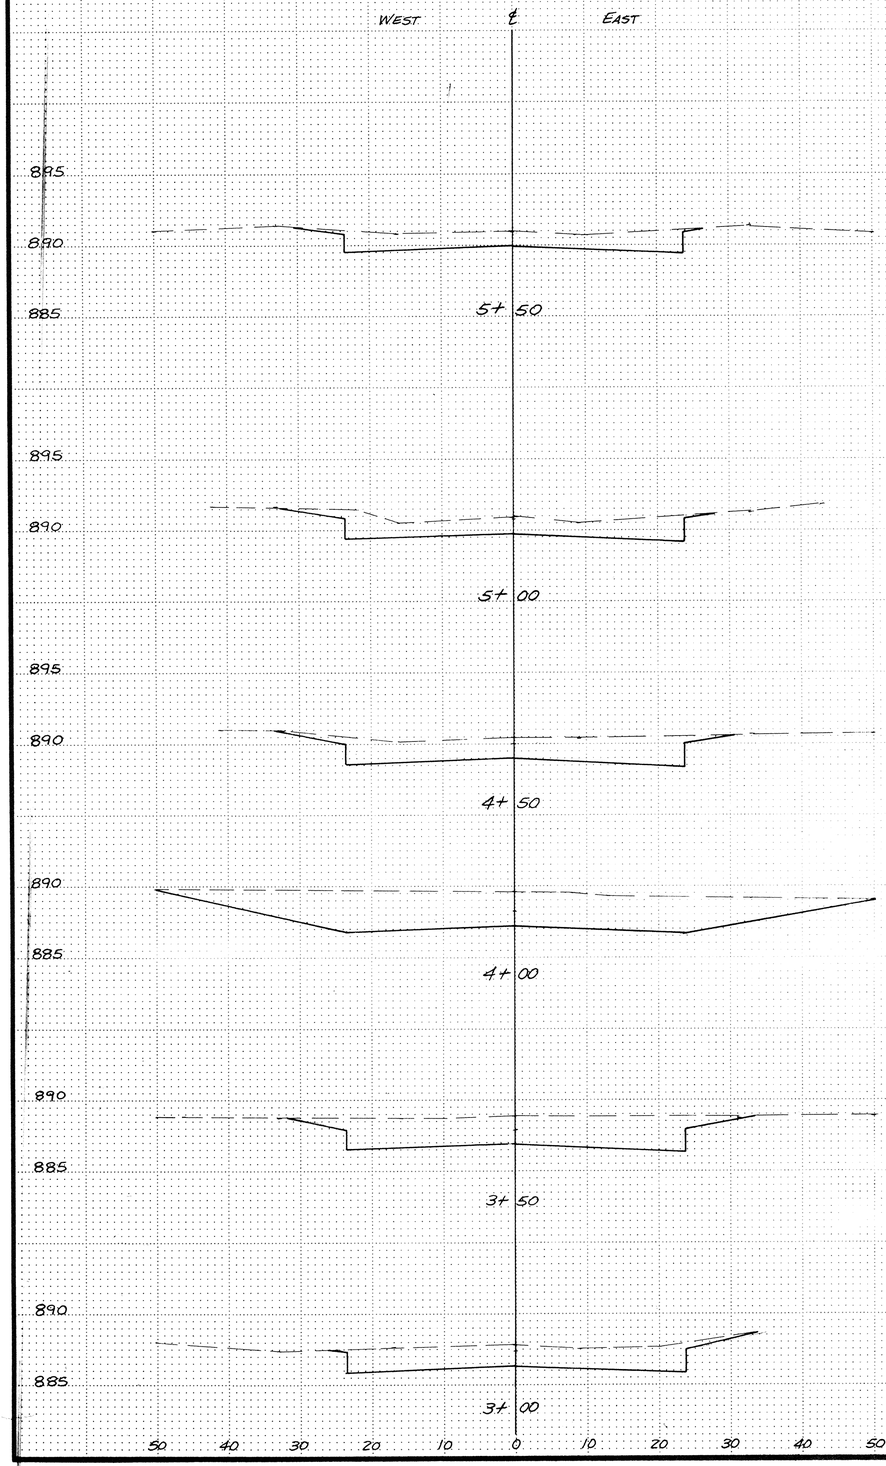

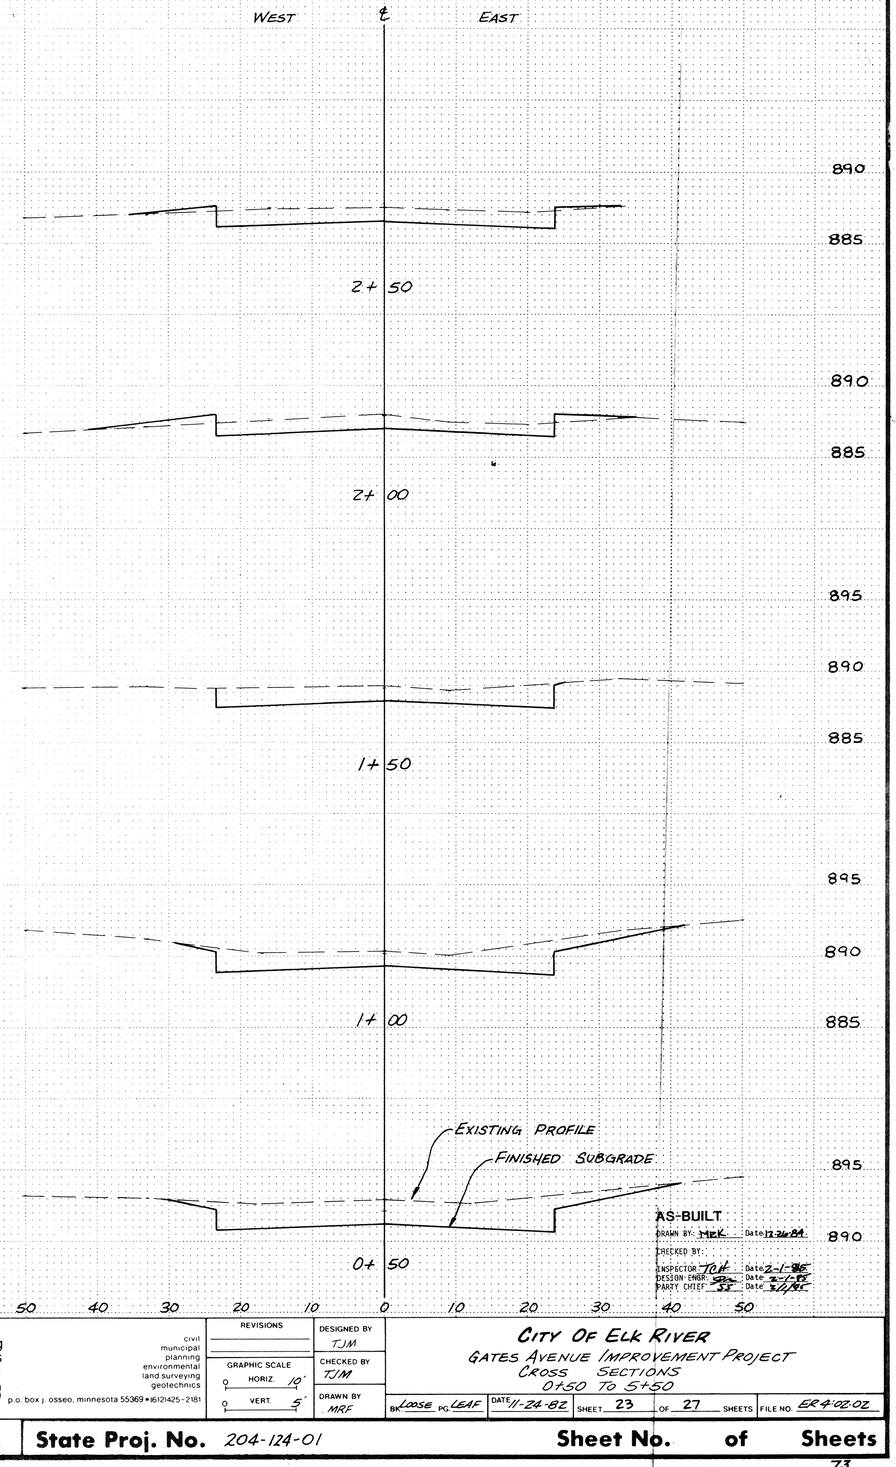

AS-BUILT
DRAWN BY: MEK Date 12-26-84
CHECKED BY:
INSPECTOR TJM Date 2-1-85
DESIGN ENGR. Date
PARTY CHIEF Date

I hereby certify that this plan, specification or report was prepared by me or under my direct supervision and that I am a duly Registered Professional Engineer under State of Minn. Statutes Sections 326.02 to 326.16.
Terry J. Maurer
Date 2/1/85 Minn. Reg. No. 15316

consulting engineers diversified inc.
civil municipal planning environmental land surveying geotechnics
p.o. box j. osseo, minnesota 55369 • (612)425-2181

REVISIONS

GRAPHIC SCALE
HORIZ. 0 10'
VERT. 0 5'

DESIGNED BY TJM
CHECKED BY TJM
DRAWN BY MRF

CITY OF ELK RIVER
GATES AVENUE IMPROVEMENT PROJECT
CROSS SECTIONS 0+50 TO 5+50

BK LOOSE PG LEAF | DATE 11-24-82 | SHEET 23 OF 27 SHEETS | FILE NO. ER4-02.02

State Proj. No. 204-124-01

Sheet No. of Sheets

73

DRAWING NUMBER
DRAWING NUMBER
DRAWING NUMBER
GATES 83
23