Fed. Proj. No.

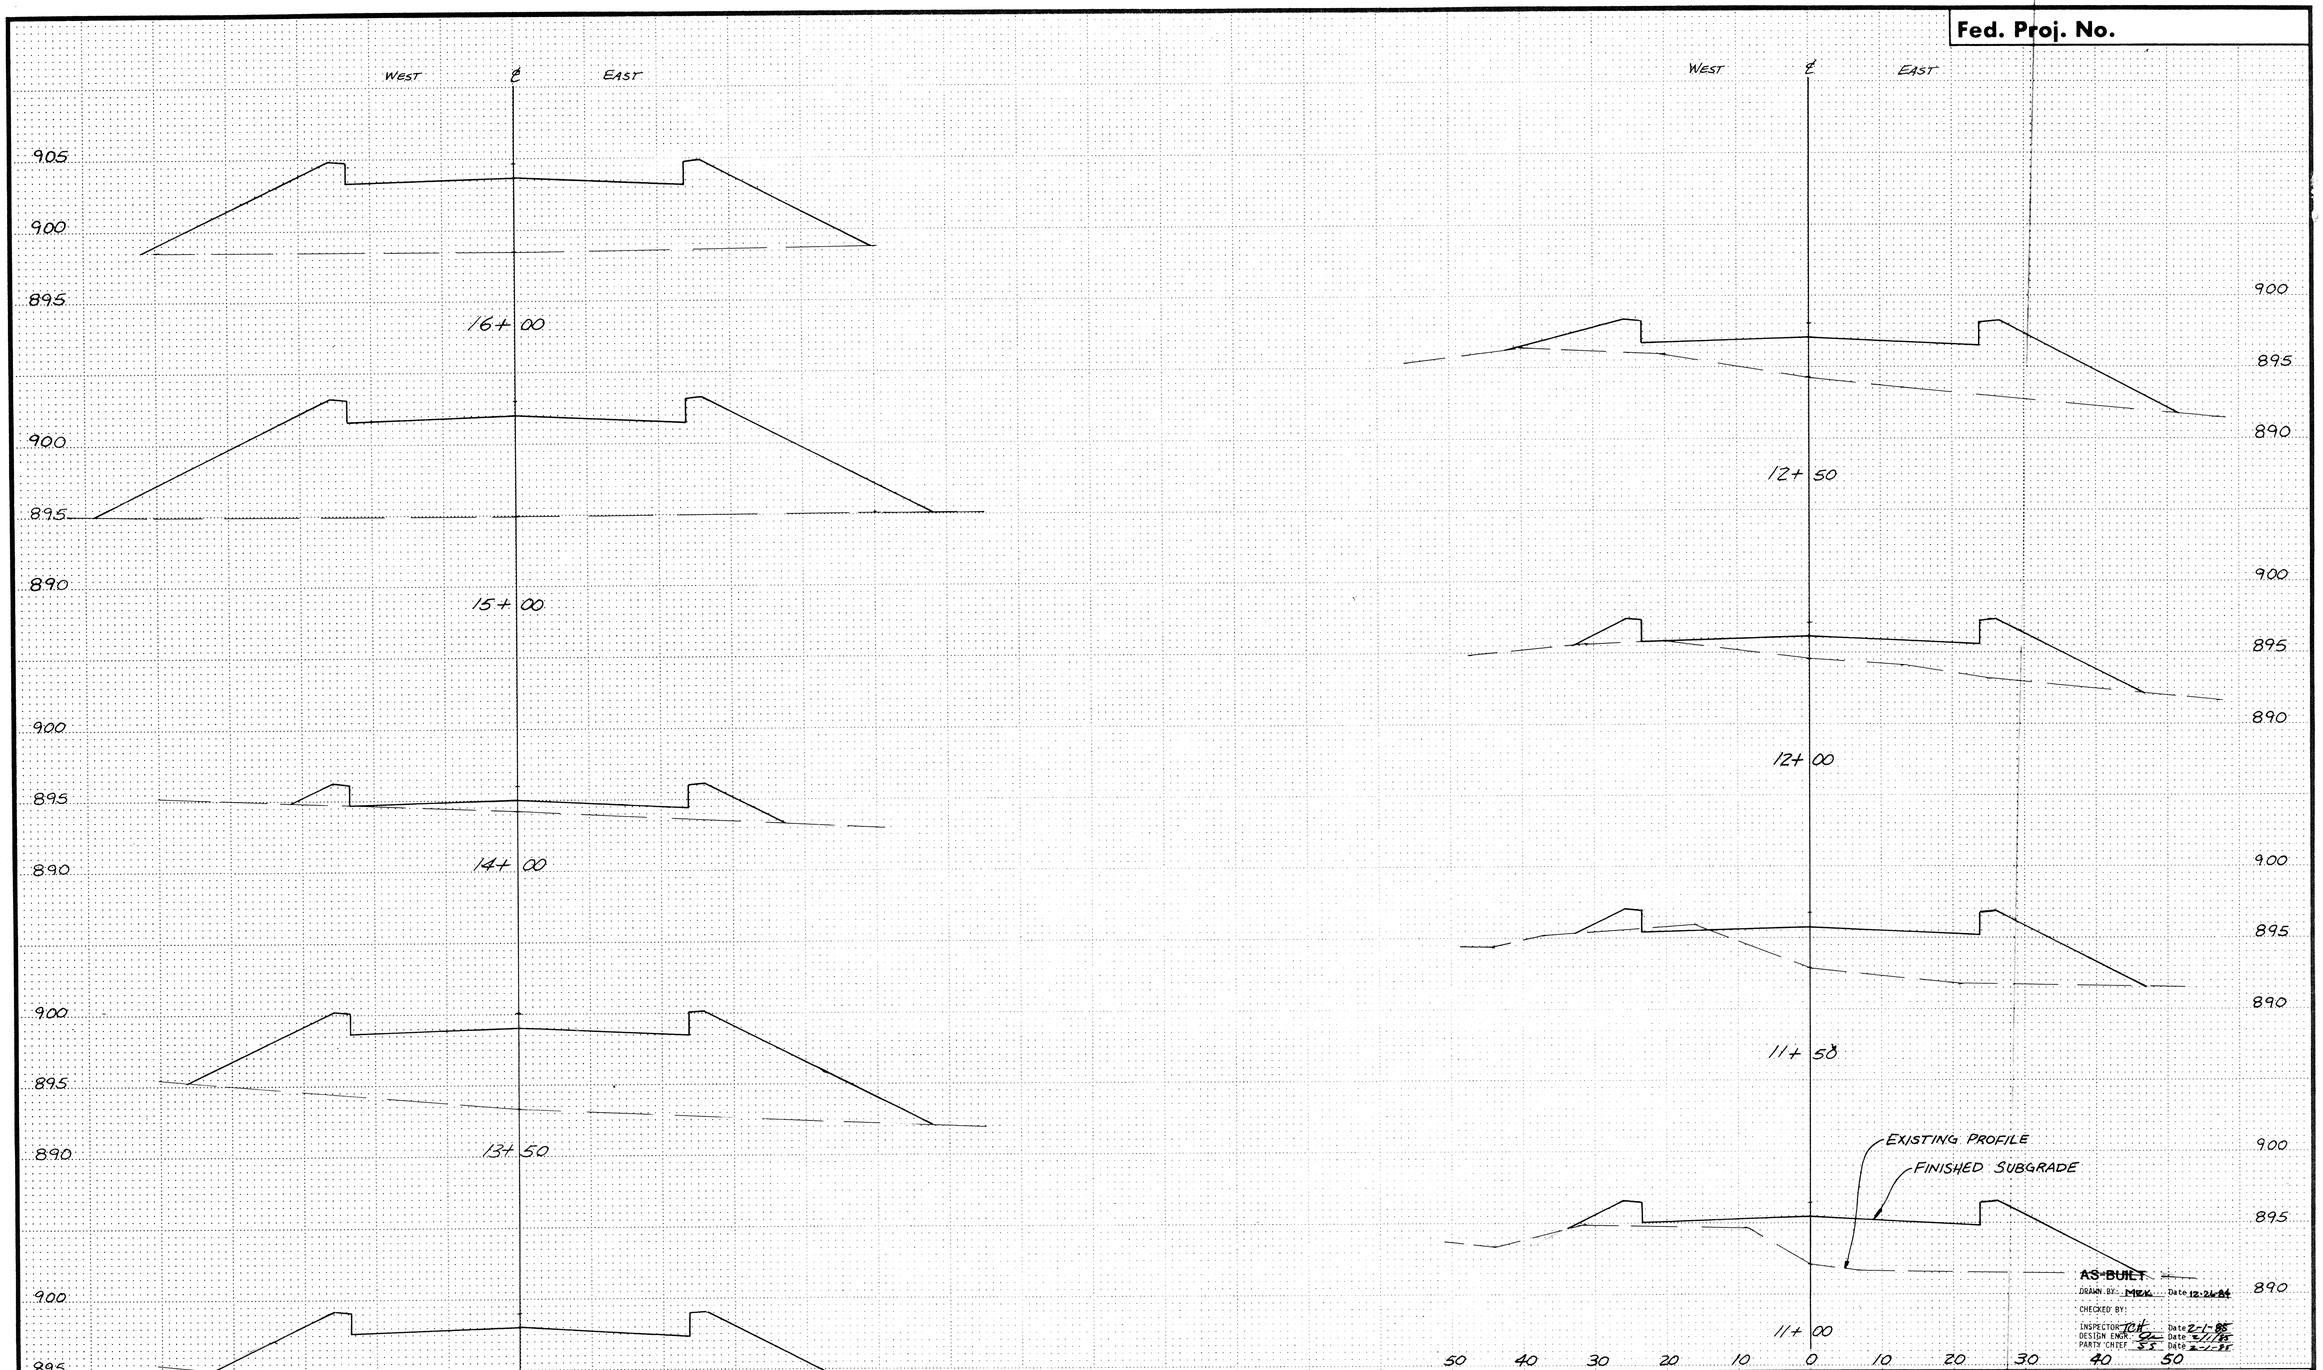


AS-BUILT
DRAWN BY: MRK Date 12-26-84
CHECKED BY:
INSPECTOR: TCH Date 2-1-85
DESIGN ENGR: Date 2/1/85
PARTY CHIEF: SS Date 2-1-85

I hereby certify that this plan, specification or report was prepared by me or under my direct supervision and that I am a duly Registered Professional Engineer under State of Minn. Statutes Sections 326.02 to 326.16.

Terry J. Maurer

Date 3/1/83 Minn. Reg. No. 15814

consulting engineers diversified inc.
civil
municipal
planning
environmental
land surveying
geotechnics
p.o. box j, osseo, minnesota 55369 • (612)425-2181

REVISIONS

GRAPHIC SCALE
HORIZ. 0 10'
VERT. 0 5'

DESIGNED BY TJM
CHECKED BY TJM
DRAWN BY MRF

# CITY OF ELK RIVER
## GATES AVENUE IMPROVEMENT PROJECT
## CROSS SECTIONS
## 11+00 TO 16+00

BK LOOSE PG LEAF | DATE 11-29-82 | SHEET 25 OF 27 SHEETS | FILE NO. ER4-02.02

State Proj. No. 204-124-01 Sheet No. of Sheets

DRAWING NUMBER
GATES.83
25