WEST ROAD

CONSTRUCTION NOTES:

1. TREES SHALL NOT BE CLEARED AND GRUBBED UNLESS MARKED FOR REMOVAL BY THE ENGINEER.
2. THE CONTRACTOR SHALL RESTORE DISTURBED AREAS WITH 4" TOPSOIL AND SOD OR SEED AS DIRECTED BY THE ENGINEER.
3. PROTECT SANITARY SEWER W/2" INSULATION WHEN COVER IS LESS THAN 6 FEET.

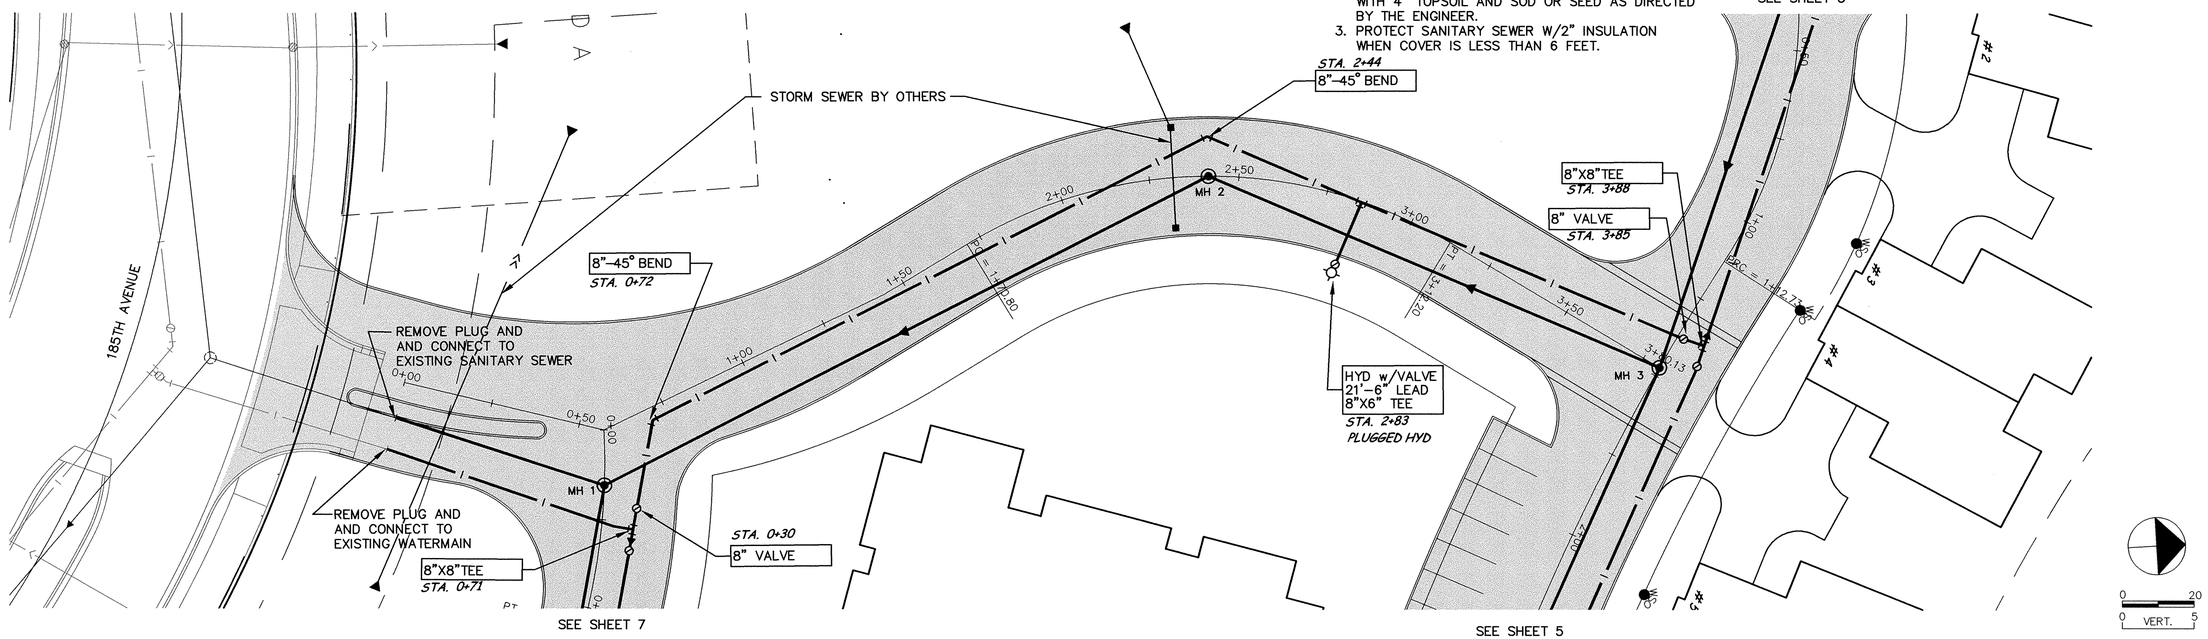

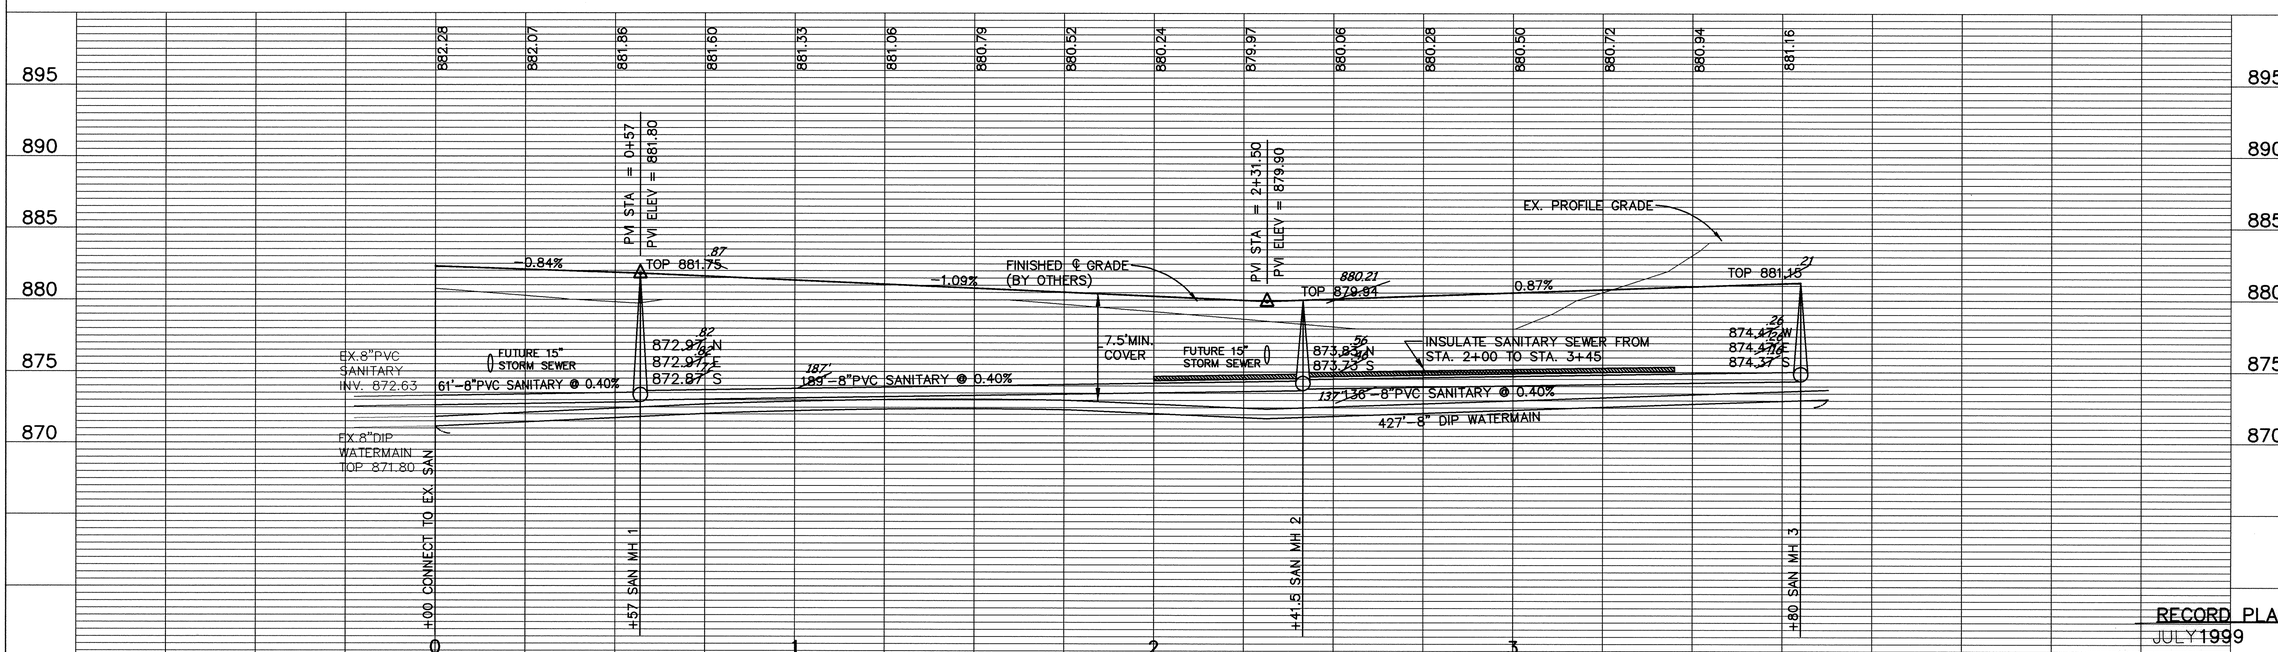

RECORD PLAN
JULY 1999

DESIGNED BY: PB	JOB DATE: MAY 1998		
DRAWN BY: RKM	JOB NUMBER 803691J		
APPROVED: ----	CAD DATE: MAY 1998		
CAD FILE: 803691-1			

I HEREBY CERTIFY THAT THIS PLAN, SPECIFICATION, OR REPORT WAS PREPARED BY ME OR UNDER MY DIRECT SUPERVISION AND THAT I AM A DULY REGISTERED PROFESSIONAL ENGINEER UNDER THE LAWS OF THE STATE OF MINNESOTA.

DATE 6-22-98 REG.NO. 18568

NO.	DATE	BY	REVISION DESCRIPTION
1.	6/22/98		HYDRANT ADDED PER CITY COMMENT

1326 ENERGY PARK DRIVE
ST. PAUL, MINNESOTA 55108
(612) 644-4389

Howard R. Green Company
CONSULTING ENGINEERS

CITY OF ELK RIVER
GUARDIAN ANGELS
UTILITY IMPROVEMENTS

SANITARY SEWER AND WATERMAIN
WEST ROAD
STA. 0+00 TO STA. 3+80.13

SHEET NO. 4 OF 21

1398 P378

DRAWING NUMBER
GUARD.98
4

SAFCO PRODUCTS • NEW HOPE, MINNESOTA
REORDER BY PART NUMBER 60582