T.H. 10

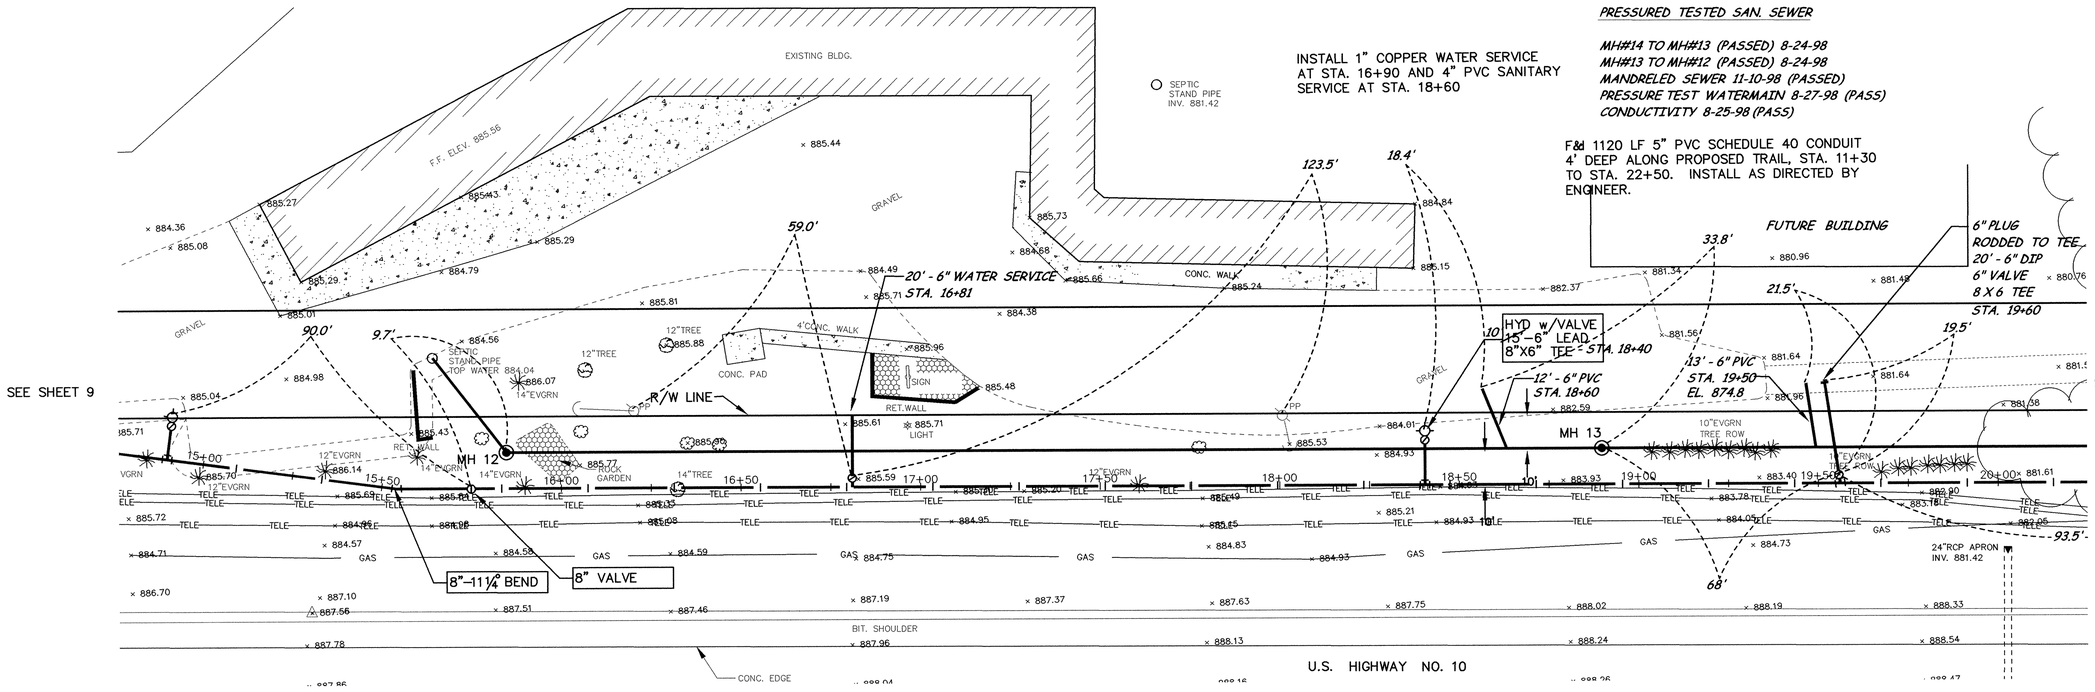

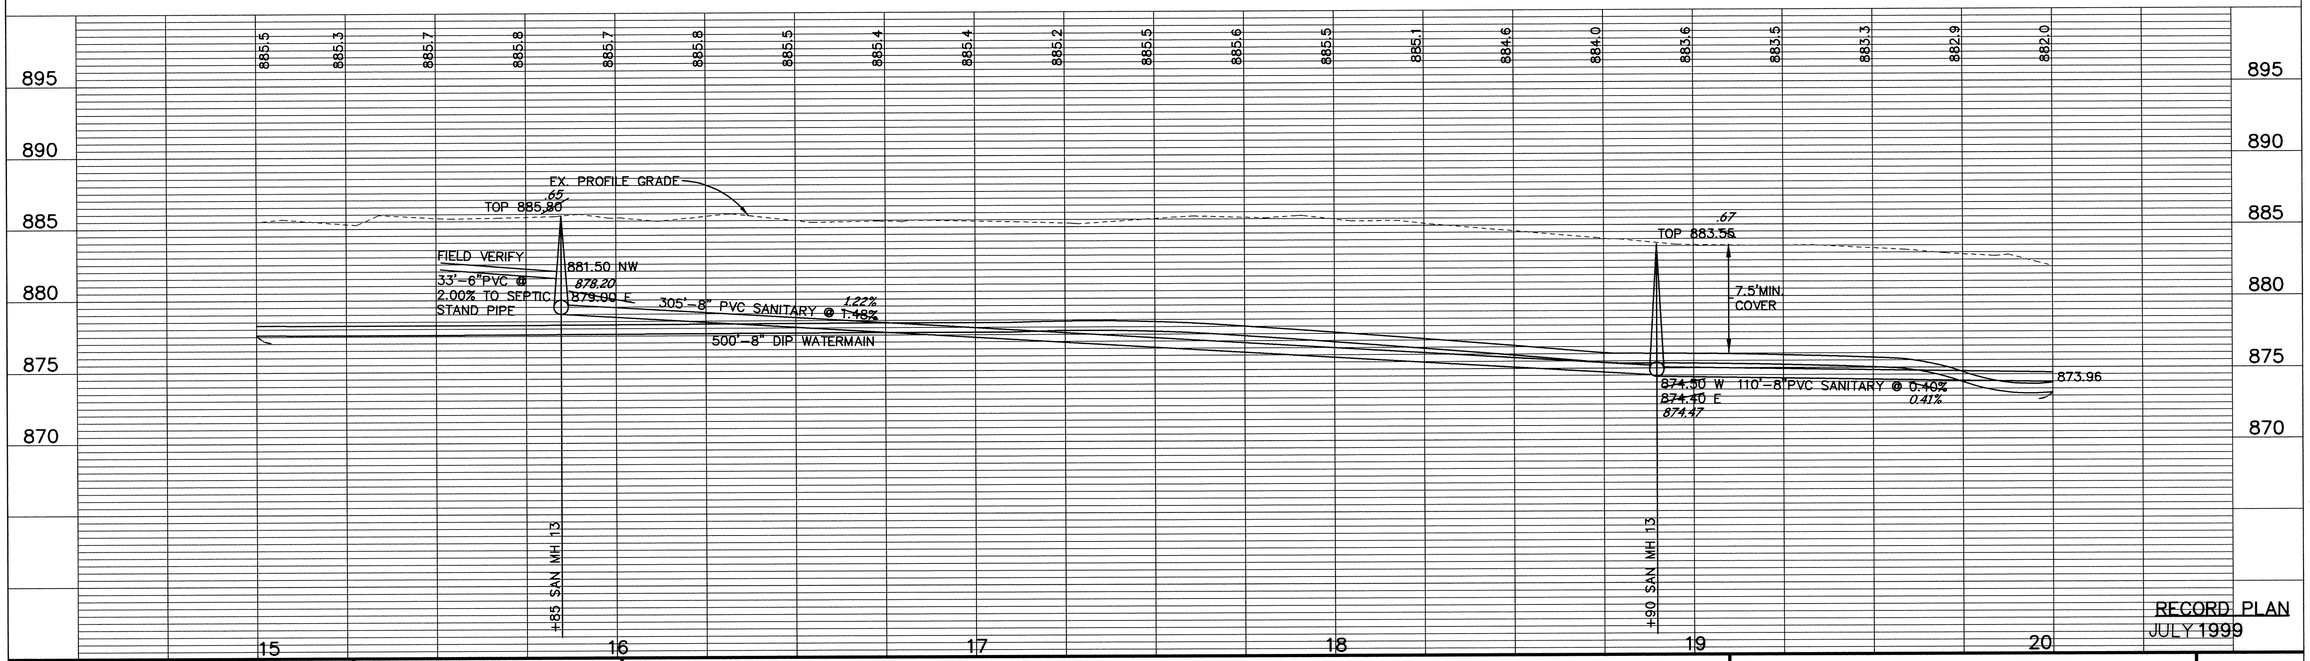

DESIGNED BY:	PB
DRAWN BY:	RKM
APPROVED:	----
CAD FILE:	803691-6
JOB DATE:	MAY 1998
JOB NUMBER	803691J
CAD DATE:	MAY 1998

I HEREBY CERTIFY THAT THIS PLAN, SPECIFICATION, OR REPORT WAS PREPARED BY ME OR UNDER MY DIRECT SUPERVISION AND THAT I AM A DULY REGISTERED PROFESSIONAL ENGINEER UNDER THE LAWS OF THE STATE OF MINNESOTA.
DATE 5-28-98 REG.NO. 18568

NO.	DATE	BY	REVISION DESCRIPTION

1326 ENERGY PARK DRIVE
ST. PAUL, MINNESOTA 55108
(612) 644-4389
Howard R. Green Company
CONSULTING ENGINEERS

CITY OF ELK RIVER
GUARDIAN ANGELS
UTILITY IMPROVEMENTS

SANITARY SEWER AND WATERMAIN
T.H. 10 AT ELK MOTEL
STA. 15+00 TO STA. 20+00

SHEET NO. 10 OF 21

1393

DRAWING NUMBER
SAFCO PRODUCTS • NEW HOPE, MINNESOTA
REORDER BY PART NUMBER 6592
DRAWING NUMBER GUARD 98 10