T.H. 10

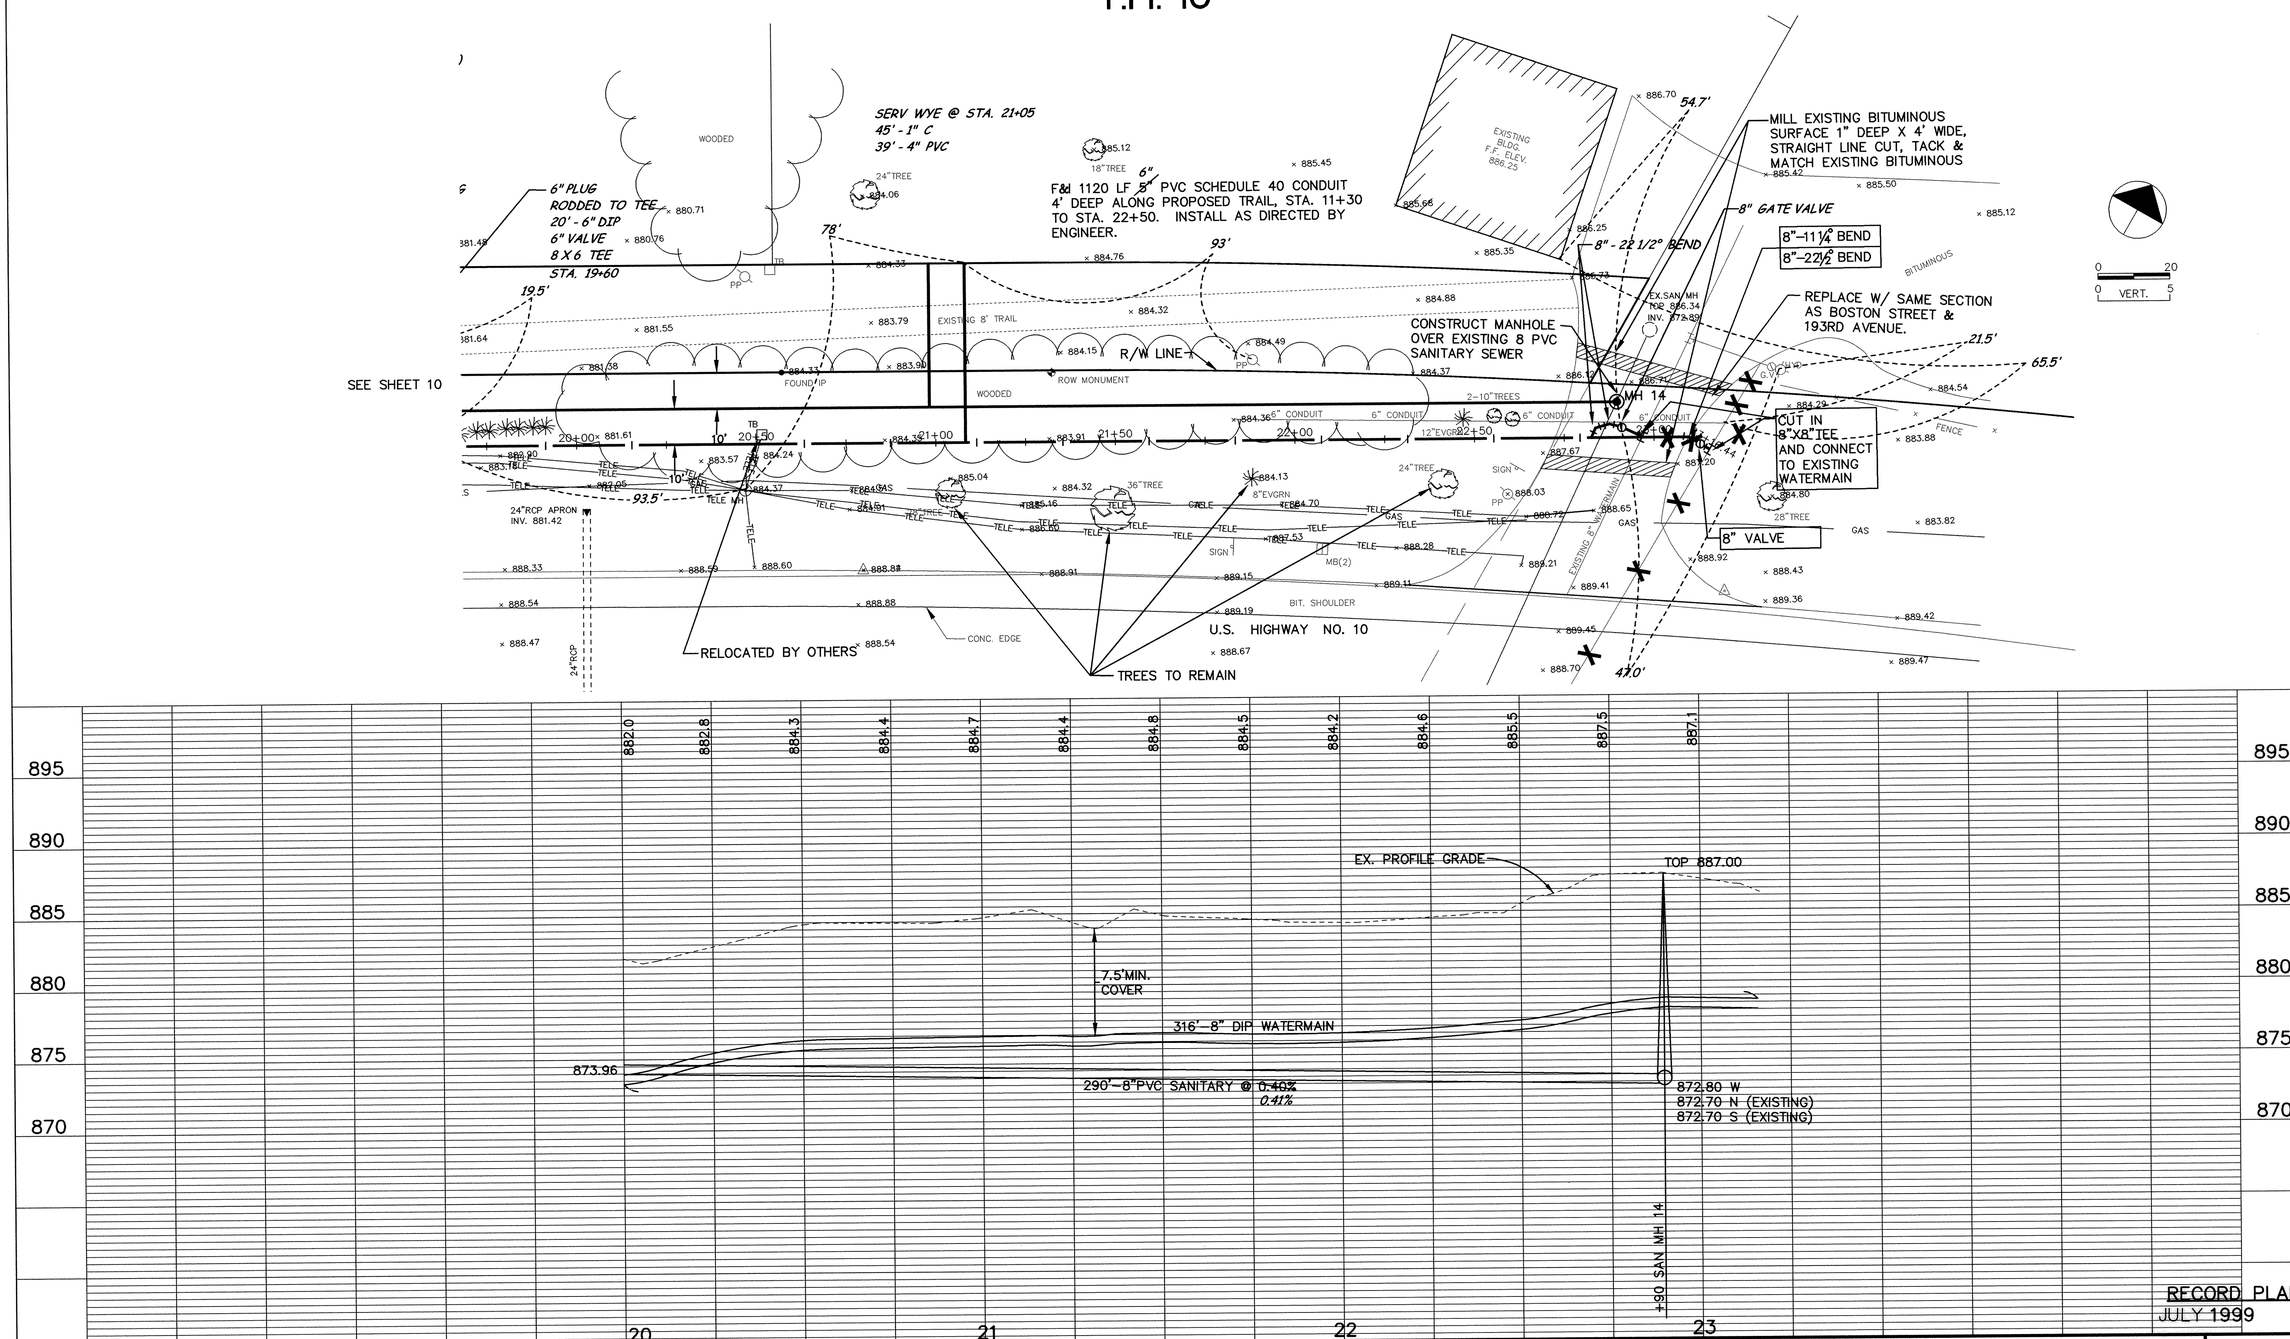

RECORD PLAN
JULY 1999

DESIGNED BY: PB	JOB DATE: MAY 1998		
DRAWN BY: RKM	JOB NUMBER 803691J		
APPROVED: ----	CAD DATE: MAY 1998		
CAD FILE: 803691-7			

I HEREBY CERTIFY THAT THIS PLAN, SPECIFICATION, OR REPORT WAS PREPARED BY ME OR UNDER MY DIRECT SUPERVISION AND THAT I AM A DULY REGISTERED PROFESSIONAL ENGINEER UNDER THE LAWS OF THE STATE OF MINNESOTA.

DATE 5-28-98 REG.NO. 18568

NO.	DATE	BY	REVISION DESCRIPTION

Howard R. Green Company
CONSULTING ENGINEERS
1326 ENERGY PARK DRIVE
ST. PAUL, MINNESOTA 55108
(612) 644-4389

CITY OF ELK RIVER
GUARDIAN ANGELS
UTILITY IMPROVEMENTS

SANITARY SEWER AND WATERMAIN
T.H. 10 AT ELK MOTEL
STA. 20+00 TO STA. 23+16.44

SHEET NO. 11 OF 21

1392 ~~1377~~

DRAWING NUMBER
SAFCO PRODUCTS • NEW HOPE, MINNESOTA
REORDER BY PART NUMBER 6552

DRAWING NUMBER
SAFCO PRODUCTS • NEW HOPE, MINNESOTA
REORDER BY PART NUMBER 6552

DRAWING NUMBER
SAFCO PRODUCTS • NEW HOPE, MINNESOTA
REORDER BY PART NUMBER 6552

DRAWING NUMBER
GUARD.98
11
SAFCO PRODUCTS • NEW HOPE, MINNESOTA
REORDER BY PART NUMBER 6552