BOSTON STREET

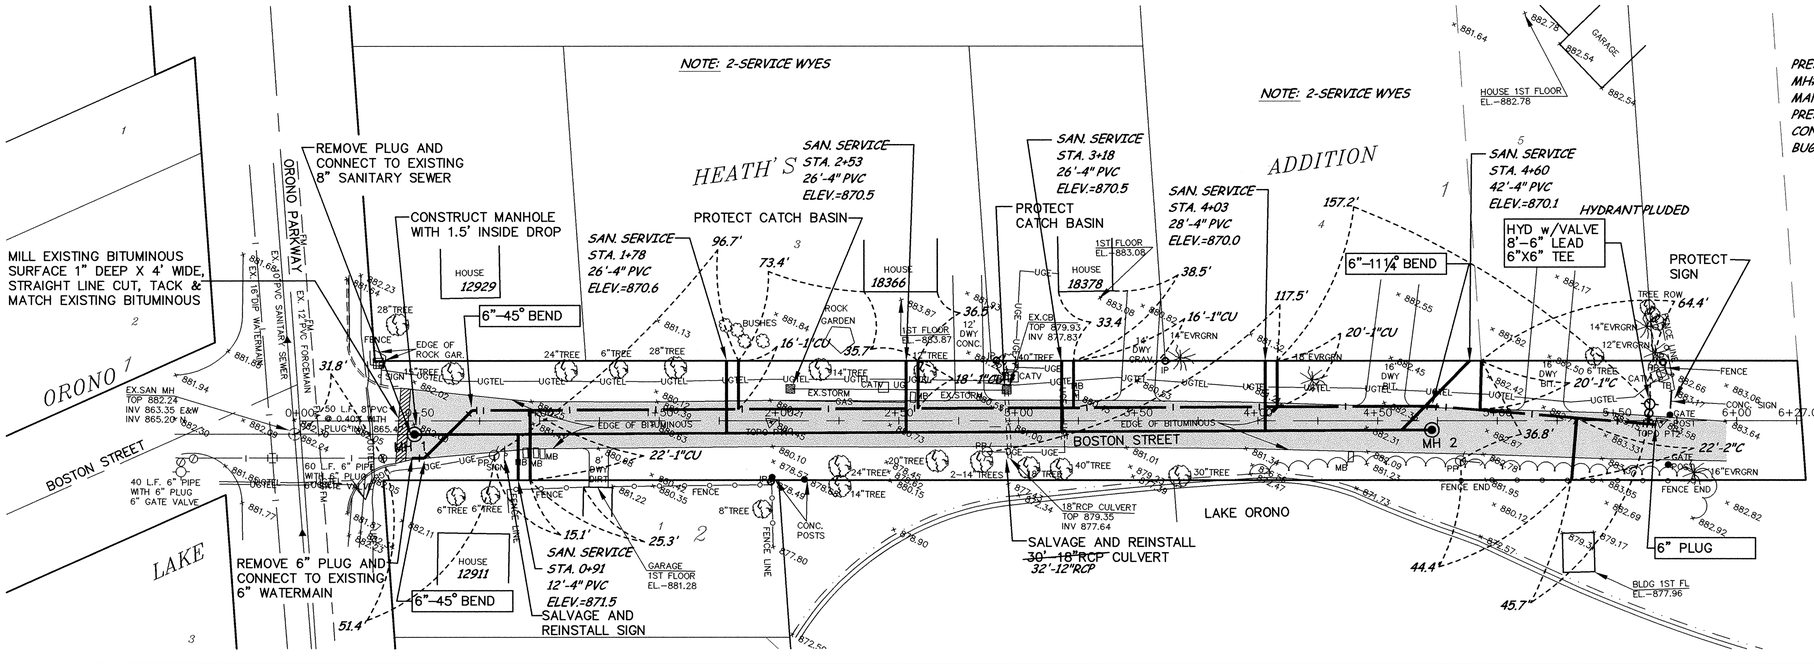

PRESSURE TESTED SAN. SEW 8-24-98 PASSED
MH#1 TO MH#2 PASSED
MANDRELED SEWER 11-10-98 PASSED
PRESSURED TEST WATERMAIN 8-26-98
CONDUCTIVITY 8-25-98 (PASS)
BUG-TEST TAKEN 8-25-98

CONSTRUCTION NOTES

1. TREES SHALL NOT BE CLEARED AND GRUBBED UNLESS MARKED FOR REMOVAL BY THE ENGINEER.
2. THE CONTRACTOR SHALL RESTORE DISTURBED AREAS WITH 4" TOPSOIL AND SOD OR SEED AS DIRECTED BY THE ENGINEER.
3. MAILBOXES SHALL BE RELOCATED AS DIRECTED BY THE ENGINEER. TEMPORARY AND PERMANENT RELOCATION OF MAILBOXES SHALL BE INCIDENTAL.
4. THE ENTIRE WIDTH OF BOSTON STREET SHALL BE REMOVED, AND BOSTON STREET SHALL BE RESTORED TO THE EXISTING WIDTH AND PROFILE.
5. ACCESS TO ALL EXISTING PROPERTIES SHALL BE MAINTAINED. PROPERTY OWNERS SHALL BE NOTIFIED PRIOR TO RESTRICTION OF ACCESS TO DRIVEWAYS FOR ANY PERIOD OF TIME.

GRAPHIC SCALE
0 30
0 VERT. 5

RECORD PLAN
JULY 1999

DRAWN BY: LK JOB DATE: DATE
APPROVED: ____ JOB NUMBER 801210J
CAD DATE: APRIL 1998
CAD FILE: 801210-P1

I HEREBY CERTIFY THAT THIS PLAN, SPECIFICATION, OR REPORT WAS PREPARED BY ME OR UNDER MY DIRECT SUPERVISION AND THAT I AM A DULY REGISTERED PROFESSIONAL ENGINEER UNDER THE LAWS OF THE STATE OF MINNESOTA.
DATE 5-28-98 REG.NO. 18568

NO.	DATE	BY	REVISION DESCRIPTION

Howard R. Green Company
CONSULTING ENGINEERS
1326 ENERGY PARK DRIVE
ST. PAUL, MINNESOTA 55108
(612) 644-4389

CITY OF ELK RIVER
BOSTON STREET
UTILITY IMPROVEMENTS

SANITARY SEWER AND WATERMAIN
BOSTON STREET
0+00 TO 5+63

SHEET NO. 12 OF 21

1391 1300

DRAWING NUMBER
DRAWING NUMBER
DRAWING NUMBER GUARD 98 12

SAFCO PRODUCTS • NEW HOPE, MINNESOTA
REORDER BY PART NUMBER 8552
POSITION EDGE OF PRINT ON THIS LINE