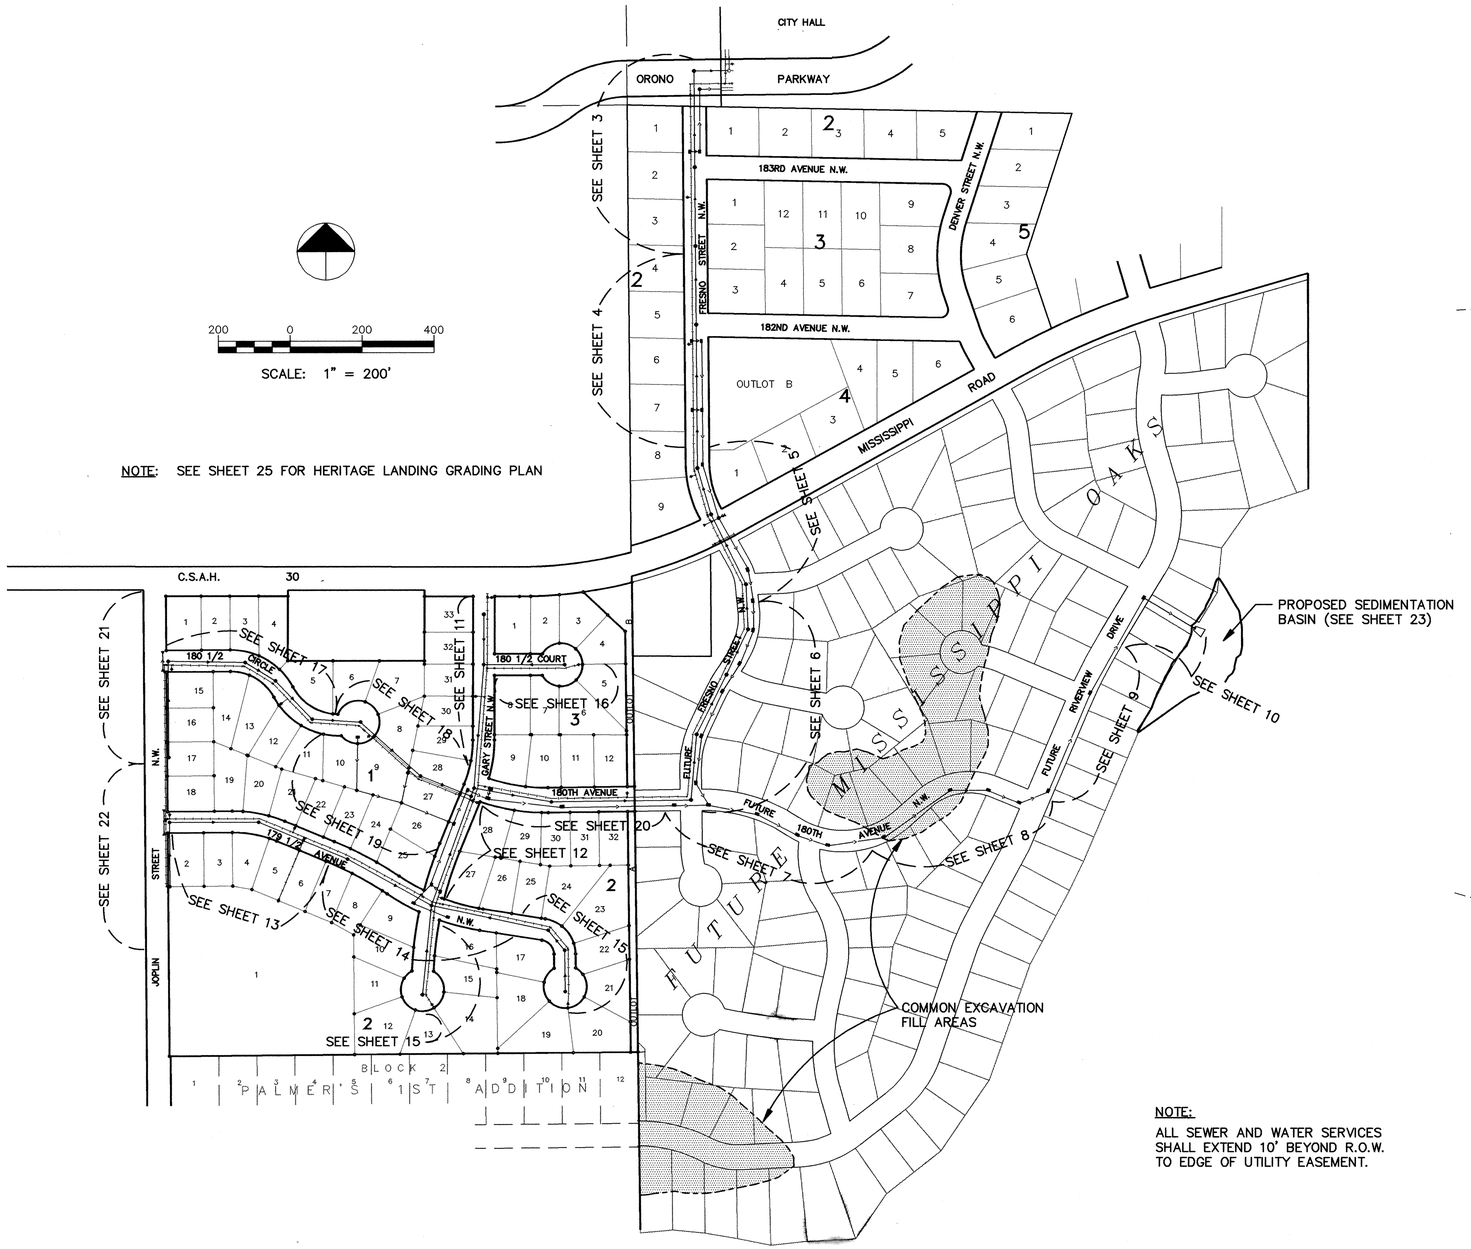

NOTE: SEE SHEET 25 FOR HERITAGE LANDING GRADING PLAN

LOCATION MAP

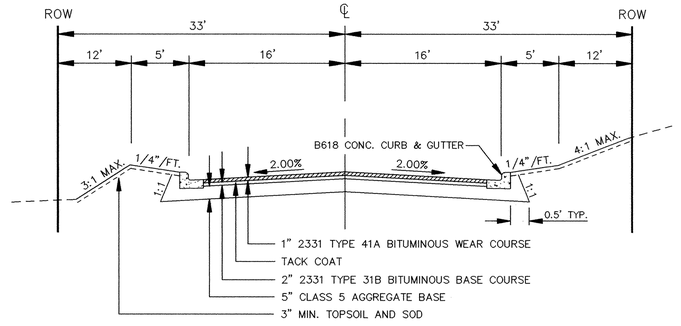

TYPICAL STREET SECTION
FRESNO STREET

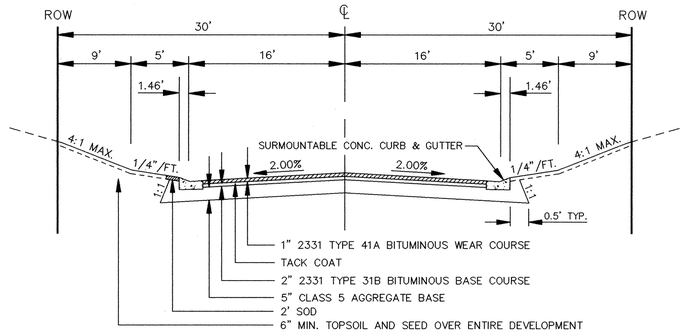

TYPICAL STREET SECTION
HERITAGE LANDING

NOTE:
ALL SEWER AND WATER SERVICES SHALL EXTEND 10' BEYOND R.O.W. TO EDGE OF UTILITY EASEMENT.

RECORD PLAN NOV,1993

I HEREBY CERTIFY THAT THIS PLAN, SPECIFICATION, OR REPORT WAS PREPARED BY ME OR UNDER MY DIRECT SUPERVISION AND THAT I AM A DULY REGISTERED PROFESSIONAL ENGINEER UNDER THE LAWS OF THE STATE OF MINNESOTA.
DATE 4/28/93 REG.NO. 15316

CONSULTING ENGINEERS
Maier Stewart & Associates Inc.
1959 SLOAN PLACE (612) 774-6021 ST. PAUL, MINNESOTA 55117
9800 SHELARD PARKWAY (612) 546-0432 MINNEAPOLIS, MINNESOTA 55441

REVISIONS	DATE	DESCRIPTION

DESIGNED GG
CHECKED TJM
DRAWN GG
GRAPHIC SCALE 0 HORIZ. 100 0 VERT.

CITY OF ELK RIVER
HERITAGE LANDING
LOCATION MAP & STREET SECTIONS

DATE APRIL 1993 | SHEET 2 OF 28 SHEETS | PROJECT NO. 230-159

ER159LM

DRAWING NUMBER
SAFCO PRODUCTS • NEW HOPE, MINNESOTA
REORDER BY PART NUMBER 63052
POSITION EDGE OF PRINT ON THIS LINE
DRAWING NUMBER
SAFCO PRODUCTS • NEW HOPE, MINNESOTA
REORDER BY PART NUMBER 63052
POSITION EDGE OF PRINT ON THIS LINE
DRAWING NUMBER
SAFCO PRODUCTS • NEW HOPE, MINNESOTA
REORDER BY PART NUMBER 63052
POSITION EDGE OF PRINT ON THIS LINE
DRAWING NUMBER
HERIT.93
2
SAFCO PRODUCTS • NEW HOPE, MINNESOTA
REORDER BY PART NUMBER 63052
POSITION EDGE OF PRINT ON THIS LINE