FRESNO STREET N.W.

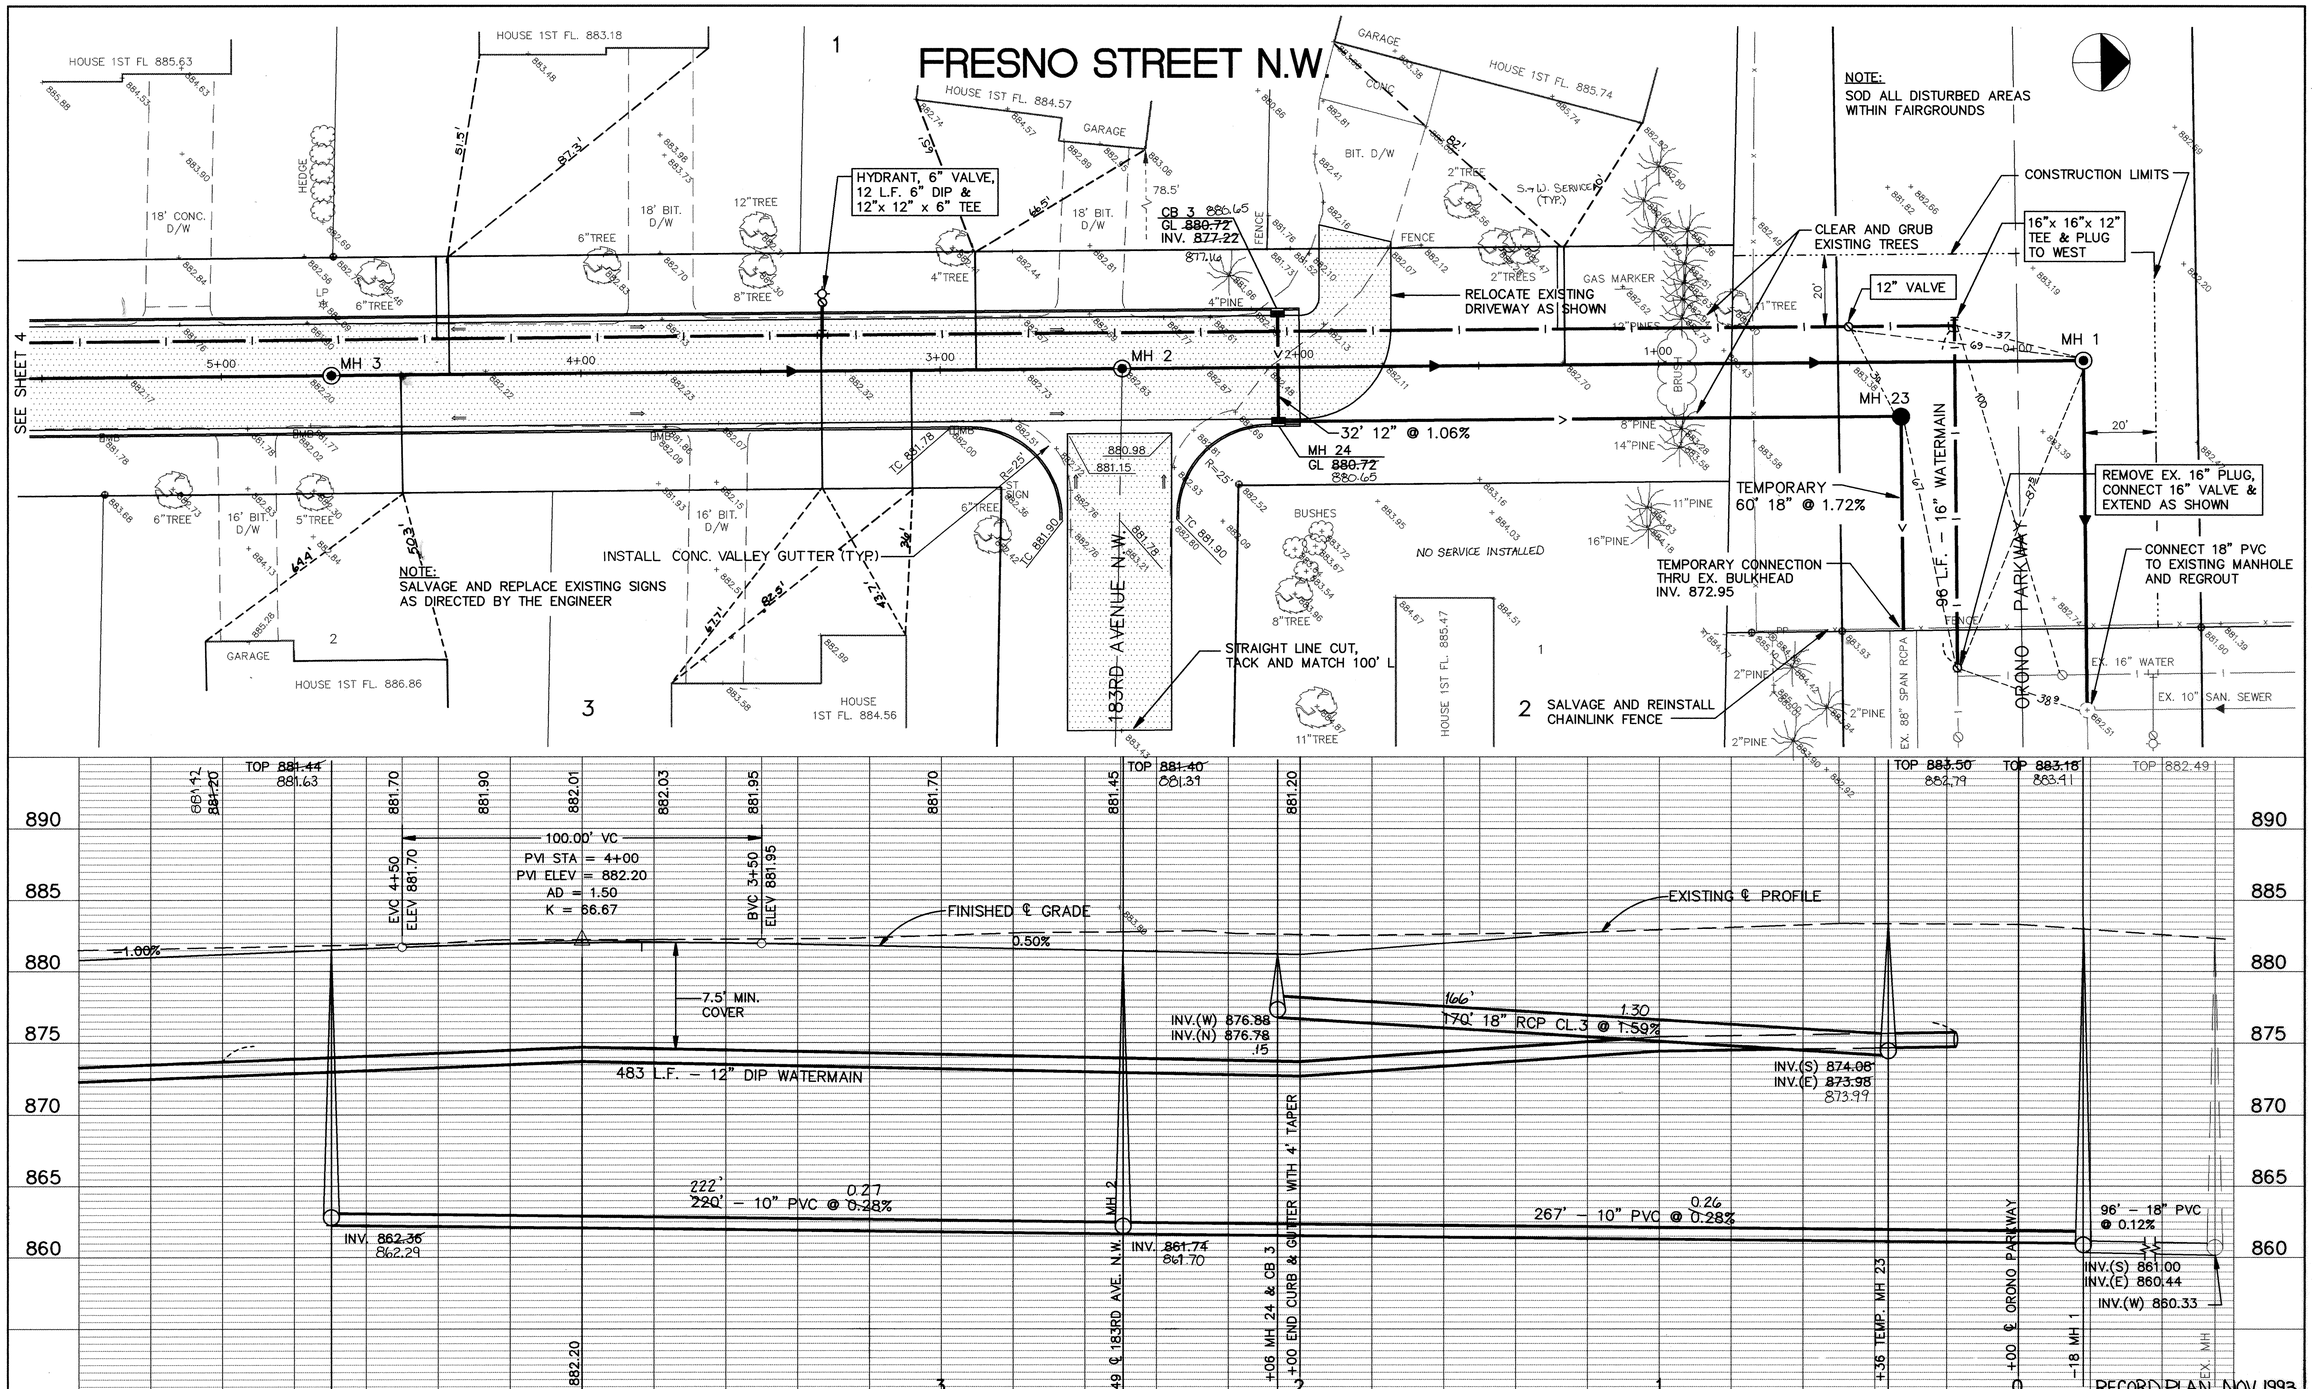

I HEREBY CERTIFY THAT THIS PLAN, SPECIFICATION, OR REPORT WAS PREPARED BY ME OR UNDER MY DIRECT SUPERVISION AND THAT I AM A DULY REGISTERED PROFESSIONAL ENGINEER UNDER THE LAWS OF THE STATE OF MINNESOTA.

Terry J. Maurer

DATE 4/27/93 REG.NO. 15316

Maier Stewart & Associates Inc.
CONSULTING ENGINEERS
1959 SLOAN PLACE (612) 774-6021
9800 SHELARD PARKWAY (612) 546-0432
ST. PAUL, MINNESOTA 55117
MINNEAPOLIS, MINNESOTA 55441

REVISIONS	DATE	DESCRIPTION

DESIGNED GG
CHECKED TJM
DRAWN TB
GRAPHIC SCALE 0 HORIZ. 20 0 VERT. 5

CITY OF ELK RIVER
SANITARY SEWER, WATERMAIN, STREET & STORM SEWER
FRESNO STREET N.W.

DATE APRIL 1993 | SHEET 3 OF 28 SHEETS | PROJECT NO. 230-159

ER159-15

600

DRAWING NUMBER

DRAWING NUMBER

DRAWING NUMBER HERIT.93 3

SAFCO PRODUCTS • NEW HOPE, MINNESOTA
REORDER BY PART NUMBER 60302