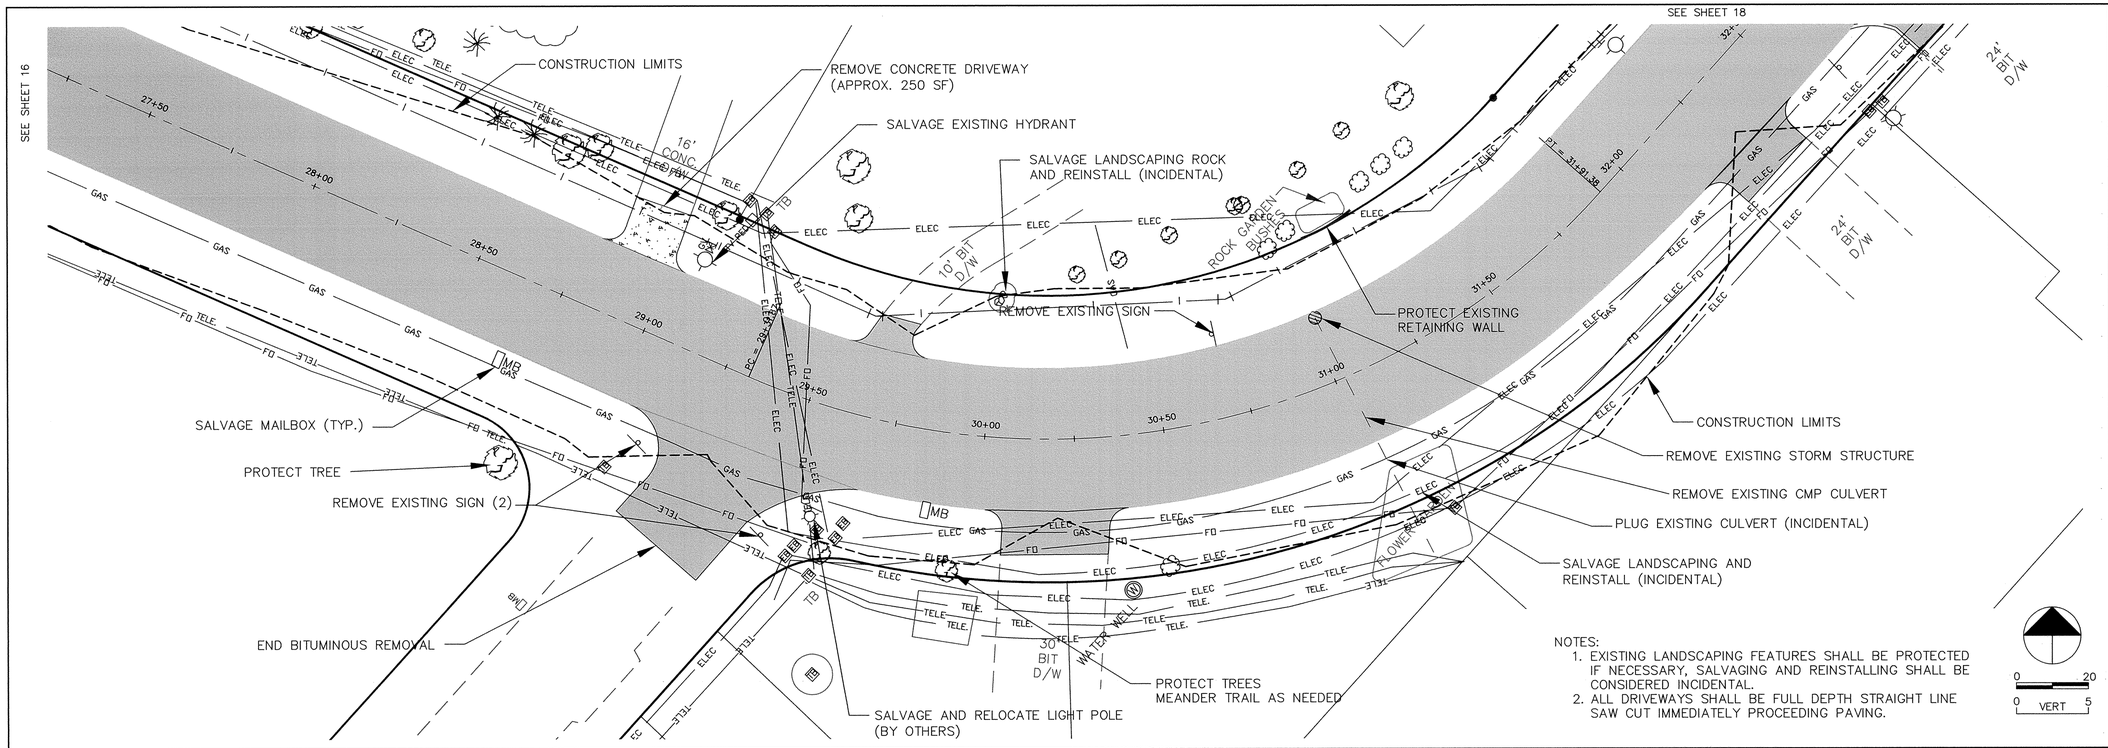

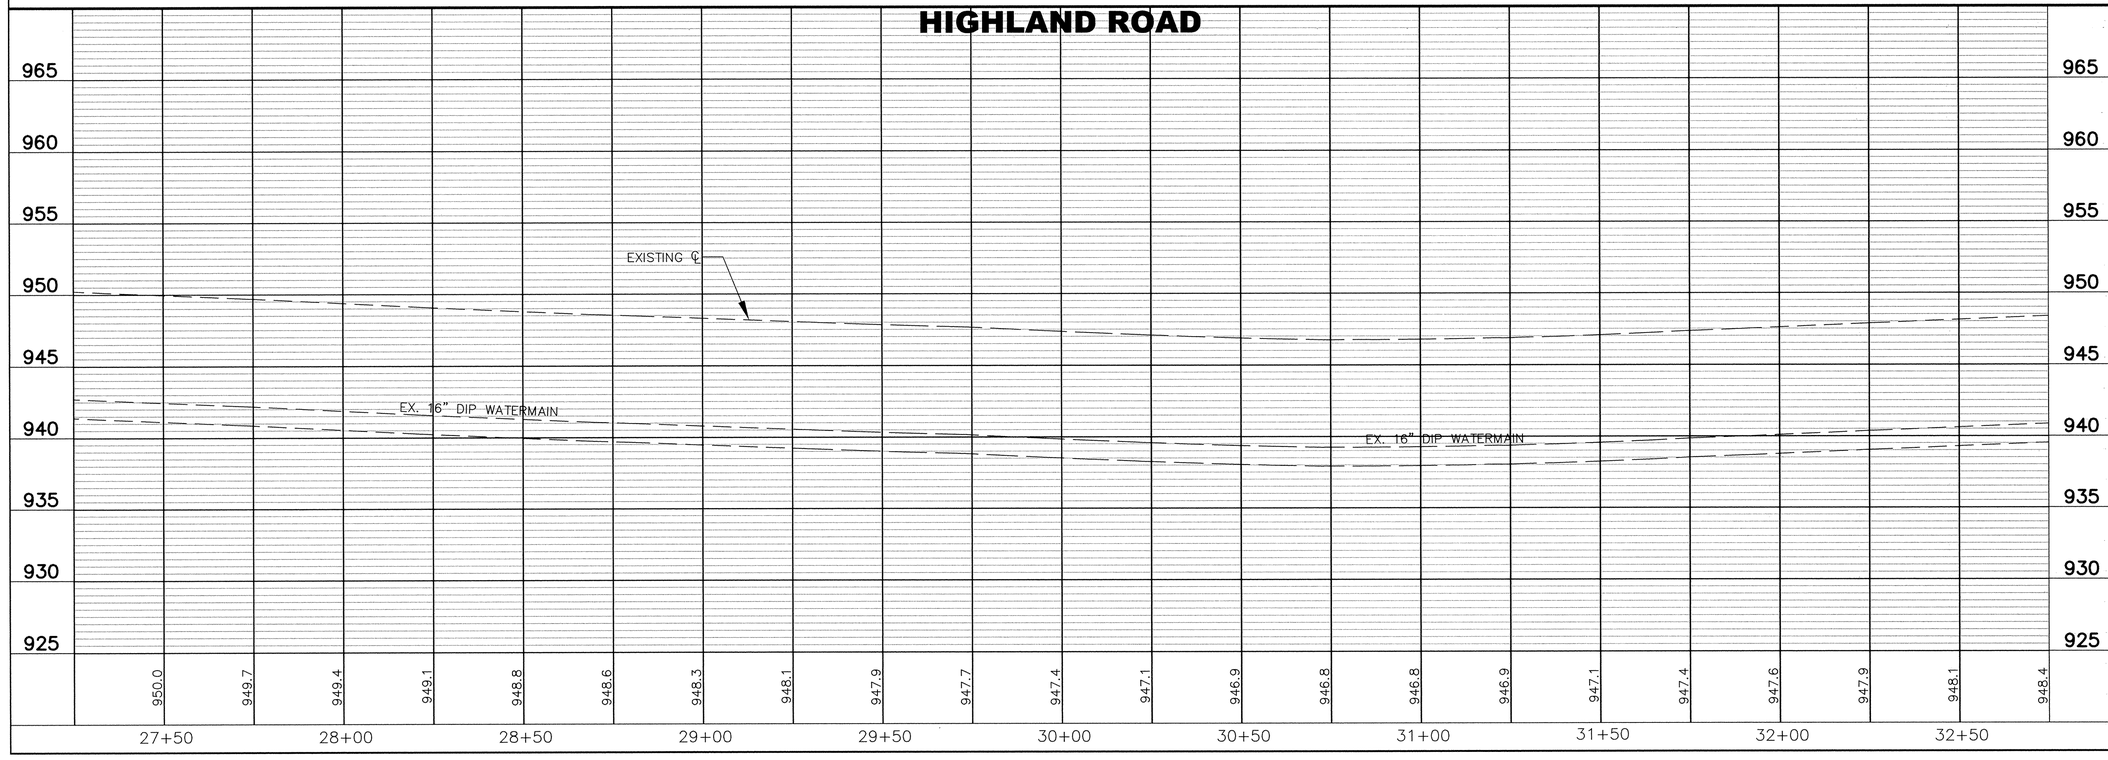

REVISIONS

NO.	DATE	BY	DESCRIPTION

I HEREBY CERTIFY THAT THIS PLAN, SPECIFICATION, OR REPORT WAS PREPARED BY ME OR UNDER MY DIRECT SUPERVISION AND THAT I AM A DULY LICENSED PROFESSIONAL ENGINEER UNDER THE LAWS OF THE STATE OF MINNESOTA.

05-02-2006 DATE

15316 LIC. NO.

SAP 204-137-001

RECORD PLAN
HIGHLAND ROAD IMPROVEMENTS
REMOVAL PLAN
HIGHLAND ROAD

28+00 TO 32+00

BDM
CONSULTING ENGINEERS, PLC
Engineers and Surveyors
4175 Lovell Road, Suite 112
Lexington, MN 55014
Phone: (763) 786-4570
Fax: (763) 786-4574
bdmce.com

DRAWN BY: NAB
CHECKED BY: KJT
DESIGNED BY: KJT
JOB NO. 226068D

SHEET 17 | SHEETS 55

DRAWING NUMBER

SAFCO PRODUCTS • NEW HOPE, MINNESOTA
REORDER BY PART NUMBER 65532
PRINTED COPIES OF SHEET ARE TRACE SAFE
DRAWING NUMBER
SAFCO PRODUCTS • NEW HOPE, MINNESOTA
REORDER BY PART NUMBER 65532
PRINTED COPIES OF SHEET ARE TRACE SAFE
DRAWING NUMBER
HIGHLAND 06
17
SAFCO PRODUCTS • NEW HOPE, MINNESOTA
REORDER BY PART NUMBER 65532
PRINTED COPIES OF SHEET ARE TRACE SAFE