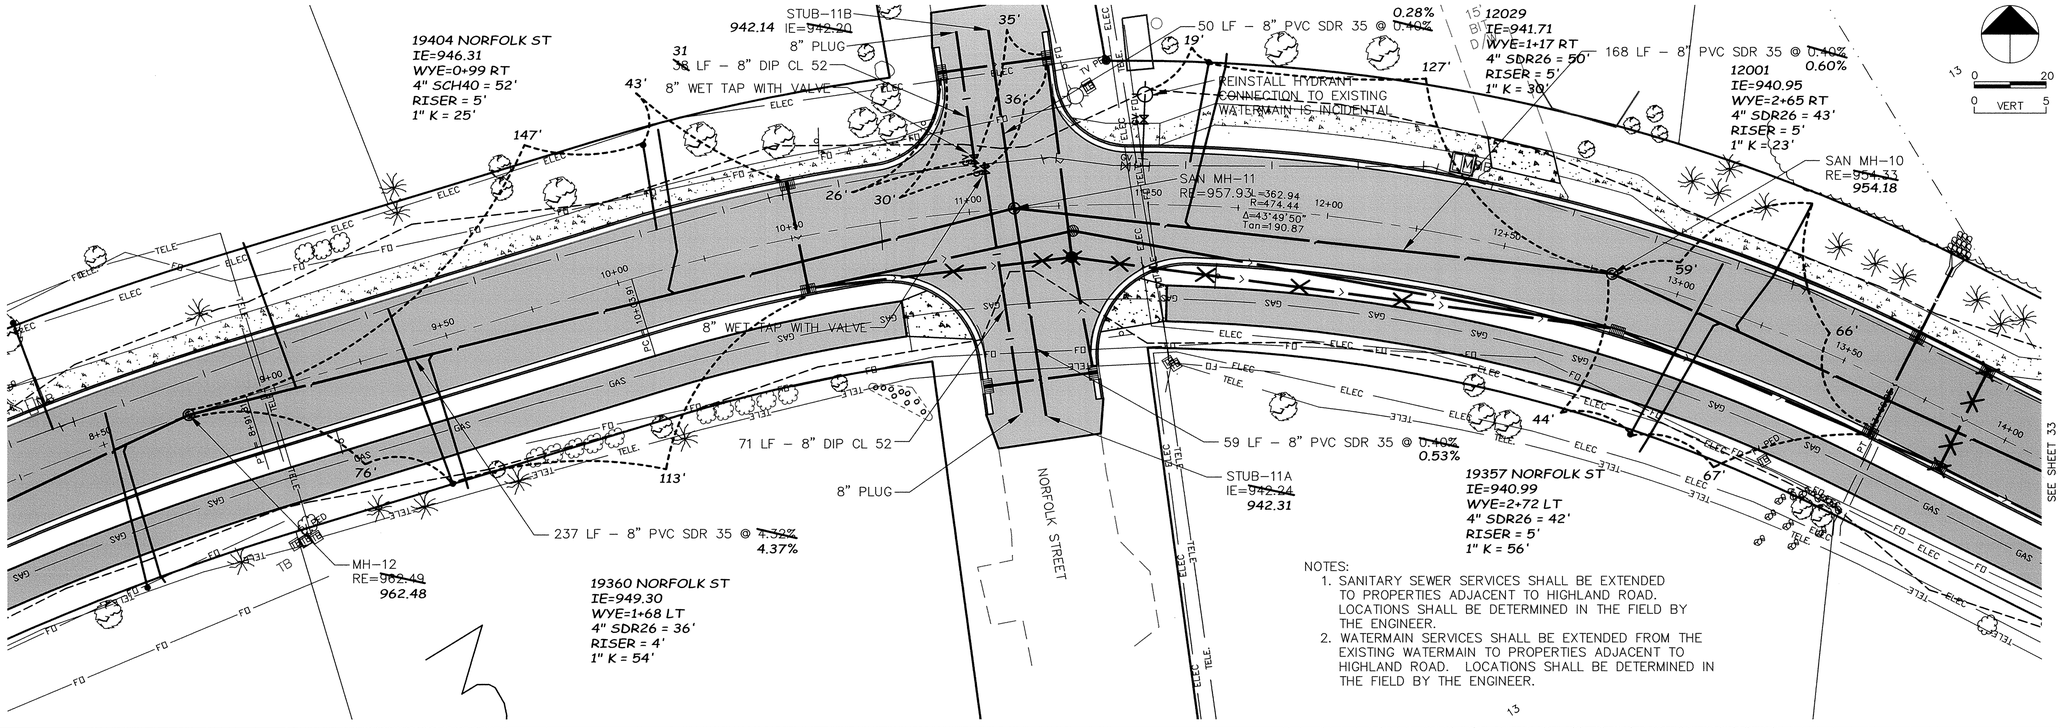

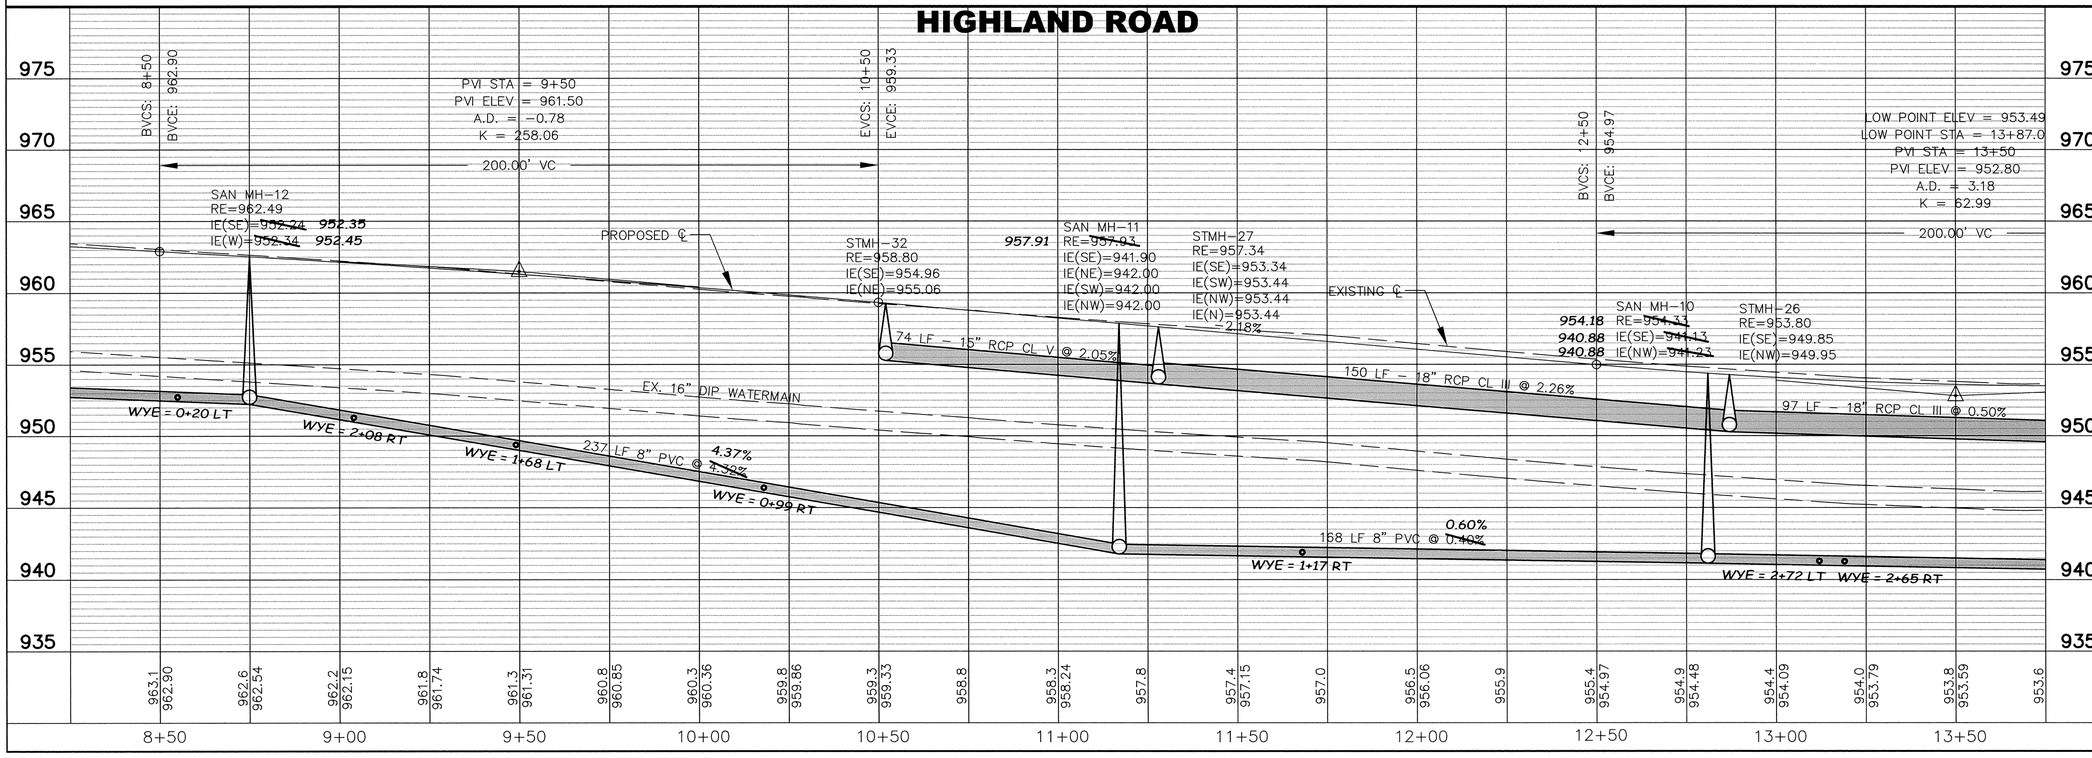

REVISIONS

NO.	DATE	BY	DESCRIPTION

I HEREBY CERTIFY THAT THIS PLAN, SPECIFICATION, OR REPORT WAS PREPARED BY ME OR UNDER MY DIRECT SUPERVISION AND THAT I AM A DULY LICENSED PROFESSIONAL ENGINEER UNDER THE LAWS OF THE STATE OF MINNESOTA.

DATE 05-02-2006 LIC. NO. 15316

SAP 204-137-001

RECORD PLAN
HIGHLAND ROAD IMPROVEMENTS
SANITARY SEWER AND WATERMAIN
HIGHLAND ROAD

9+00 TO 13+50

BDM
CONSULTING ENGINEERS, PLC
Engineers and Surveyors
4175 Lovell Road, Suite 112
Lexington, MN 55014
Phone: (763) 786-4570
Fax: (763) 786-4574
bdmce.com

DRAWN BY:	NAB
CHECKED BY:	KJT
DESIGNED BY:	KJT
JOB NO.	226068D

SHEET	SHEETS
32	55

DRAWING NUMBER

DRAWING NUMBER
HIGHLAND.06
32

SAFCO PRODUCTS • NEW HOPE, MINNESOTA
REORDER BY PART NUMBER 6562
POSITIVE EDGE OF PAPER DETAINER