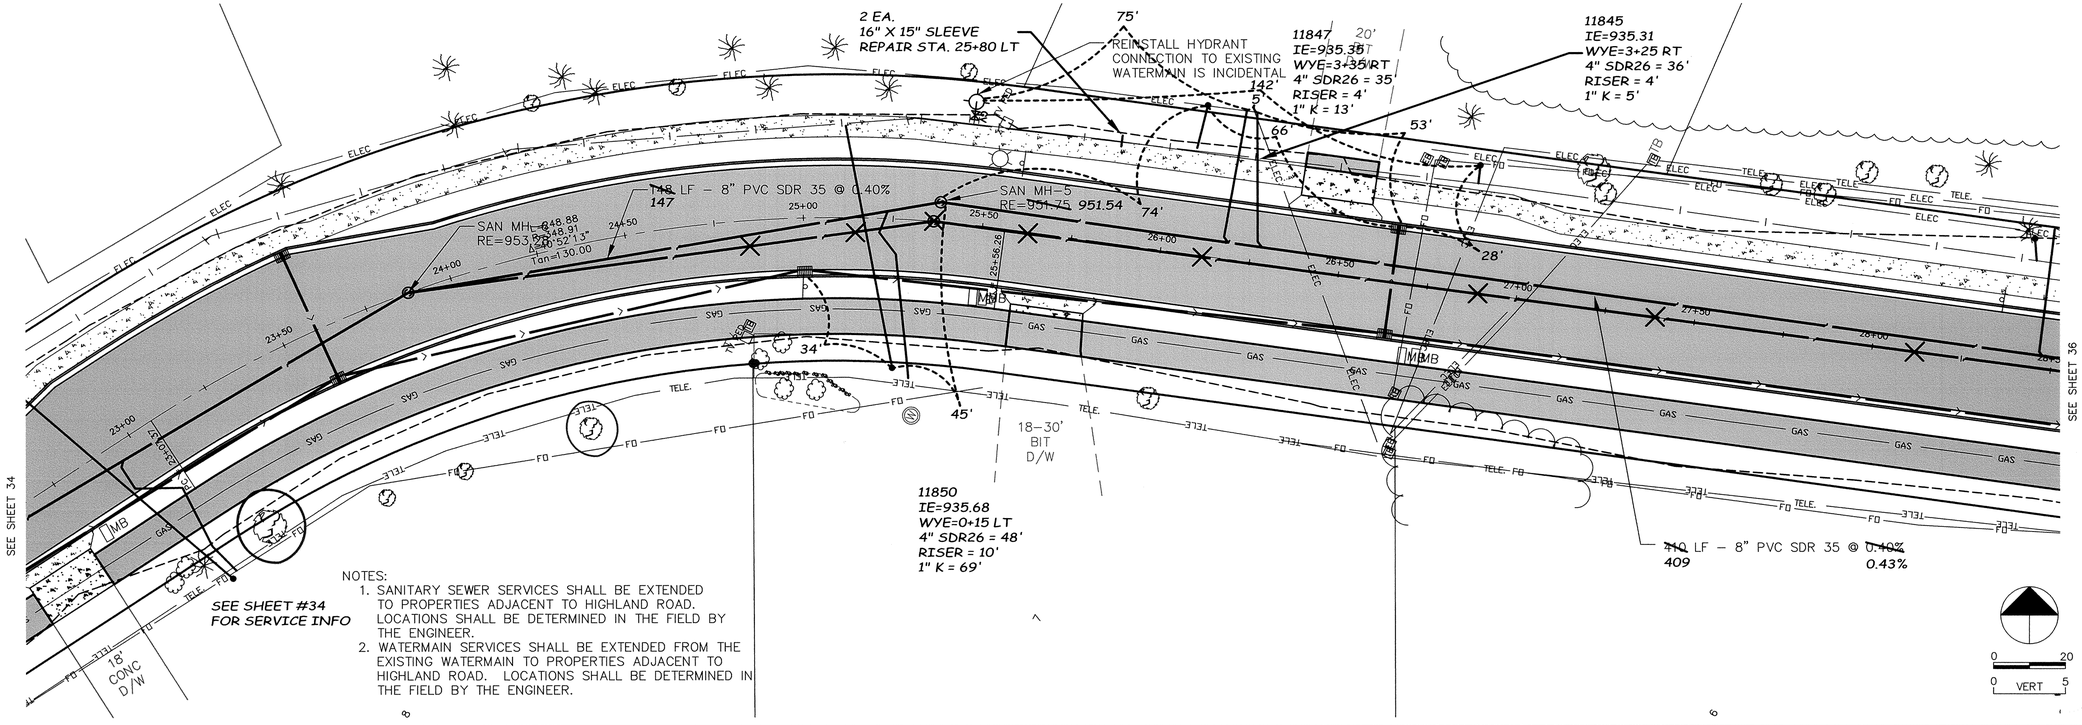

NOTES:

1. SANITARY SEWER SERVICES SHALL BE EXTENDED TO PROPERTIES ADJACENT TO HIGHLAND ROAD. LOCATIONS SHALL BE DETERMINED IN THE FIELD BY THE ENGINEER.
2. WATERMAIN SERVICES SHALL BE EXTENDED FROM THE EXISTING WATERMAIN TO PROPERTIES ADJACENT TO HIGHLAND ROAD. LOCATIONS SHALL BE DETERMINED IN THE FIELD BY THE ENGINEER.

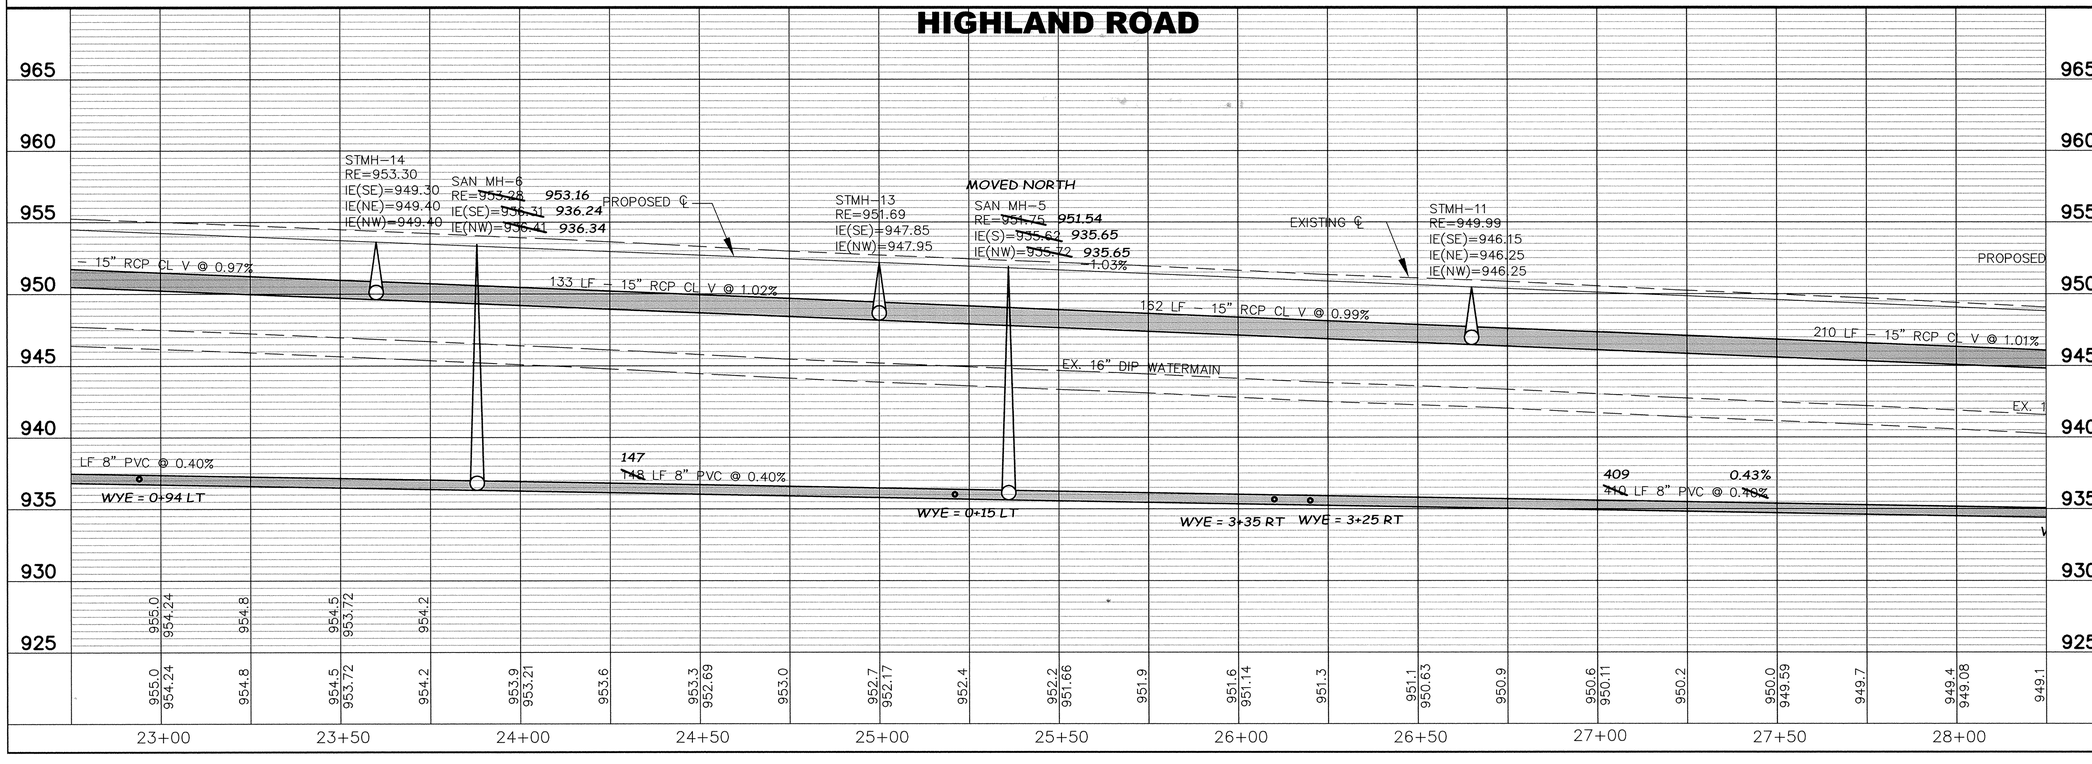

REVISIONS

NO.	DATE	BY	DESCRIPTION

I HEREBY CERTIFY THAT THIS PLAN, SPECIFICATION, OR REPORT WAS PREPARED BY ME OR UNDER MY DIRECT SUPERVISION AND THAT I AM A DULY LICENSED PROFESSIONAL ENGINEER UNDER THE LAWS OF THE STATE OF MINNESOTA.

05-02-2006 — DATE
15316 — LIC. NO.

SAP 204-137-001

RECORD PLAN
HIGHLAND ROAD IMPROVEMENTS
SANITARY SEWER AND WATERMAIN
HIGHLAND ROAD

23+00 TO 28+00

BDM
CONSULTING ENGINEERS, PLC
Engineers and Surveyors
4175 Lovell Road, Suite 112
Lexington, MN 55014
Phone: (763) 786-4570
Fax: (763) 786-4574
bdmce.com

DRAWN BY:	NAB
CHECKED BY:	KJT
DESIGNED BY:	KJT
JOB NO.	226068D

SHEET	SHEETS
35	55

DRAWING NUMBER

DRAWING NUMBER
HIGHLAND.06
35