HIGHLAND ROAD

15+00

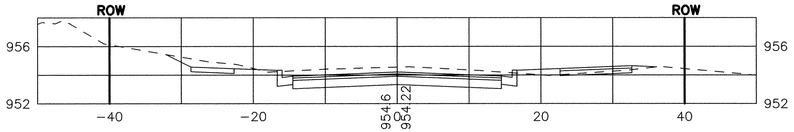

14+71

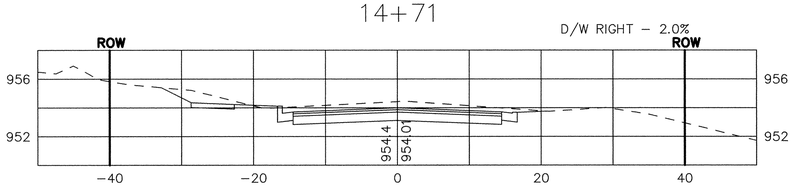

14+50

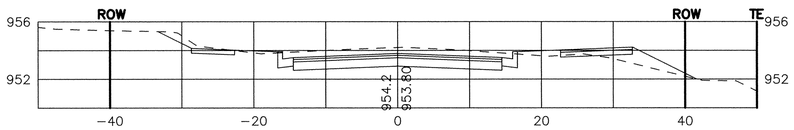

14+43

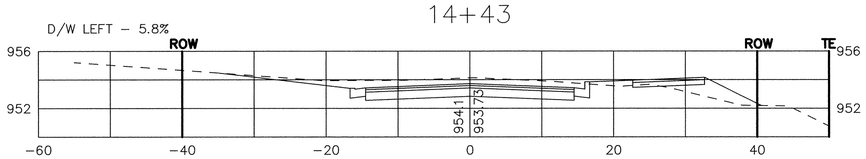

14+00

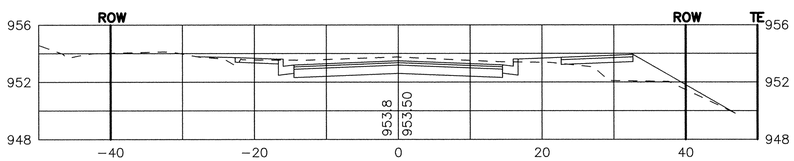

13+66.85

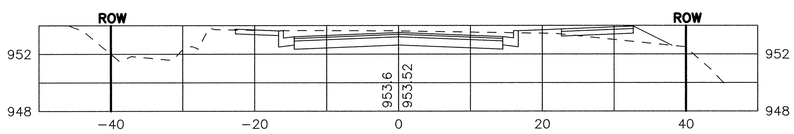

13+50

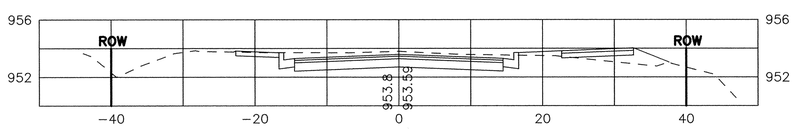

16+50

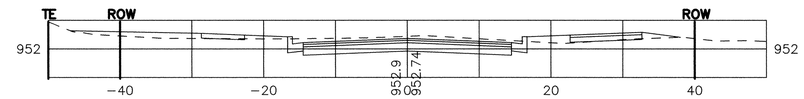

16+23

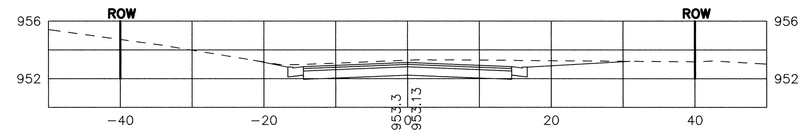

16+21

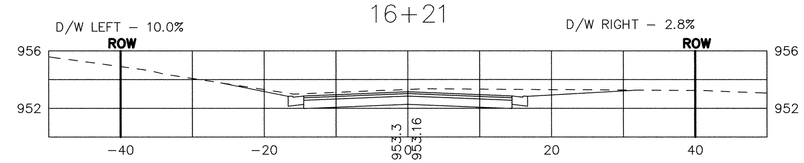

16+00

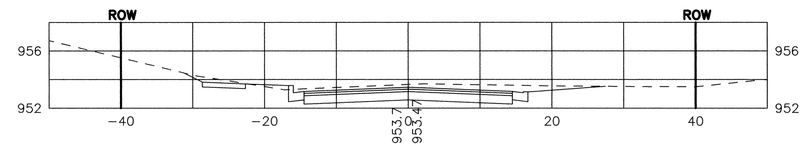

15+84

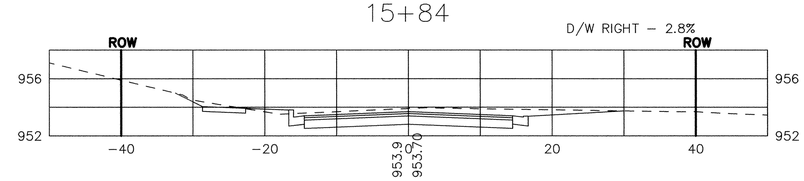

15+50

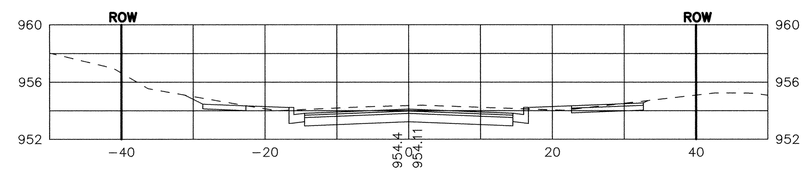

15+14.71

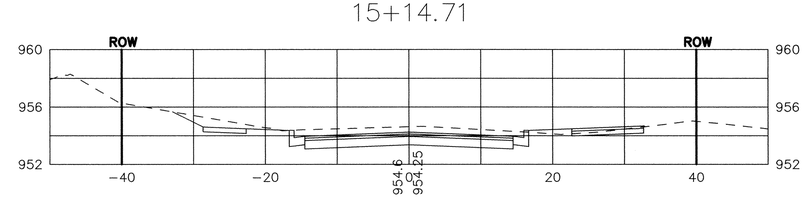

REVISIONS

NO.	DATE	BY	DESCRIPTION

I HEREBY CERTIFY THAT THIS PLAN, SPECIFICATION, OR REPORT WAS PREPARED BY ME OR UNDER MY DIRECT SUPERVISION AND THAT I AM A DULY LICENSED PROFESSIONAL ENGINEER UNDER THE LAWS OF THE STATE OF MINNESOTA.

05-02-2006 DATE

15316 LIC. NO.

SAP 204-137-001

RECORD PLAN

HIGHLAND ROAD IMPROVEMENTS

CROSS SECTIONS

13+50 TO 16+50

BDM
CONSULTING ENGINEERS, PLC
Engineers and Surveyors
4175 Lovell Road, Suite 112
Lexington, MN 55014
Phone: (763) 786-4570
Fax: (763) 786-4574
bdmce.com

DRAWN BY: NAB

CHECKED BY: KJT

DESIGNED BY: KJT

JOB NO. 226068D

SHEET 41 | SHEETS 55

DRAWING NUMBER

DRAWING NUMBER

DRAWING NUMBER

DRAWING NUMBER
HIGHLAND.06
41

SAFCO PRODUCTS • NEW HOPE, MINNESOTA
REORDER BY PART NUMBER 65052