HIGHLAND ROAD

24+50

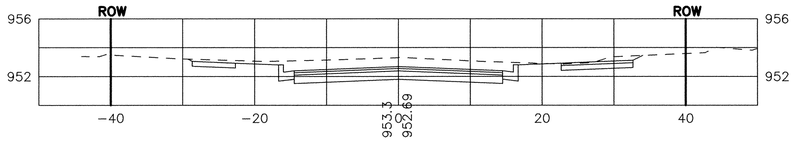

24+00

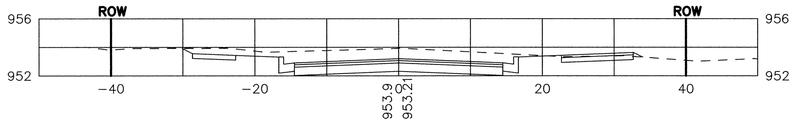

23+50

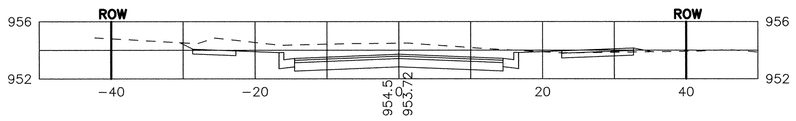

23+07.37

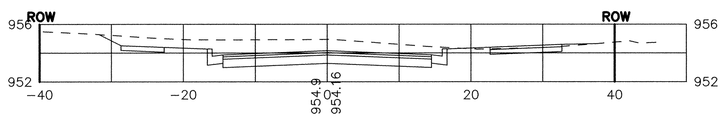

23+00

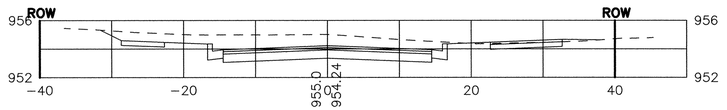

22+64

D/W RIGHT − 5.0%

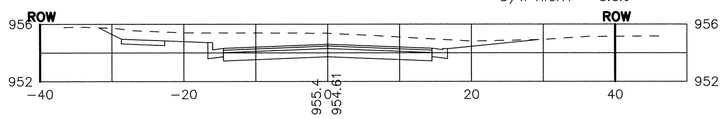

22+50

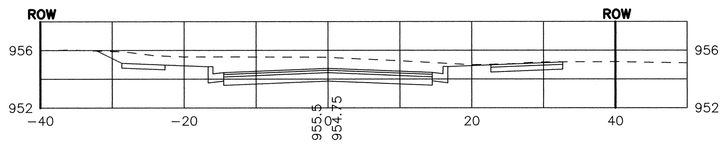

22+00

27+00

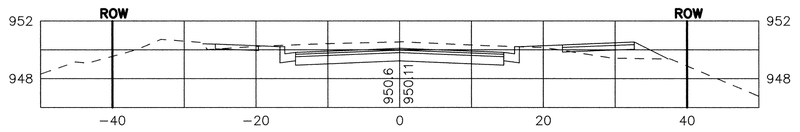

26+50

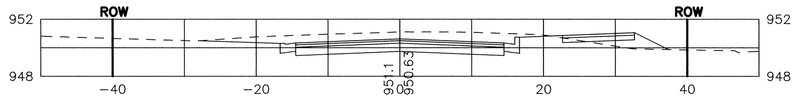

26+47

D/W LEFT − 1.8%

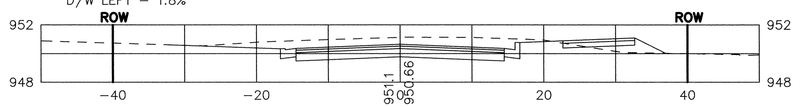

26+00

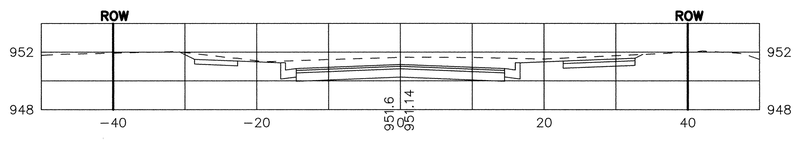

25+70

D/W RIGHT − 6.1%

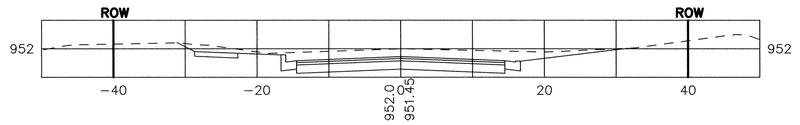

25+56.26

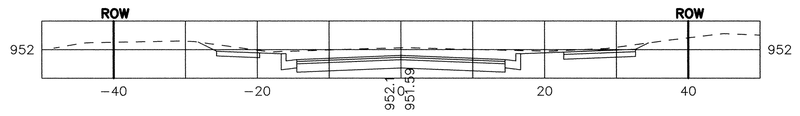

25+50

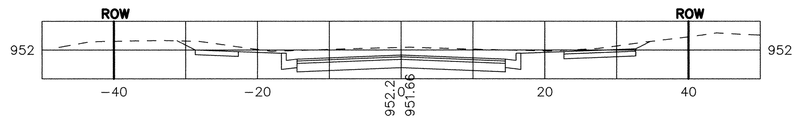

25+00

REVISIONS

NO.	DATE	BY	DESCRIPTION

I HEREBY CERTIFY THAT THIS PLAN, SPECIFICATION, OR REPORT WAS PREPARED BY ME OR UNDER MY DIRECT SUPERVISION AND THAT I AM A DULY LICENSED PROFESSIONAL ENGINEER UNDER THE LAWS OF THE STATE OF MINNESOTA.

05−02−2006
DATE

15316
LIC. NO.

SAP 204-137-001

RECORD PLAN
HIGHLAND ROAD IMPROVEMENTS

22+00 TO 27+00

CROSS SECTIONS

BDM
CONSULTING ENGINEERS, PLC
Engineers and Surveyors
4175 Lovell Road, Suite 112
Lexington, MN 55014
Phone: (763) 786−4570
Fax: (763) 786−4574
bdmce.com

DRAWN BY:	NAB
CHECKED BY:	KJT
DESIGNED BY:	KJT
JOB NO.	226068D

SHEET	SHEETS
43	55

DRAWING NUMBER

SAFCO PRODUCTS • NEW HOPE, MINNESOTA
REORDER BY PART NUMBER 6552

DRAWING NUMBER
SAFCO PRODUCTS • NEW HOPE, MINNESOTA
REORDER BY PART NUMBER 6552
DRAWING NUMBER
SAFCO PRODUCTS • NEW HOPE, MINNESOTA
REORDER BY PART NUMBER 6552

DRAWING NUMBER
HIGHLAND.06
43

SAFCO PRODUCTS • NEW HOPE, MINNESOTA
REORDER BY PART NUMBER 6552