
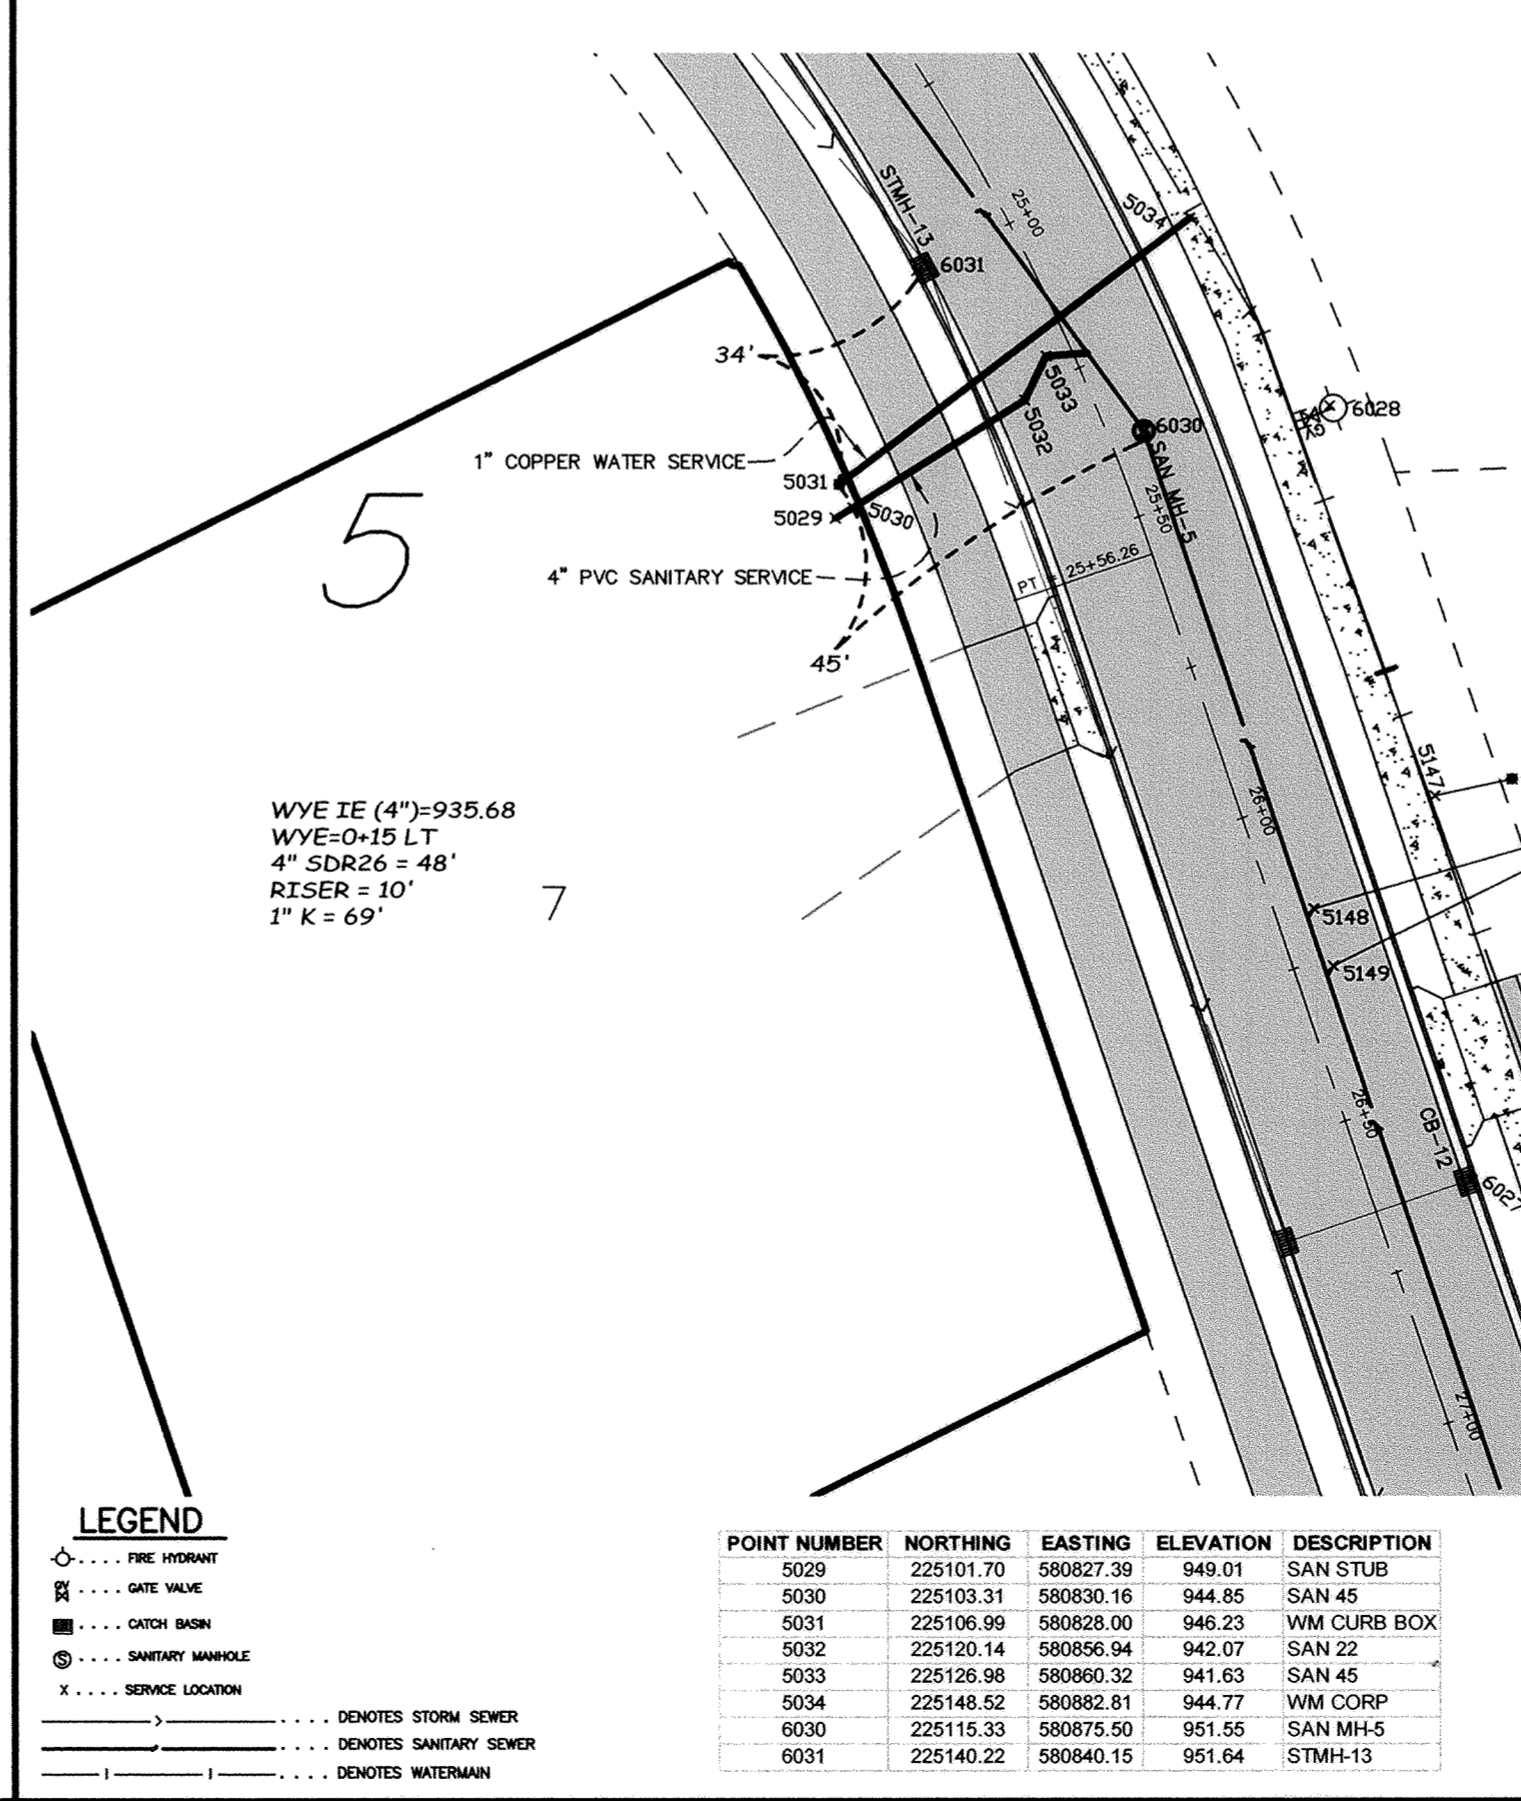
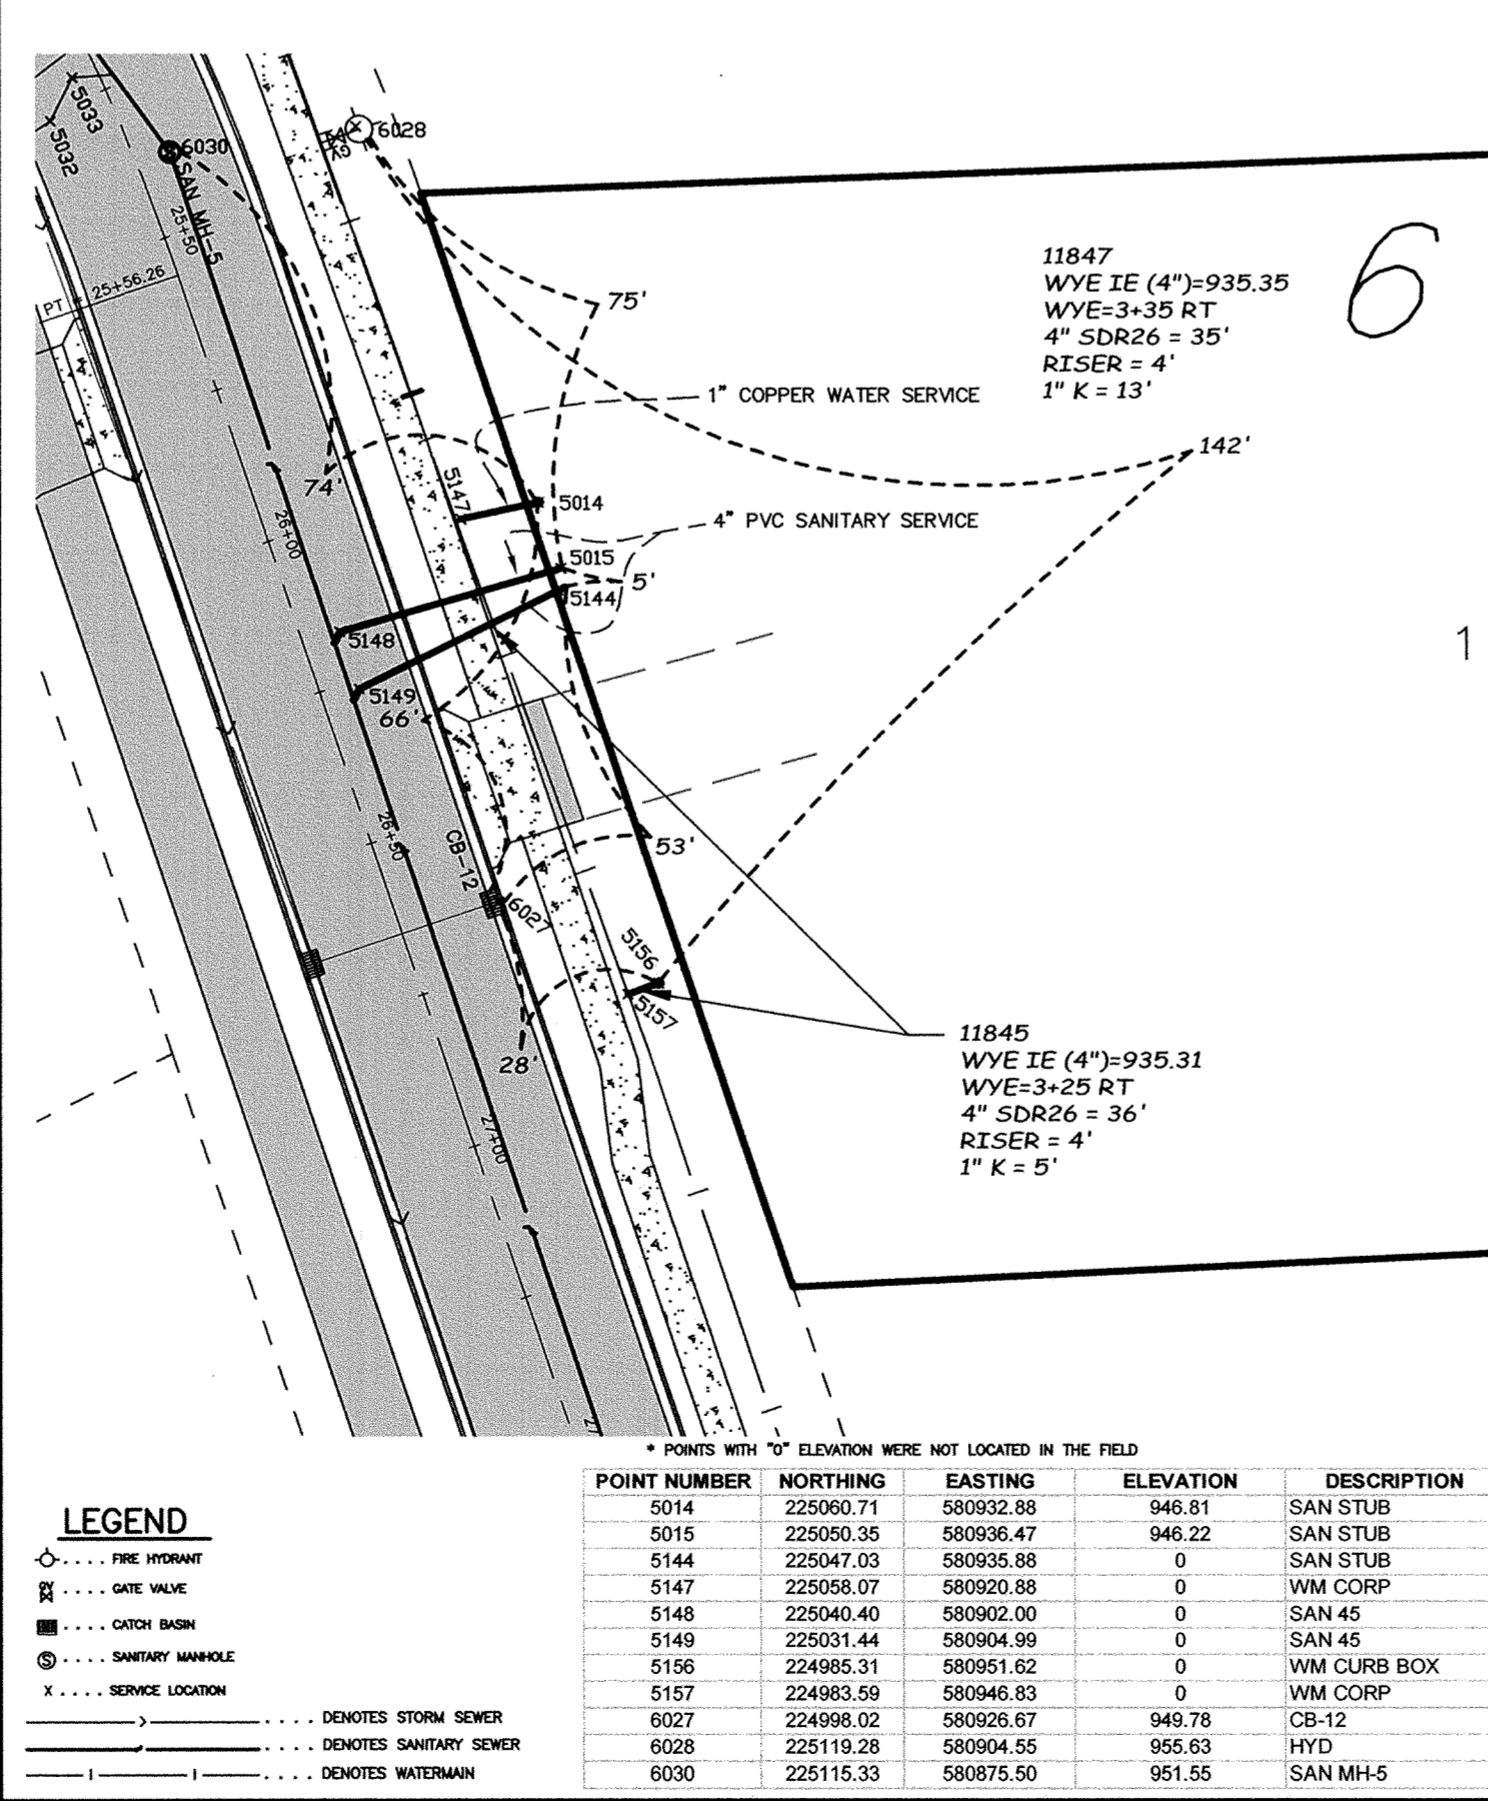


**SERVICE LOCATION**  
 11812 HIGHLAND RD NW  
 CITY OF ELK RIVER  
 HIGHLAND ROAD

**SERVICE LOCATION**  
 11814 HIGHLAND RD NW  
 CITY OF ELK RIVER  
 HIGHLAND ROAD

**SERVICE LOCATION**  
 11809 HIGHLAND RD NW  
 CITY OF ELK RIVER  
 HIGHLAND ROAD

**SERVICE LOCATION**  
 11811 HIGHLAND RD NW  
 CITY OF ELK RIVER  
 HIGHLAND ROAD

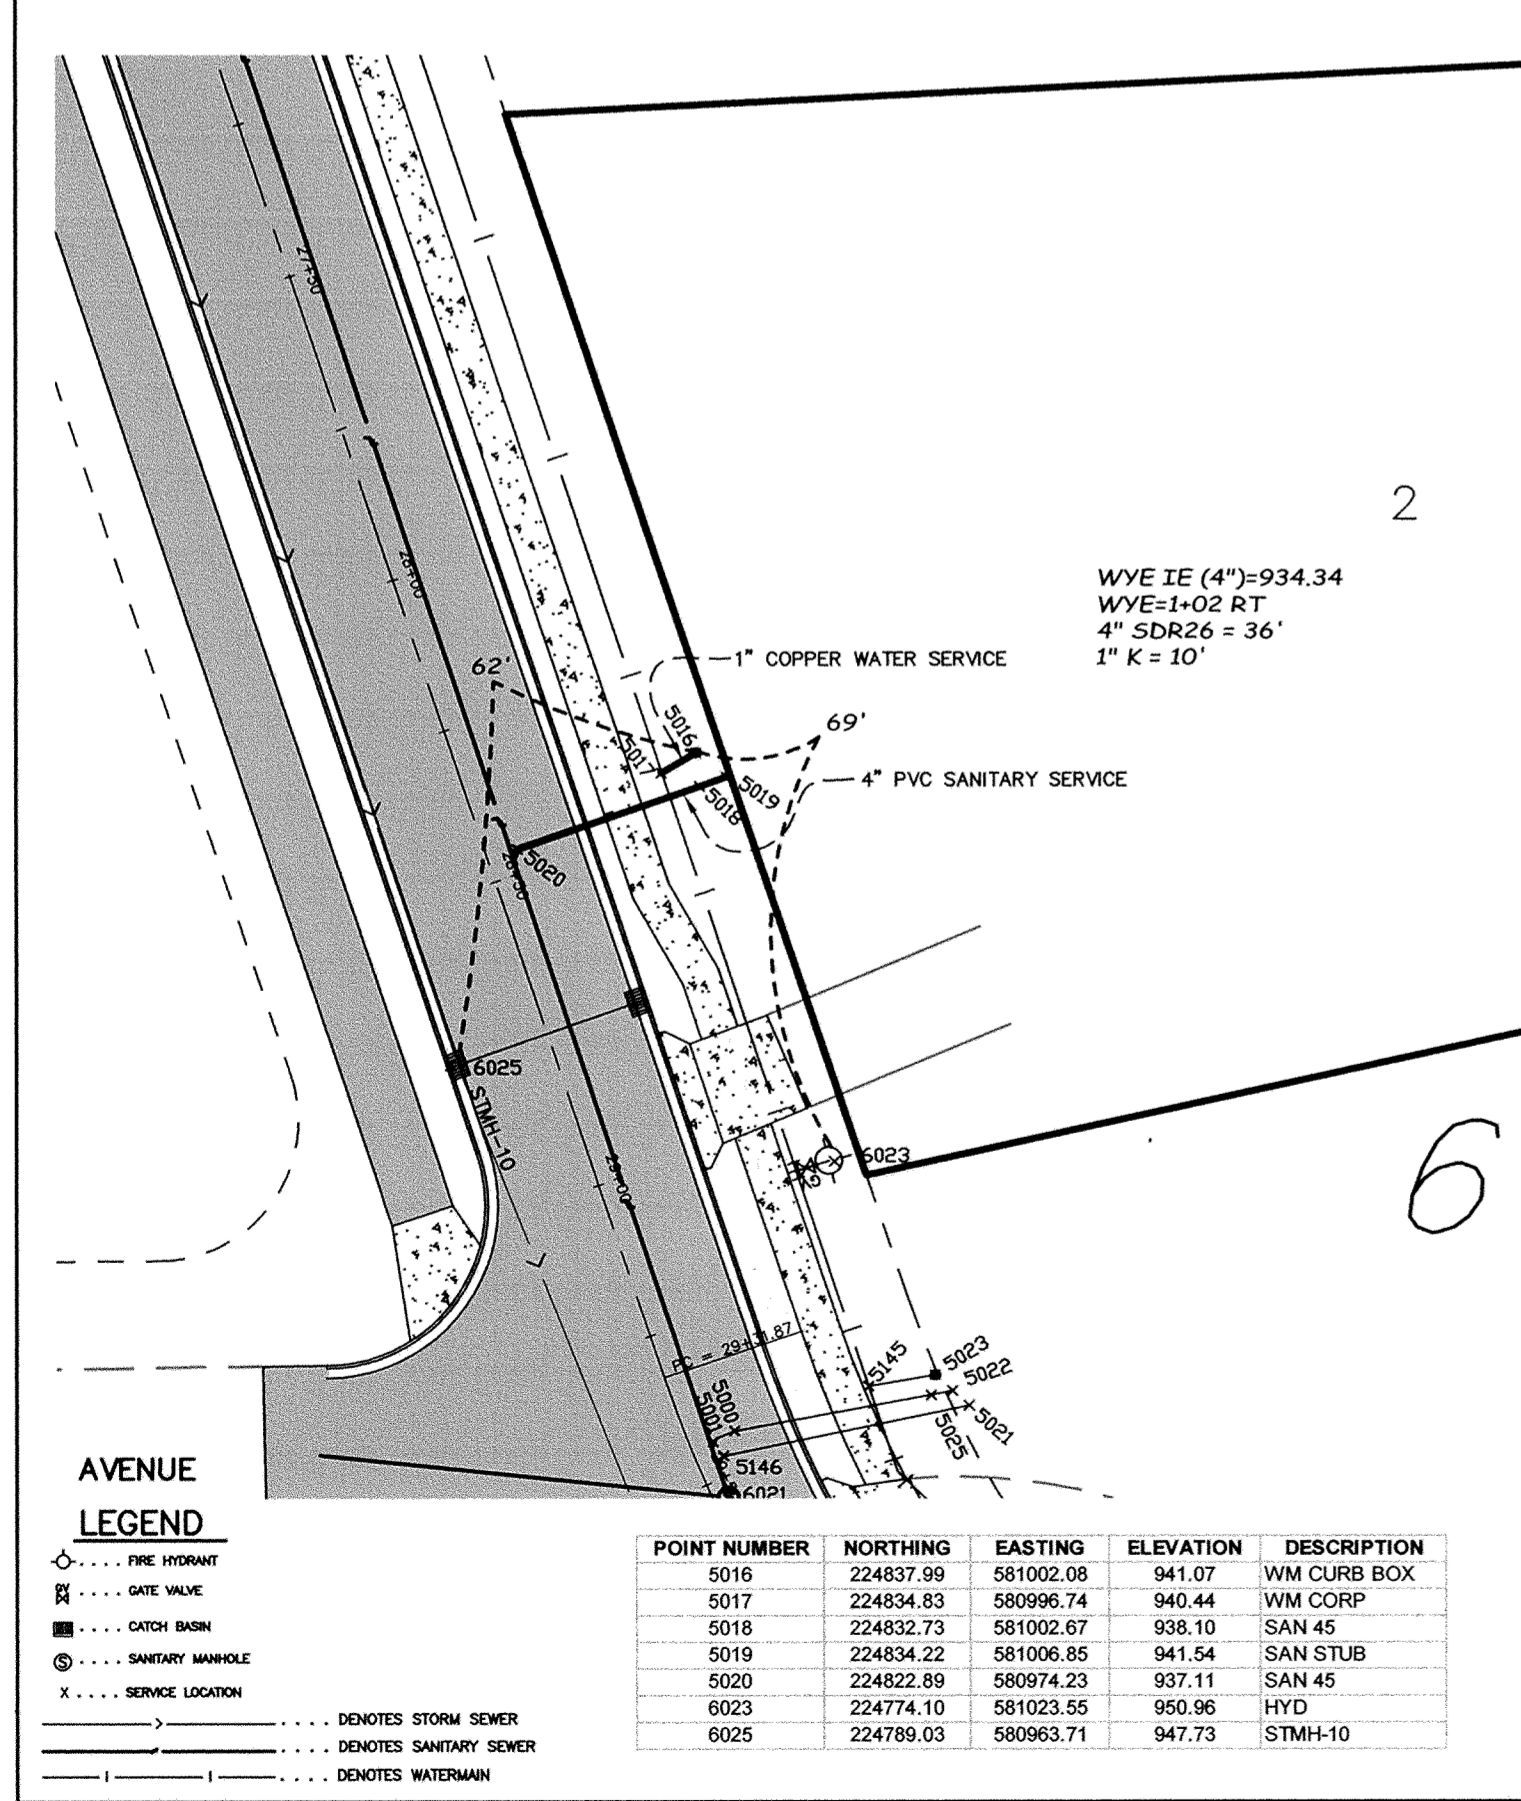

**SERVICE LOCATION**  
 11829 HIGHLAND RD NW  
 CITY OF ELK RIVER  
 HIGHLAND ROAD

**SERVICE LOCATION**  
 11845 HIGHLAND RD NW  
 11847 HIGHLAND RD NW  
 CITY OF ELK RIVER  
 HIGHLAND ROAD

**SERVICE LOCATION**  
 11850 HIGHLAND RD NW  
 CITY OF ELK RIVER  
 HIGHLAND ROAD