



POINT NUMBER	NORTHING	EASTING	ELEVATION	DESCRIPTION
5035	225462.56	580482.94	948.35	WM CORP
5036	225466.77	580484.31	948.19	WM CURB BOX
5037	225466.90	580488.62	949.79	SAN STUB
5038	225464.27	580486.40	946.12	SAN 45
5039	225444.85	580474.70	945.23	SAN 45
5040	225443.71	580470.90	944.91	SAN 45
6039	225347.50	580615.95	955.20	SAN MH-7
6045	225525.74	580373.98	954.75	HYD
6045	225525.74	580373.98	954.75	HYD

SERVICE LOCATION
11915 HIGHLAND RD NW
CITY OF ELK RIVER
HIGHLAND ROAD

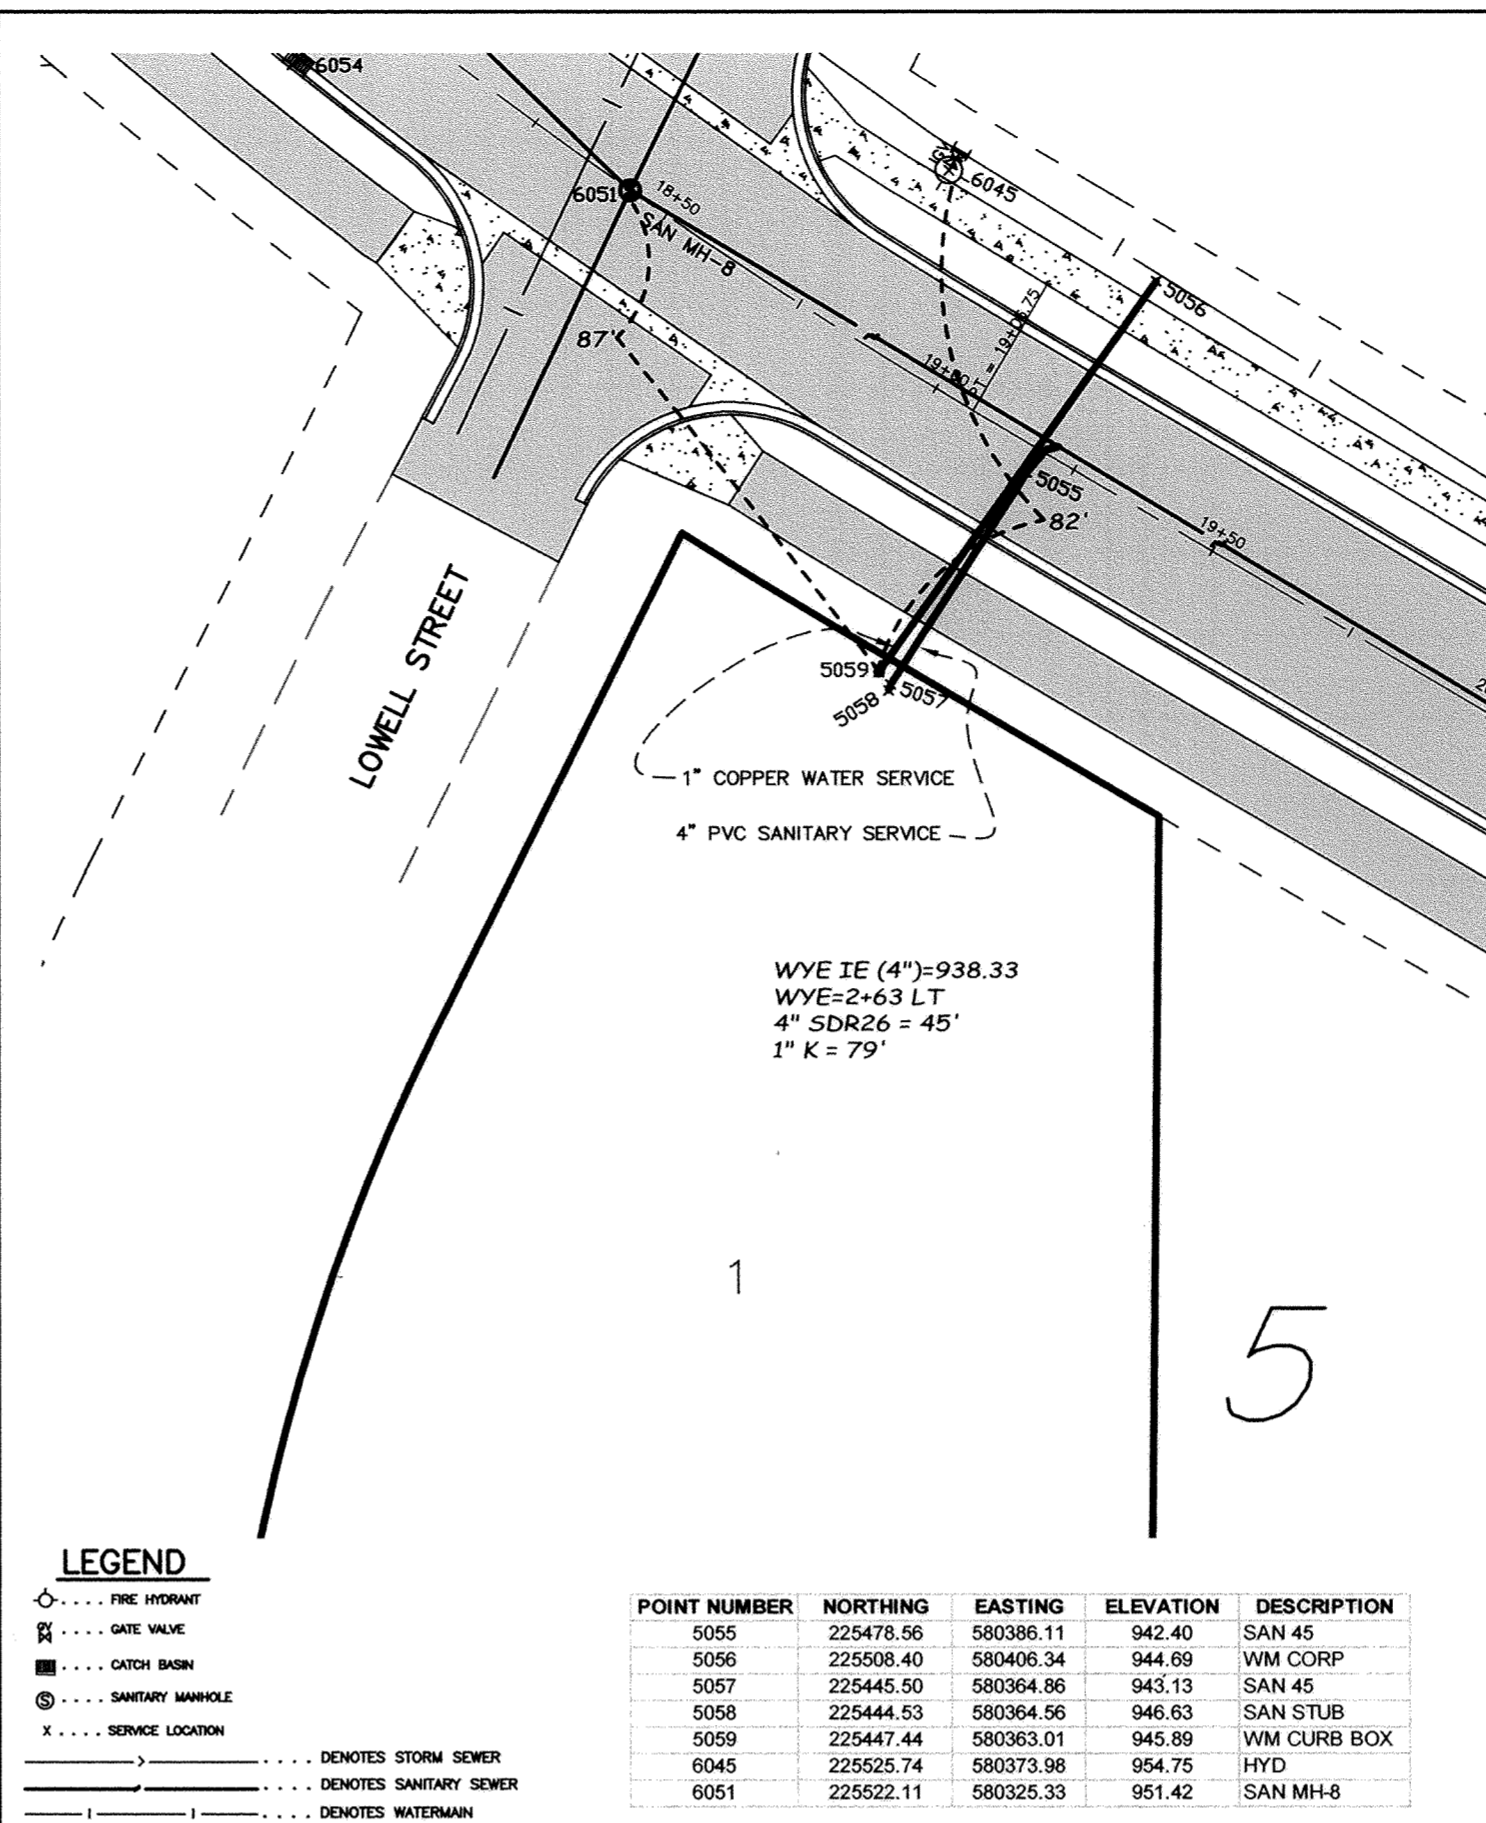


POINT NUMBER	NORTHING	EASTING	ELEVATION	DESCRIPTION
5055	225478.56	580386.11	942.40	SAN 45
5056	225508.40	580406.34	944.09	WM CORP
5057	225445.50	580364.86	943.13	SAN 45
5058	225444.53	580364.56	946.63	SAN STUB
5059	225447.44	580363.01	945.89	WM CURB BOX
6045	225525.74	580373.98	954.75	HYD
6051	225522.11	580325.33	951.42	SAN MH-8

SERVICE LOCATION
19263 LOWELL ST NW
CITY OF ELK RIVER
HIGHLAND ROAD

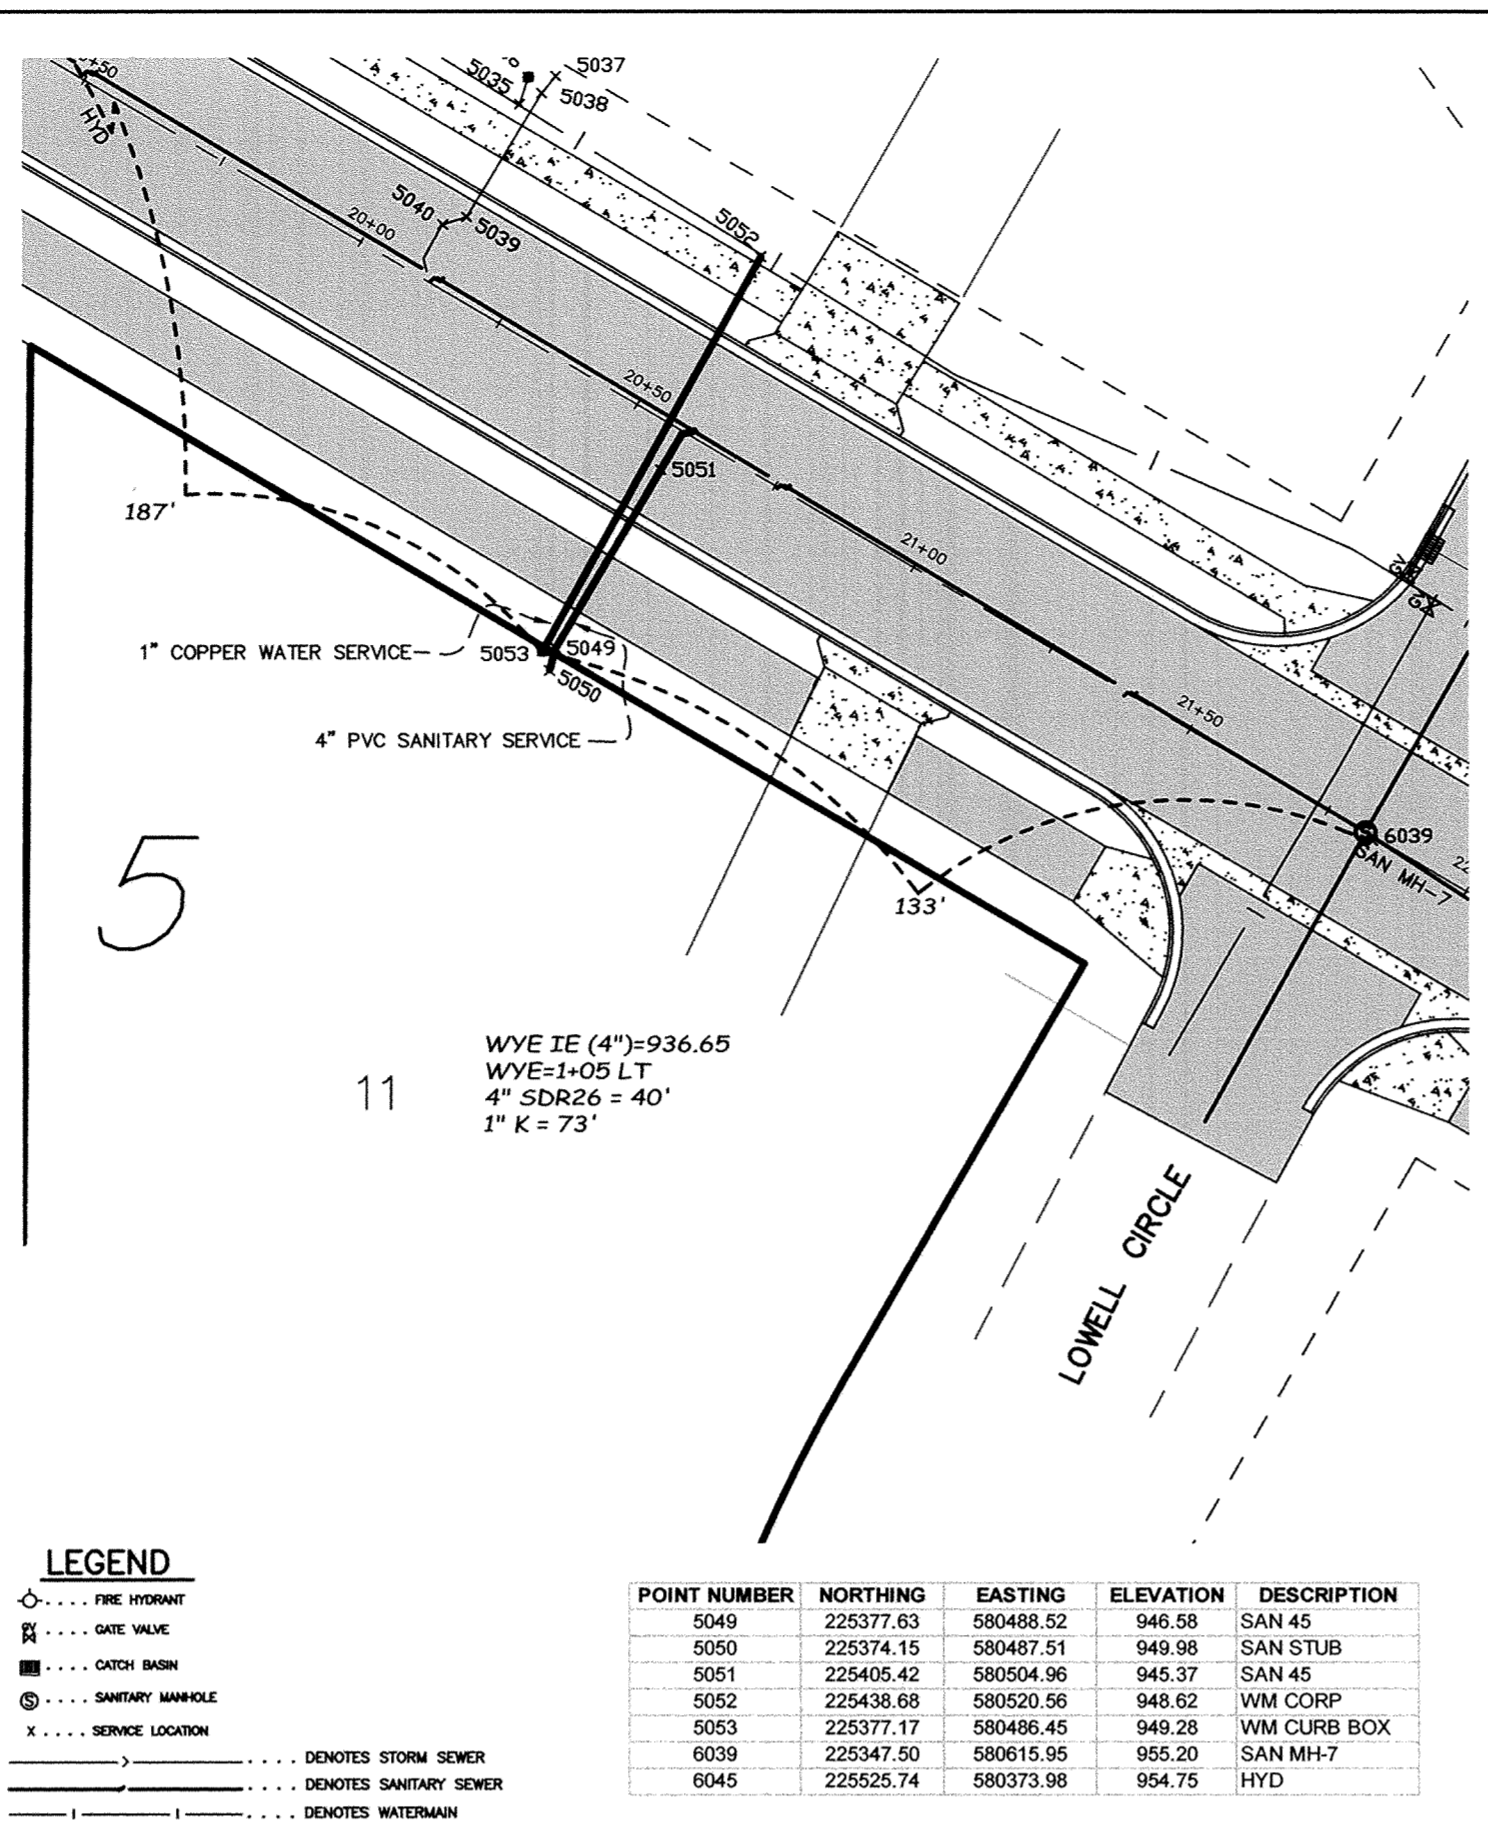


POINT NUMBER	NORTHING	EASTING	ELEVATION	DESCRIPTION
5049	225377.53	580488.52	948.58	SAN 45
5050	225374.15	580487.51	949.98	SAN STUB
5051	225405.42	580504.96	945.37	SAN 45
5052	225438.88	580520.56	948.62	WM CORP
5053	225377.17	580486.45	948.28	WM CURB BOX
6039	225347.50	580615.95	955.20	SAN MH-7
6045	225525.74	580373.98	954.75	HYD

SERVICE LOCATION
11900 HIGHLAND RD NW
CITY OF ELK RIVER
HIGHLAND ROAD

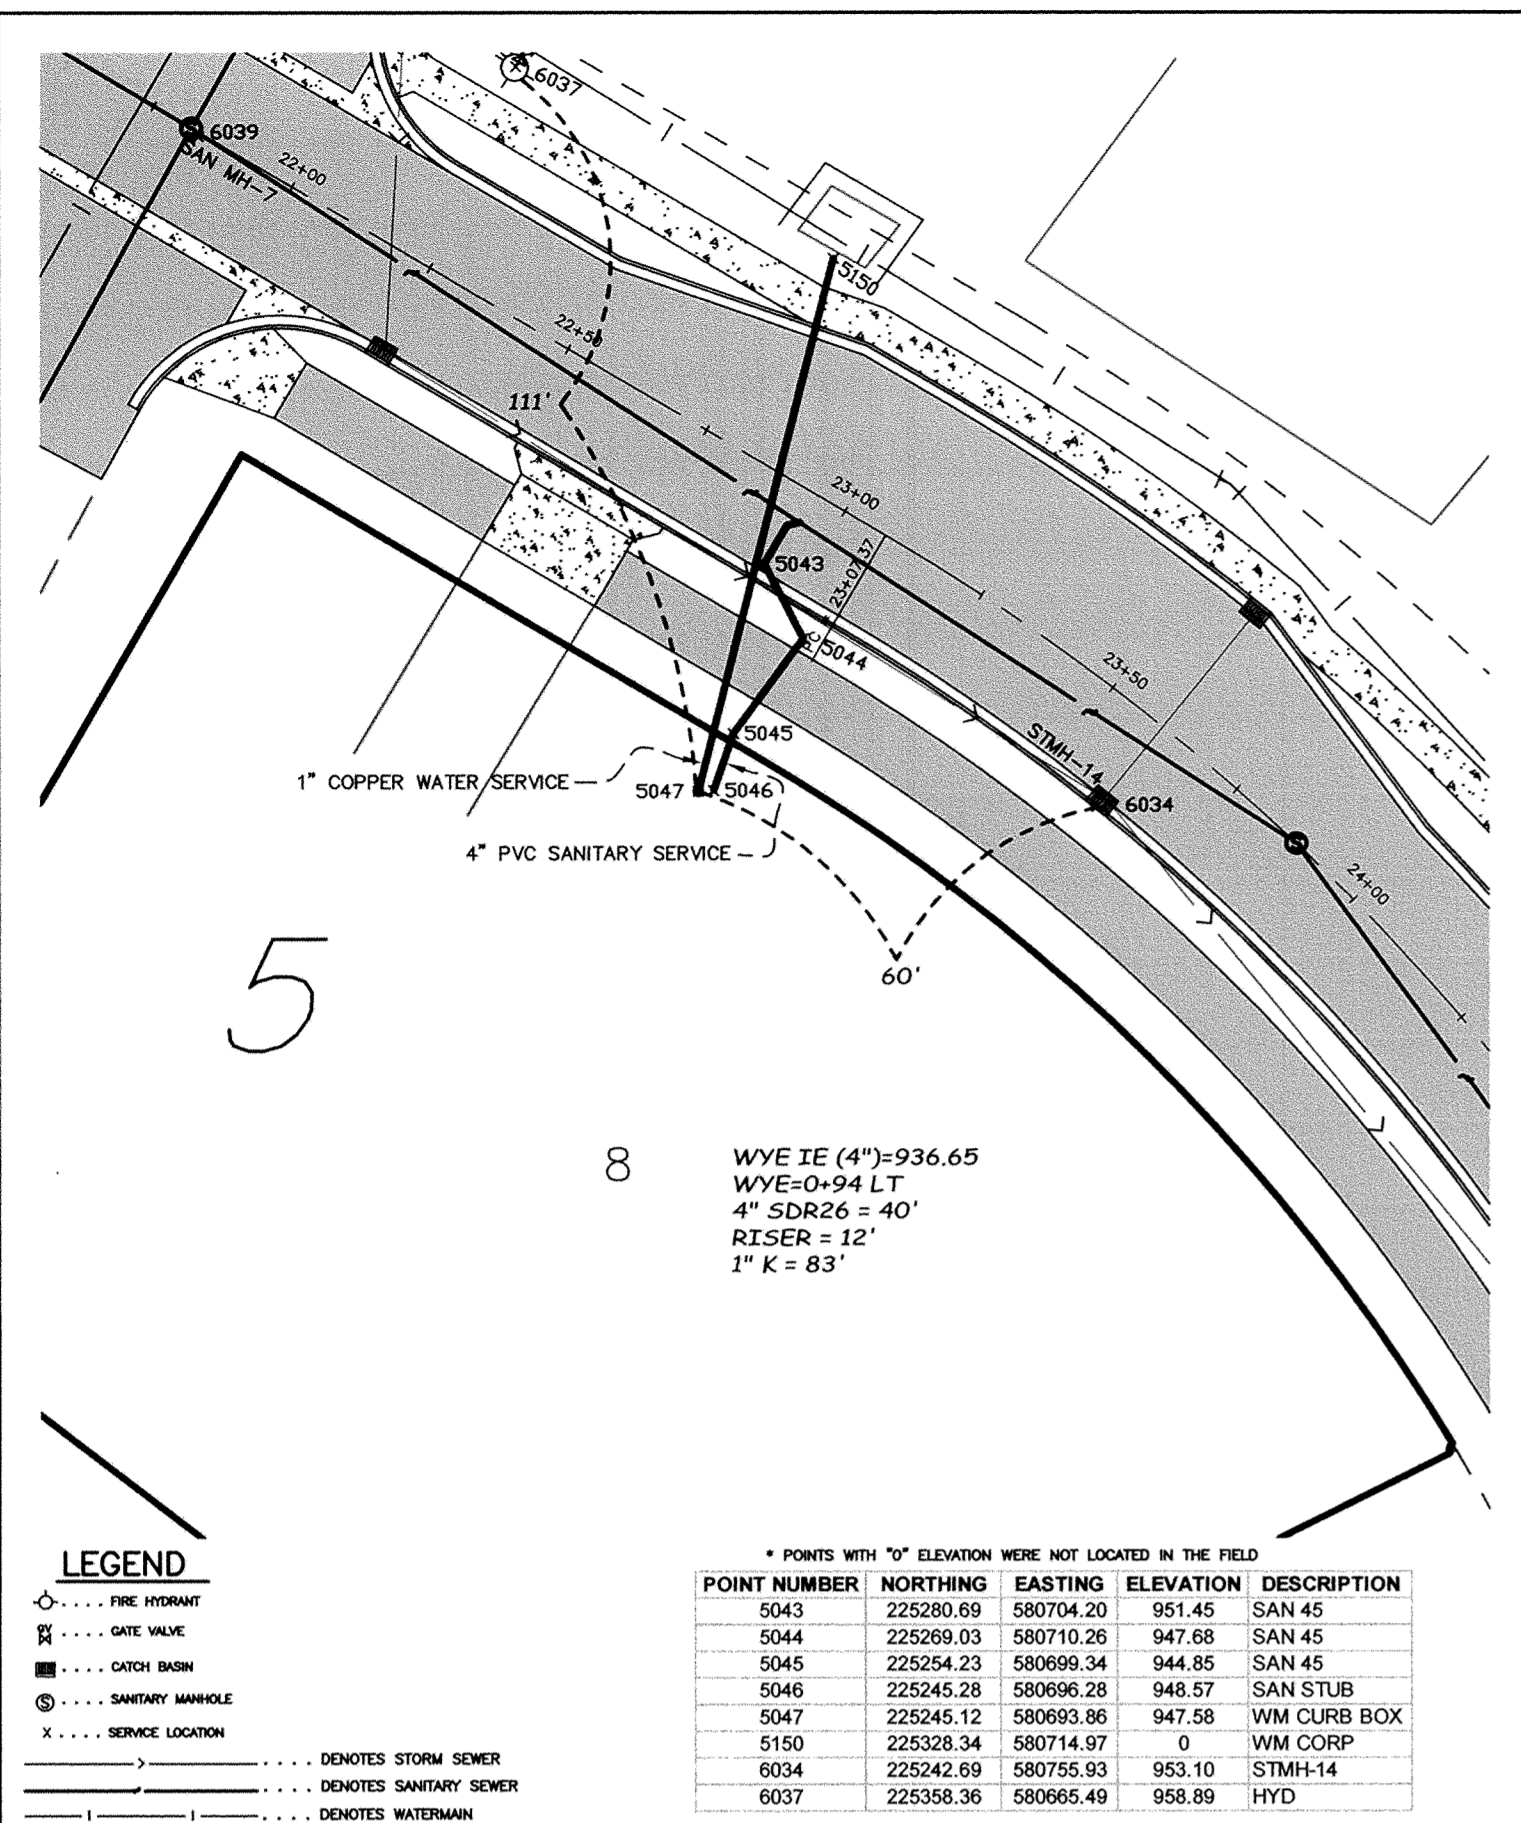


POINT NUMBER	NORTHING	EASTING	ELEVATION	DESCRIPTION
5043	225280.69	580704.20	951.45	SAN 45
5044	225289.03	580710.26	947.68	SAN 45
5045	225254.23	580699.34	944.85	SAN 45
5046	225245.28	580696.28	945.57	SAN STUB
5047	225245.12	580693.86	947.56	WM CURB BOX
5150	225328.34	580714.97	0	WM CORP
6034	225242.69	580755.93	953.10	STMH-14
6037	225358.36	580665.49	958.80	HYD

SERVICE LOCATION
11880 HIGHLAND RD NW
CITY OF ELK RIVER
HIGHLAND ROAD

 


POINT NUMBER	NORTHING	EASTING	ELEVATION	DESCRIPTION
5068	225839.70	580067.75	946.75	WM CORP
5069	225818.65	580049.16	942.01	SAN 45
5070	225804.82	580025.64	942.30	SAN 45
6071	225803.26	580022.77	945.35	SAN STUB
5072	225808.33	580022.84	944.33	WM CURB BOX
5155	225830.91	580052.42	0	SAN 45
6061	225817.02	580100.74	957.62	HYD
6063	225878.79	580008.90	952.93	STMH-24

SERVICE LOCATION
12008 HIGHLAND RD NW
CITY OF ELK RIVER
HIGHLAND ROAD

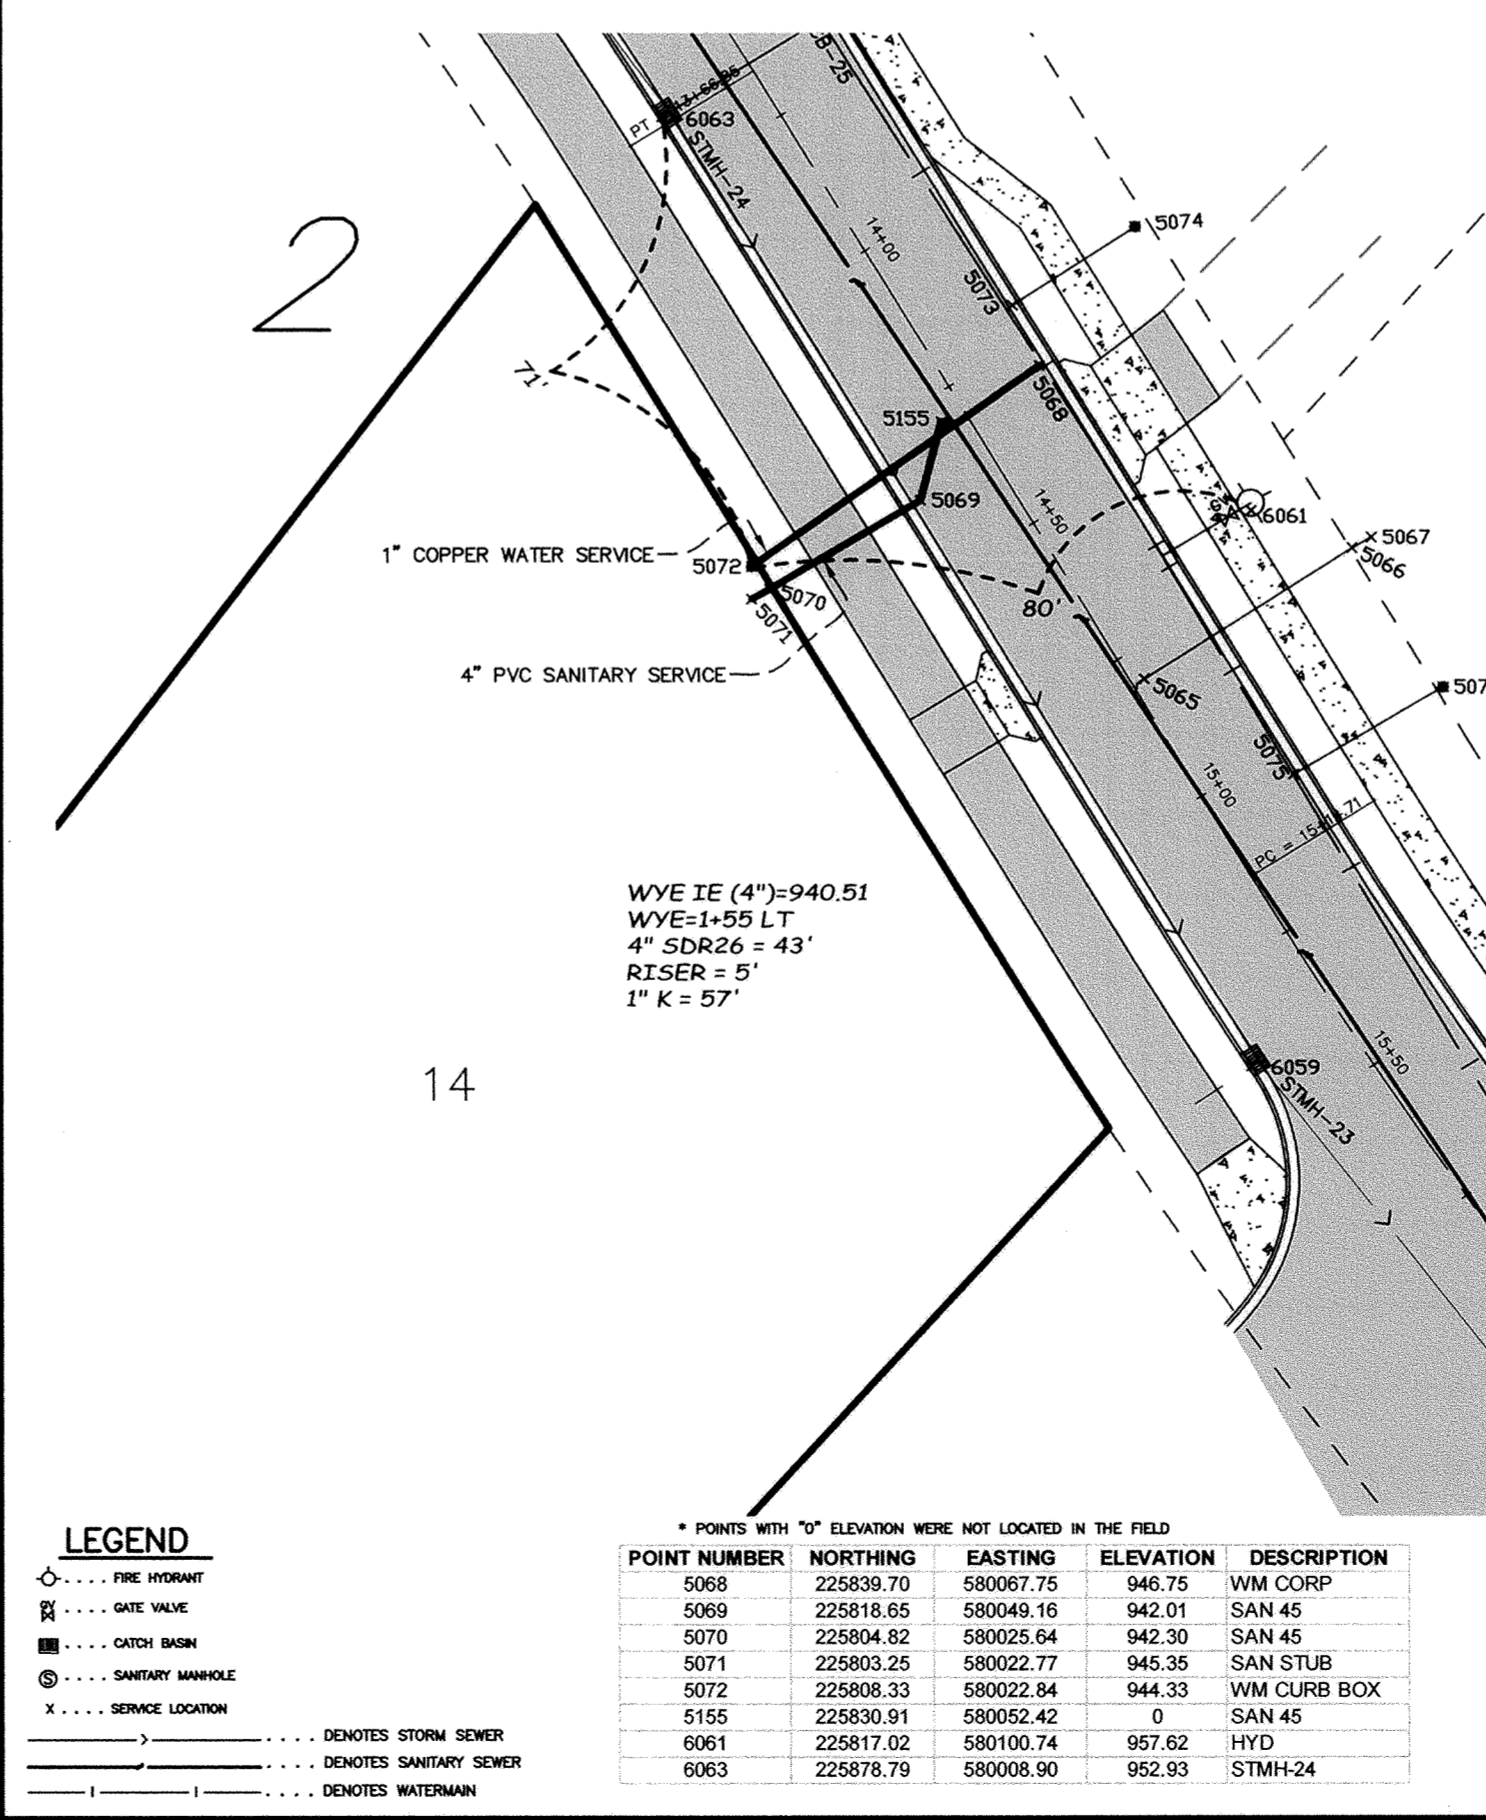


POINT NUMBER	NORTHING	EASTING	ELEVATION	DESCRIPTION
5065	225790.82	580084.02	943.30	SAN 45
5066	225811.20	580116.41	946.63	SAN 45
5067	225812.85	580119.43	950.20	SAN STUB
5075	225775.97	580107.32	946.45	WM CORP
5076	225789.58	580130.59	949.41	WM CURB BOX
6059	225730.11	580100.76	953.60	STMH-23
6061	225817.02	580100.74	957.62	HYD

SERVICE LOCATION
12011 HIGHLAND RD NW
CITY OF ELK RIVER
HIGHLAND ROAD

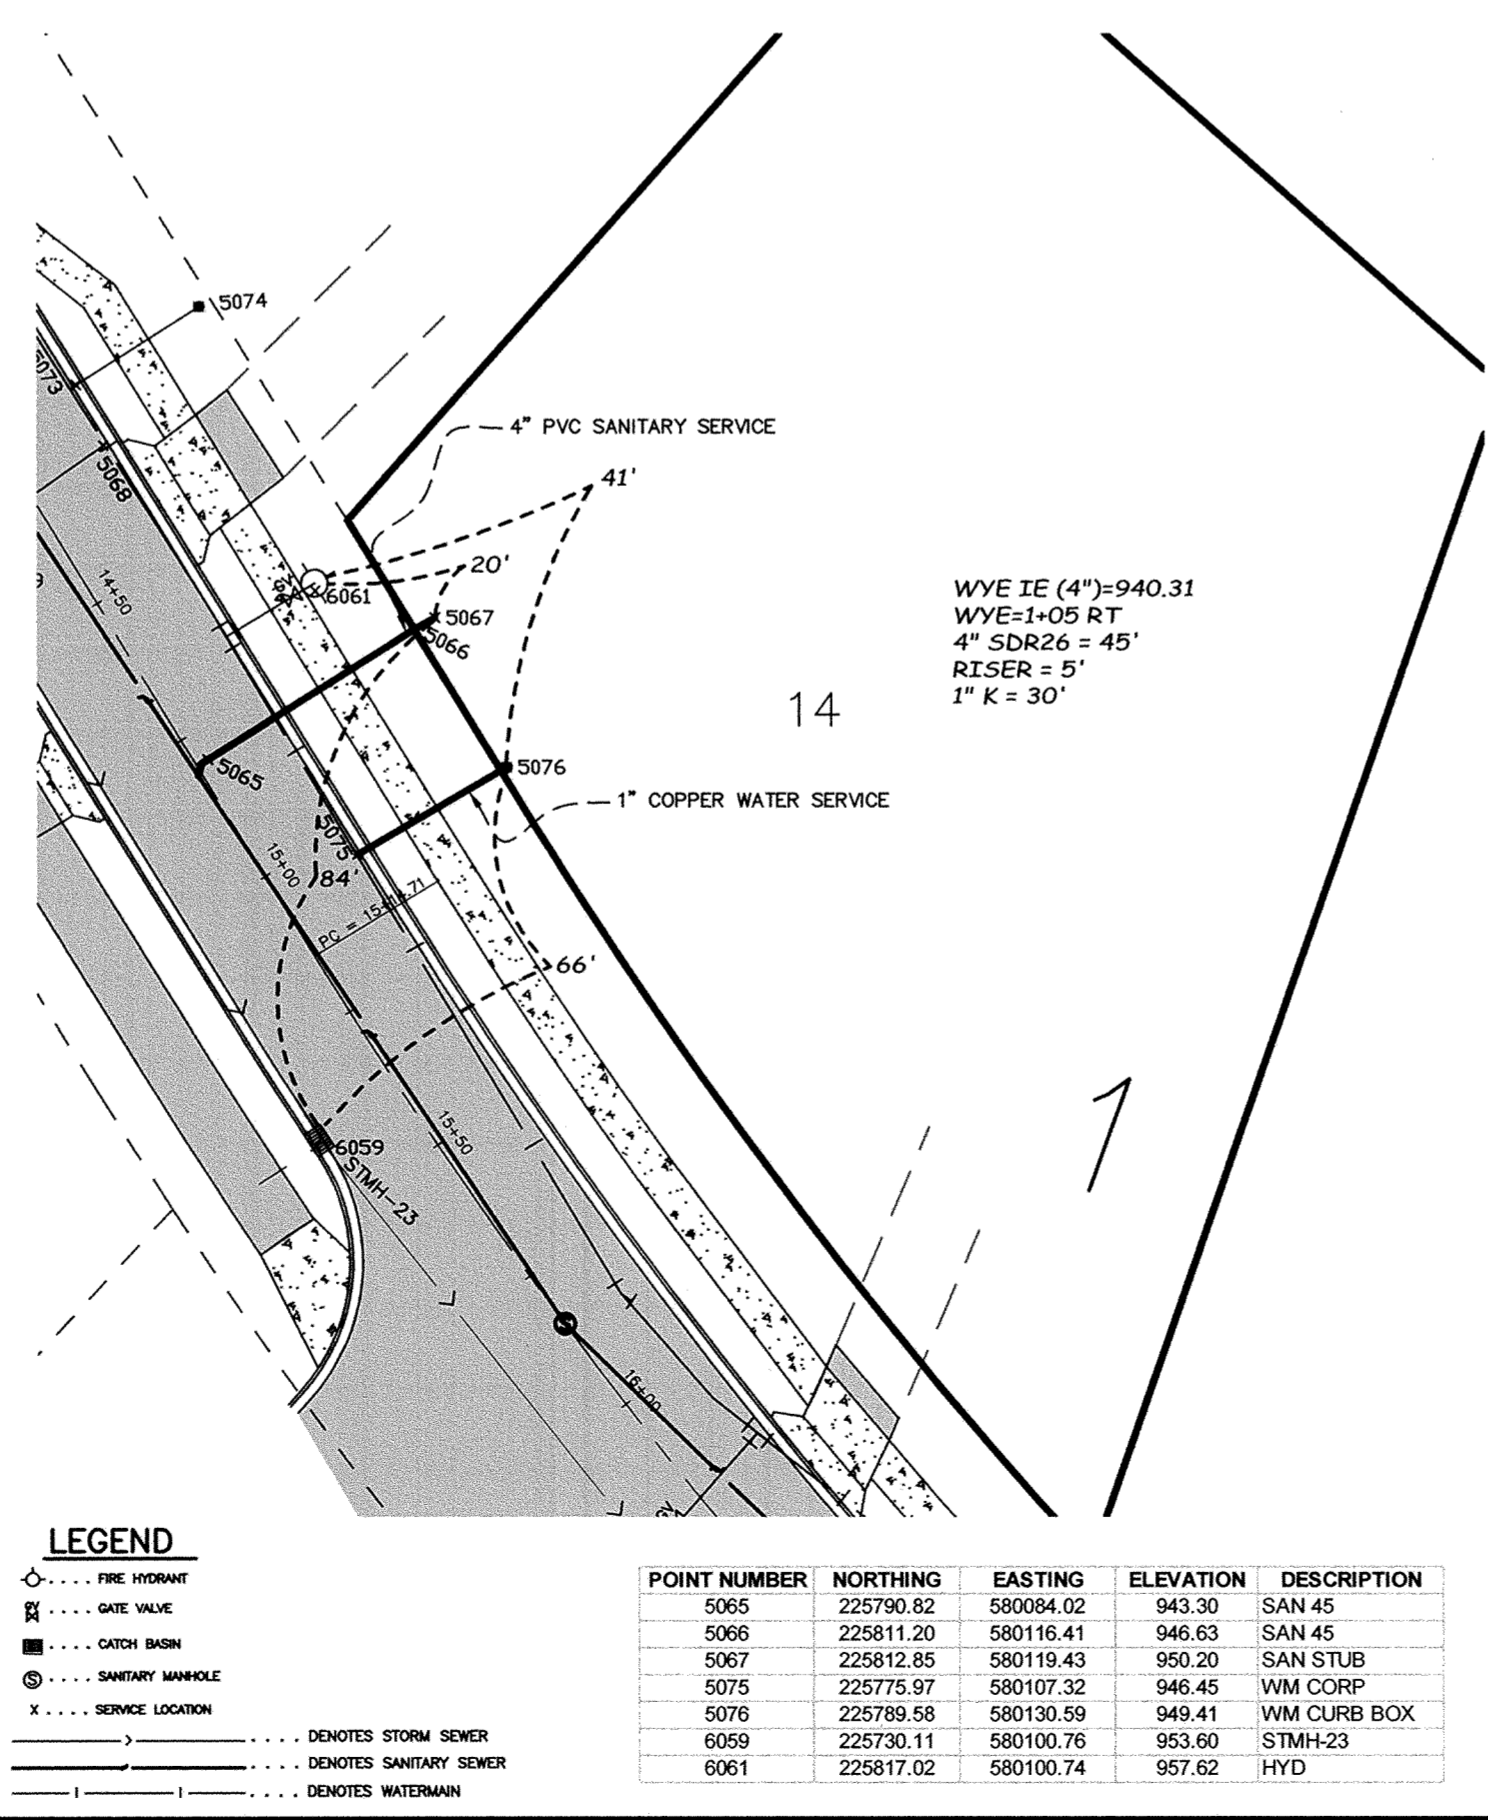

POINT NUMBER	NORTHING	EASTING	ELEVATION	DESCRIPTION
5060	225606.85	580268.06	943.53	WM CORP
5061	225595.12	580252.78	941.62	SAN 45
5062	225609.29	580276.43	942.16	SAN 45
5063	225610.65	580276.93	944.79	SAN STUB
5064	225613.31	580273.07	945.11	WM CURB BOX
6052	225593.07	580309.51	950.26	CB B-HIVE
6054	225542.24	580271.57	950.78	STMH-19

SERVICE LOCATION
11955 HIGHLAND RD NW
CITY OF ELK RIVER
HIGHLAND ROAD

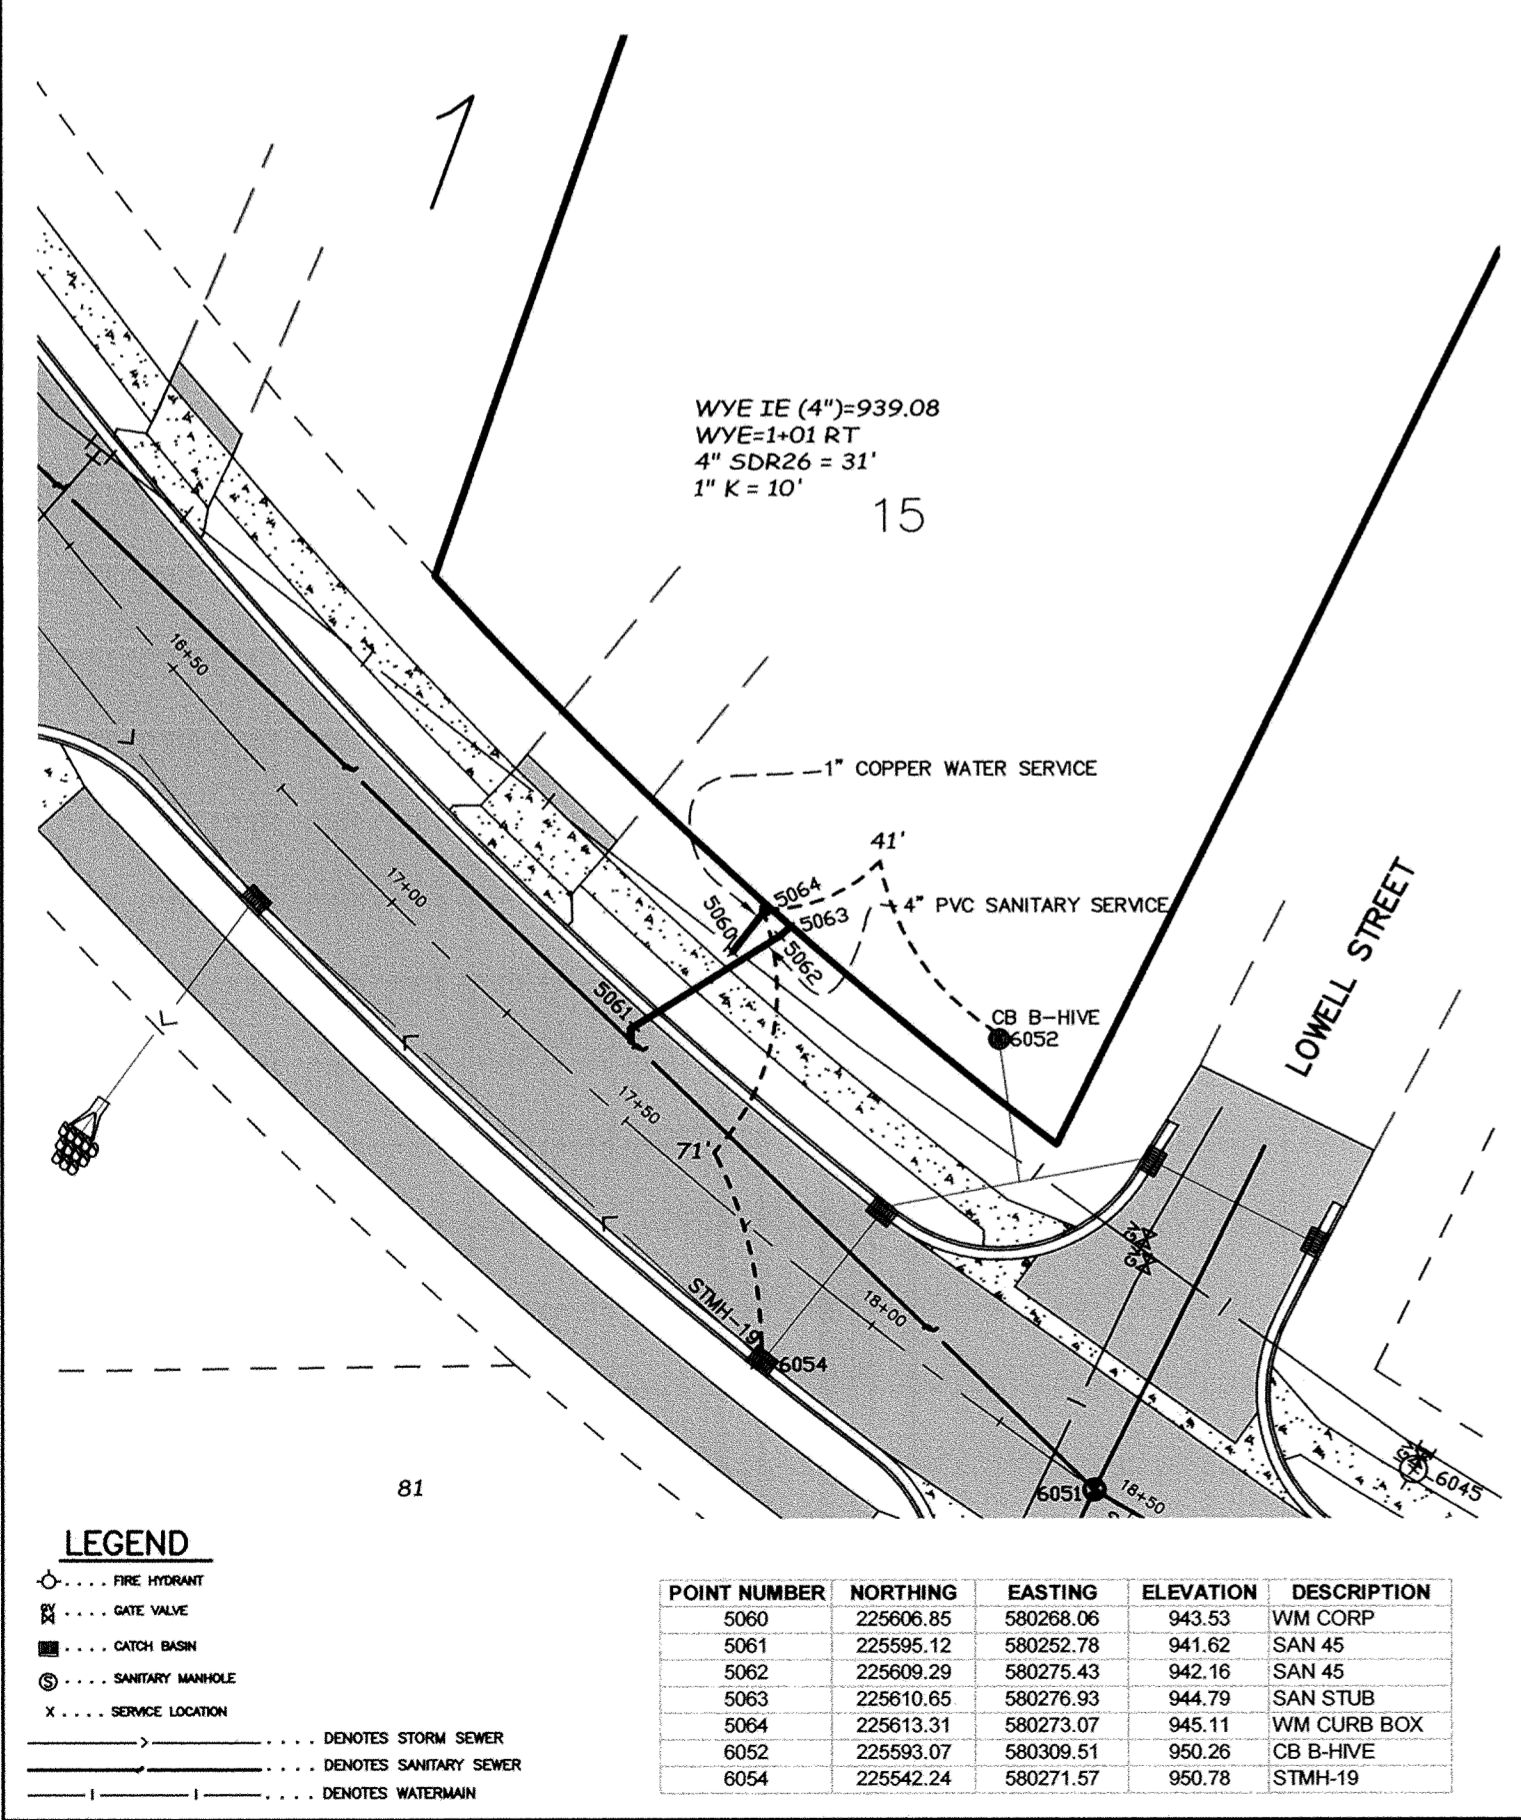

SERVICE LOCATION
11955 HIGHLAND RD NW
CITY OF ELK RIVER
HIGHLAND ROAD

