




**SERVICE LOCATION**  
**19377 NORFOLK ST NW**  
CITY OF ELK RIVER  
HIGHLAND ROAD

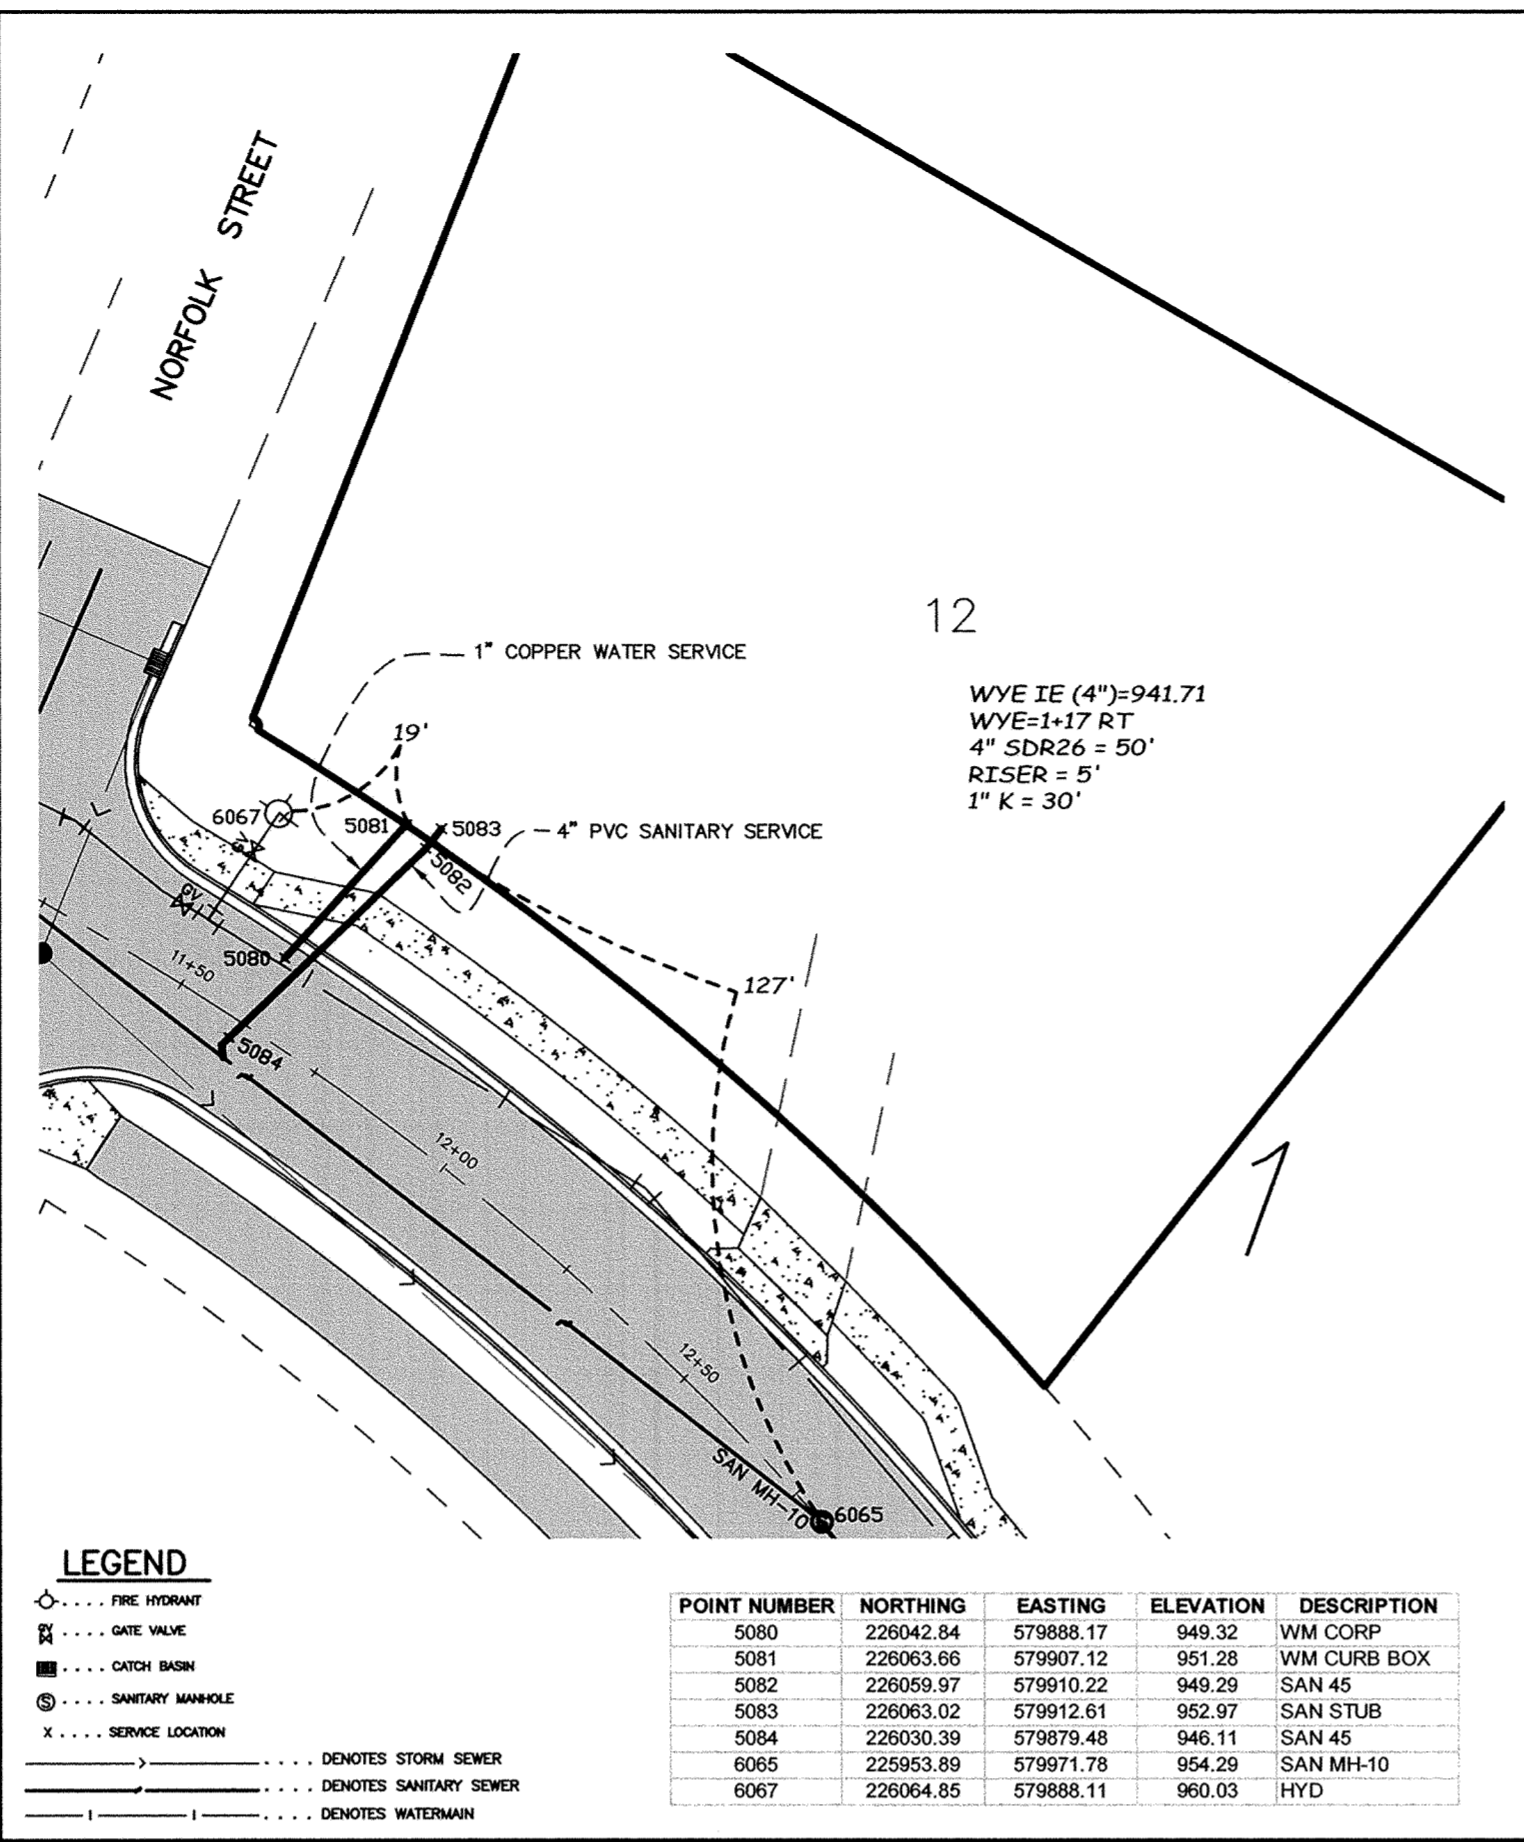


**SERVICE LOCATION**  
**12029 HIGHLAND RD NW**  
CITY OF ELK RIVER  
HIGHLAND ROAD

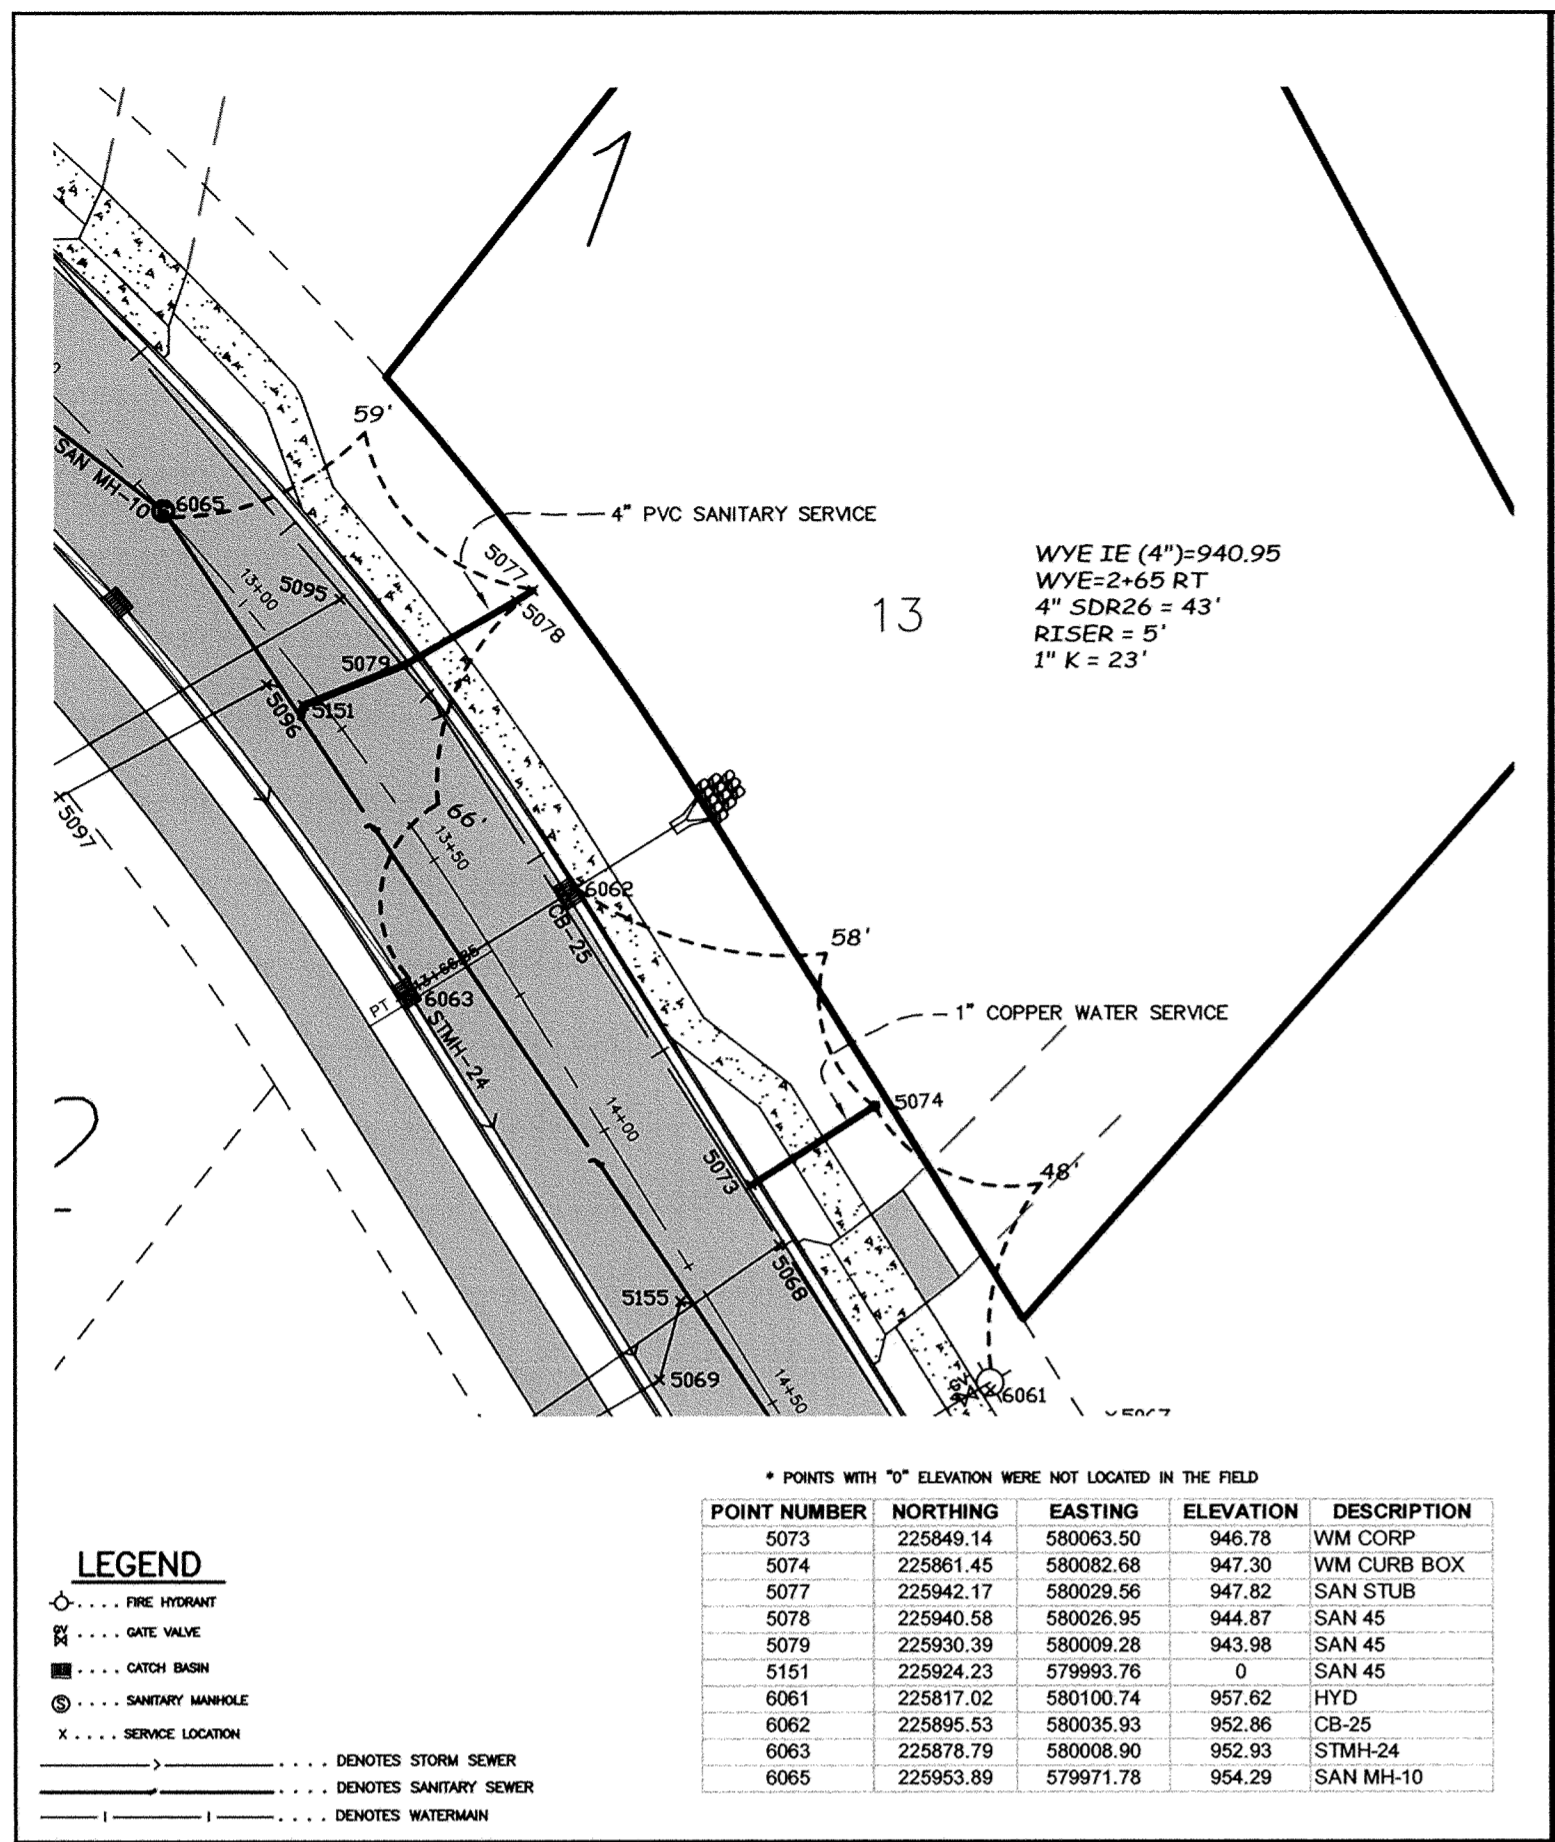


**SERVICE LOCATION**  
**12001 HIGHLAND RD NW**  
CITY OF ELK RIVER  
HIGHLAND ROAD

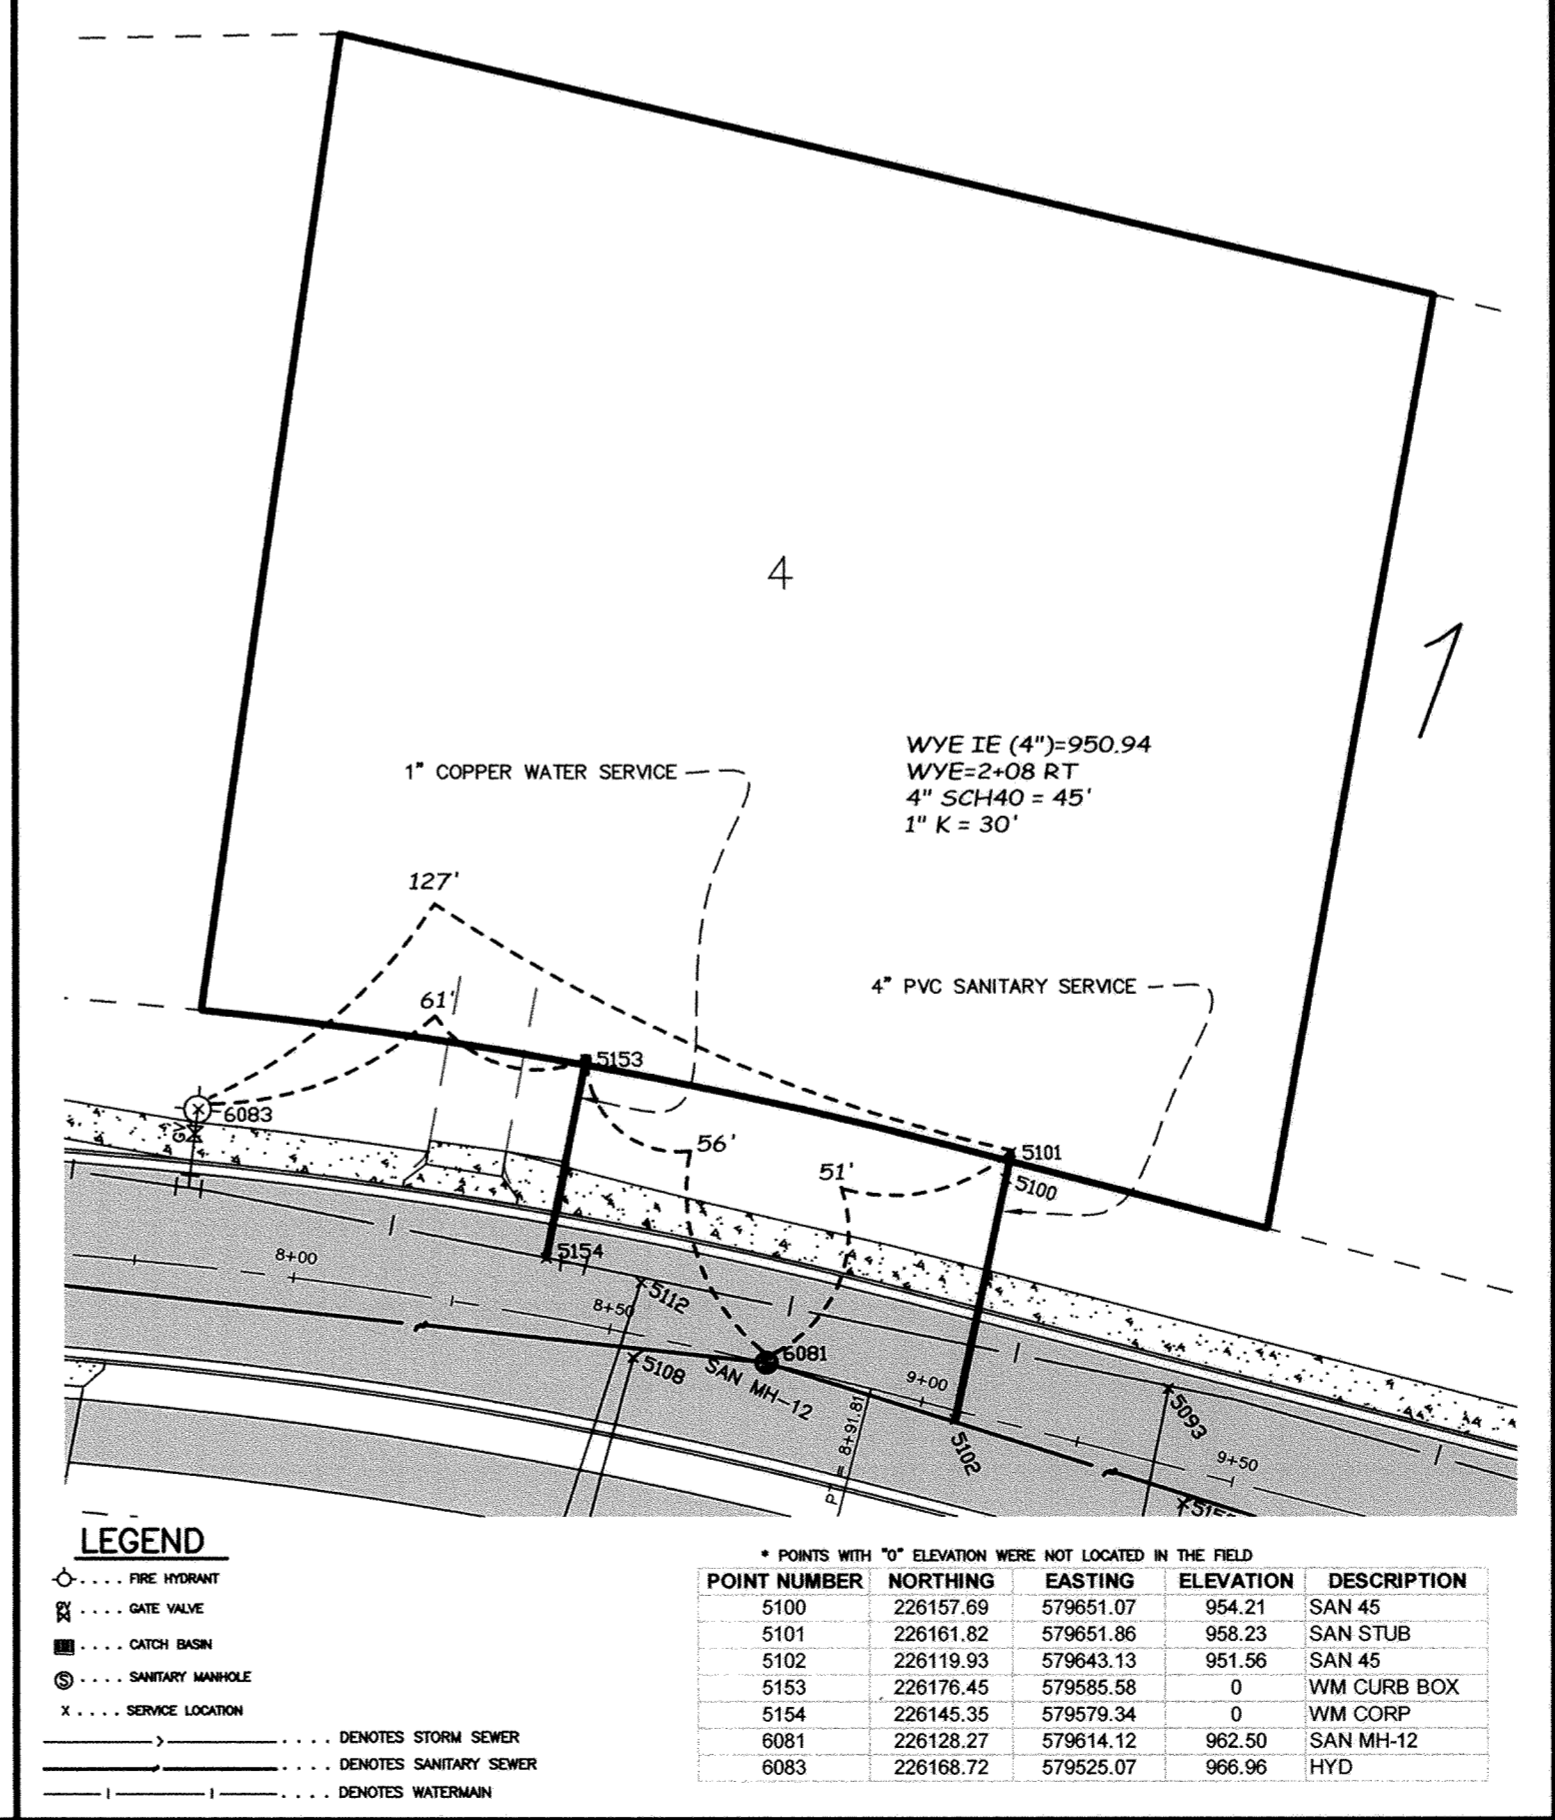


**SERVICE LOCATION**  
**12065 HIGHLAND RD NW**  
CITY OF ELK RIVER  
HIGHLAND ROAD

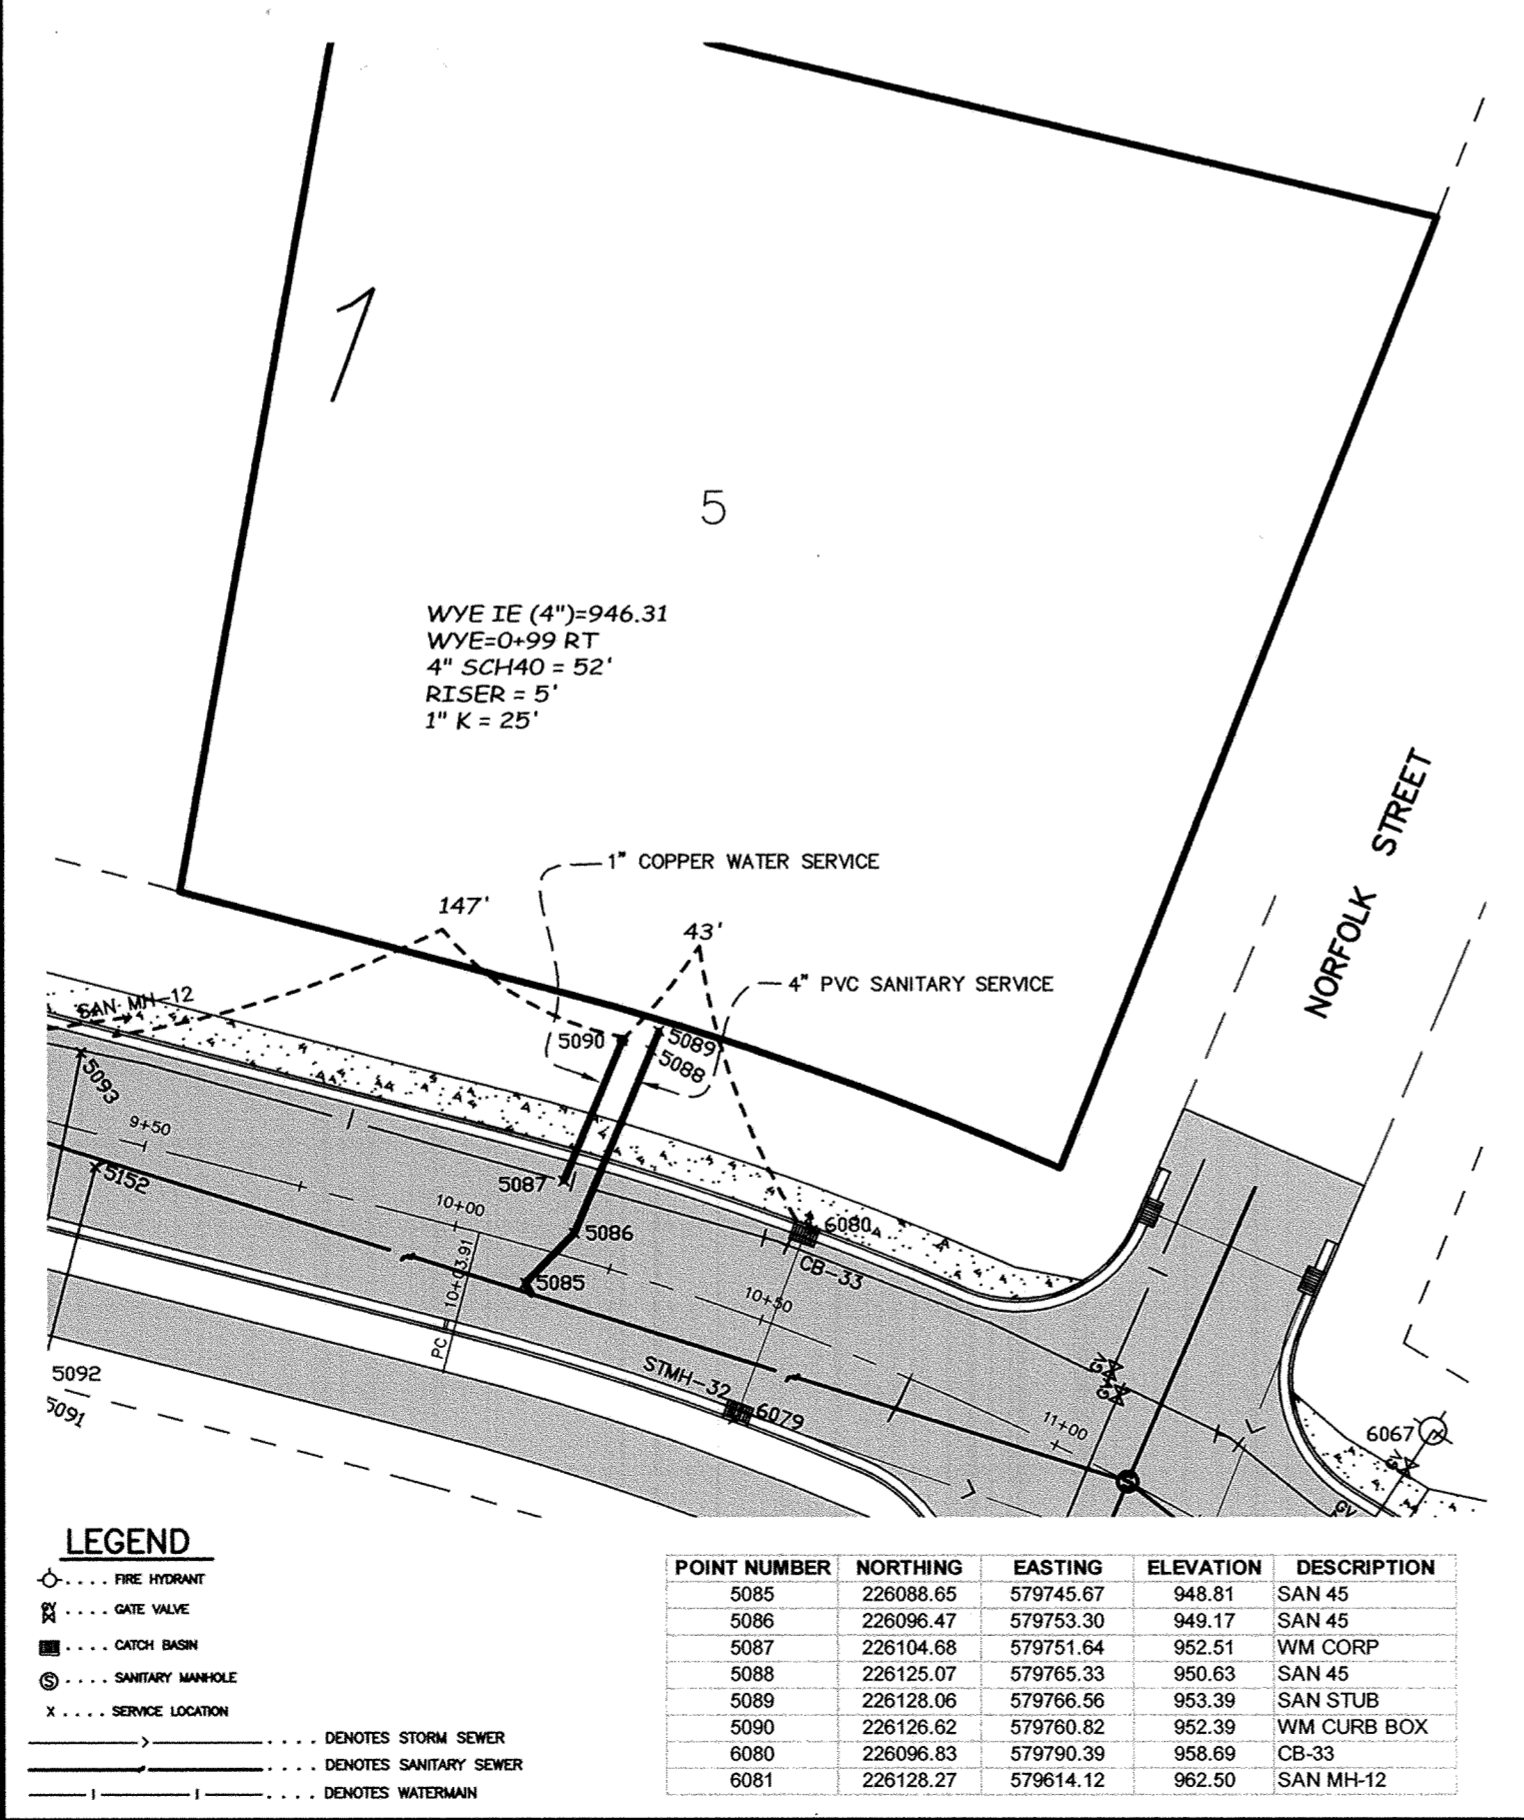


**SERVICE LOCATION**  
**19404 NORFOLK ST NW**  
CITY OF ELK RIVER  
HIGHLAND ROAD

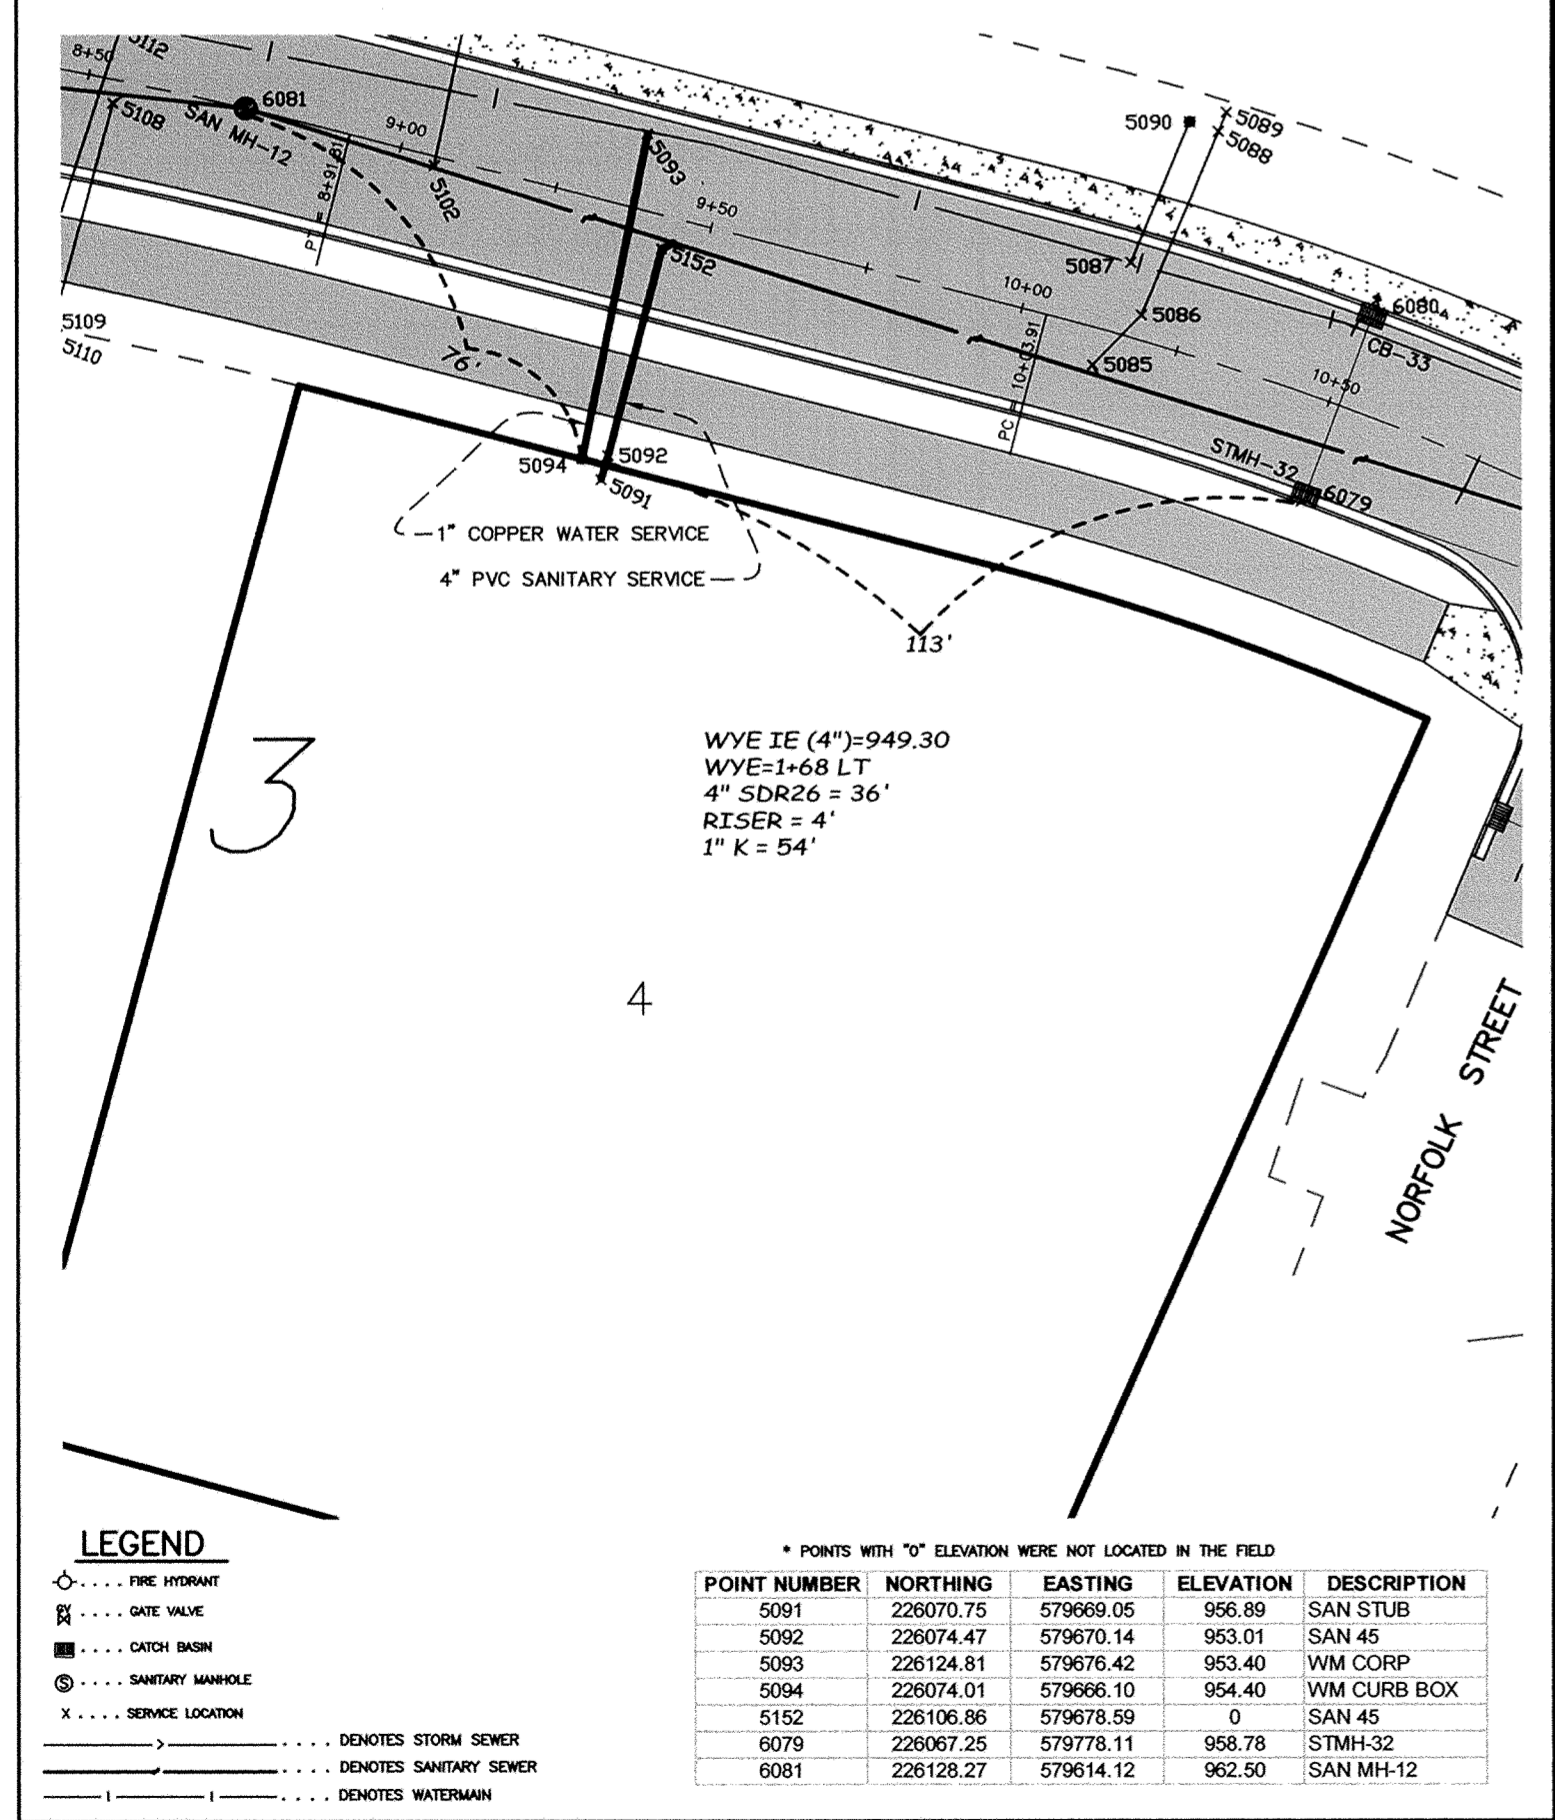


**SERVICE LOCATION**  
**13660 NORFOLK ST NW**  
CITY OF ELK RIVER  
HIGHLAND ROAD

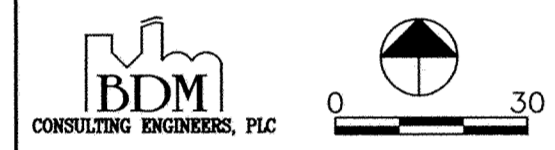


**SERVICE LOCATION**  
**12001 HIGHLAND RD NW**  
CITY OF ELK RIVER  
HIGHLAND ROAD

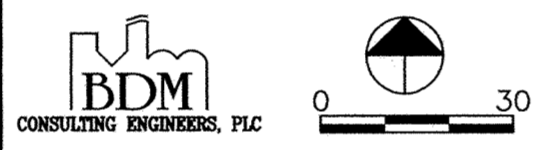

**SERVICE LOCATION**  
**12029 HIGHLAND RD NW**  
CITY OF ELK RIVER  
HIGHLAND ROAD

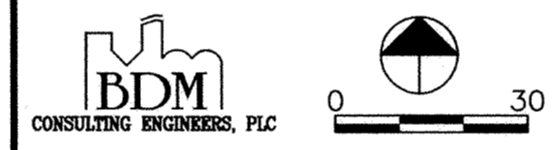

**SERVICE LOCATION**  
**19377 NORFOLK ST NW**  
CITY OF ELK RIVER  
HIGHLAND ROAD

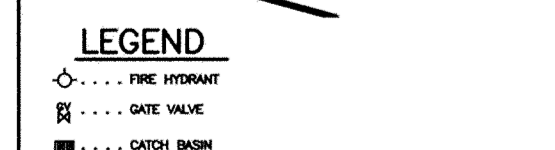

**SERVICE LOCATION**  
**13660 NORFOLK ST NW**  
CITY OF ELK RIVER  
HIGHLAND ROAD



**SERVICE LOCATION**  
**19404 NORFOLK ST NW**  
CITY OF ELK RIVER  
HIGHLAND ROAD



**SERVICE LOCATION**  
**12065 HIGHLAND RD NW**  
CITY OF ELK RIVER  
HIGHLAND ROAD