




SERVICE LOCATION
12125 HIGHLAND RD NW
CITY OF ELK RIVER
HIGHLAND ROAD

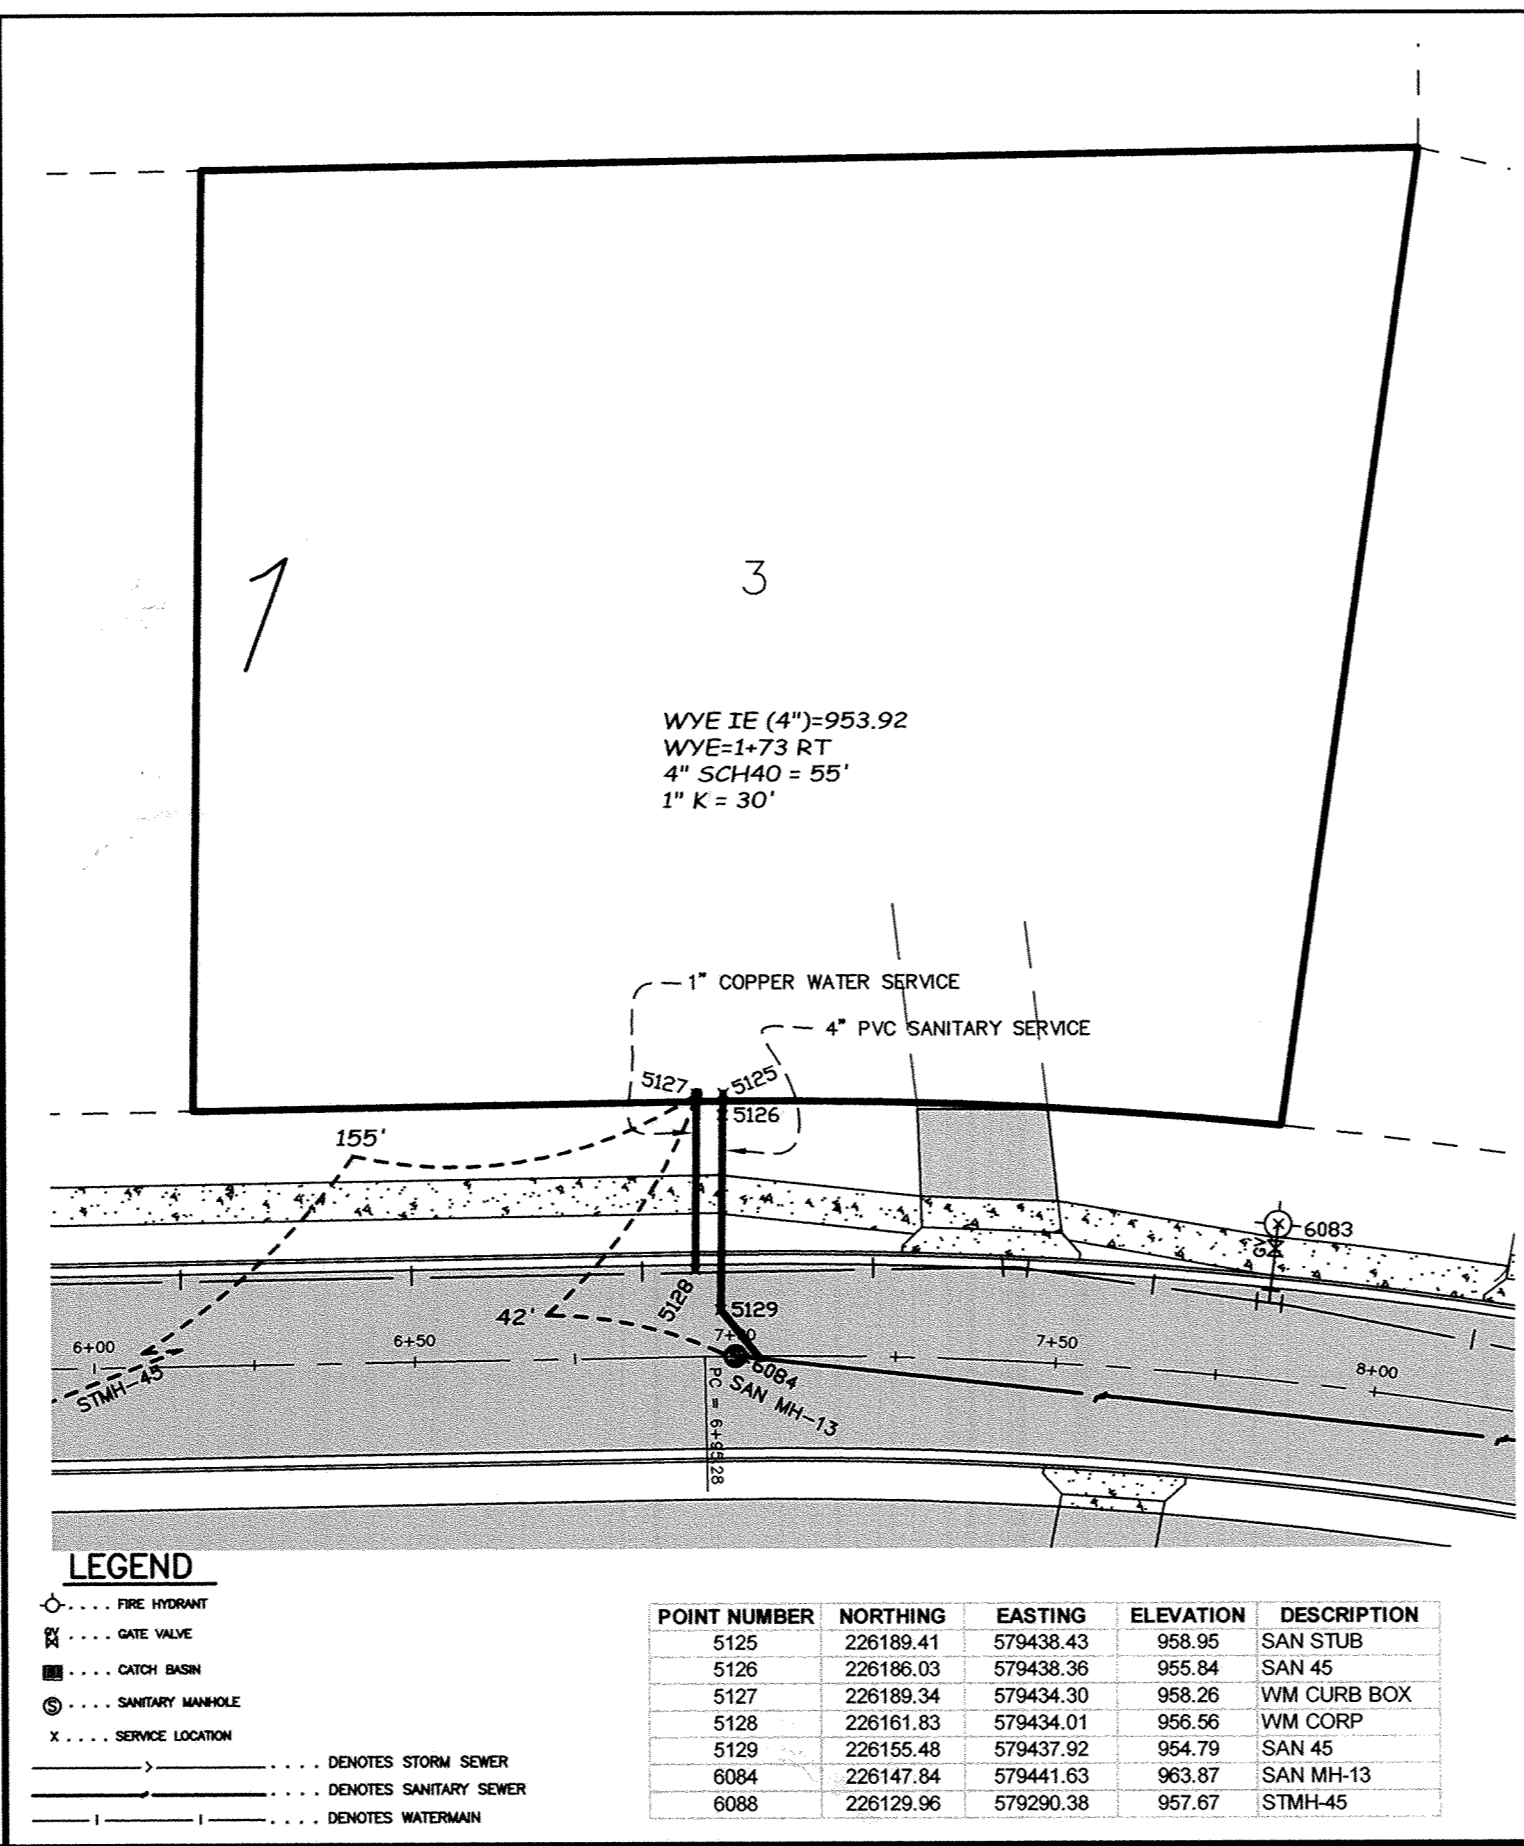


SERVICE LOCATION
12095 HIGHLAND RD NW
CITY OF ELK RIVER
HIGHLAND ROAD

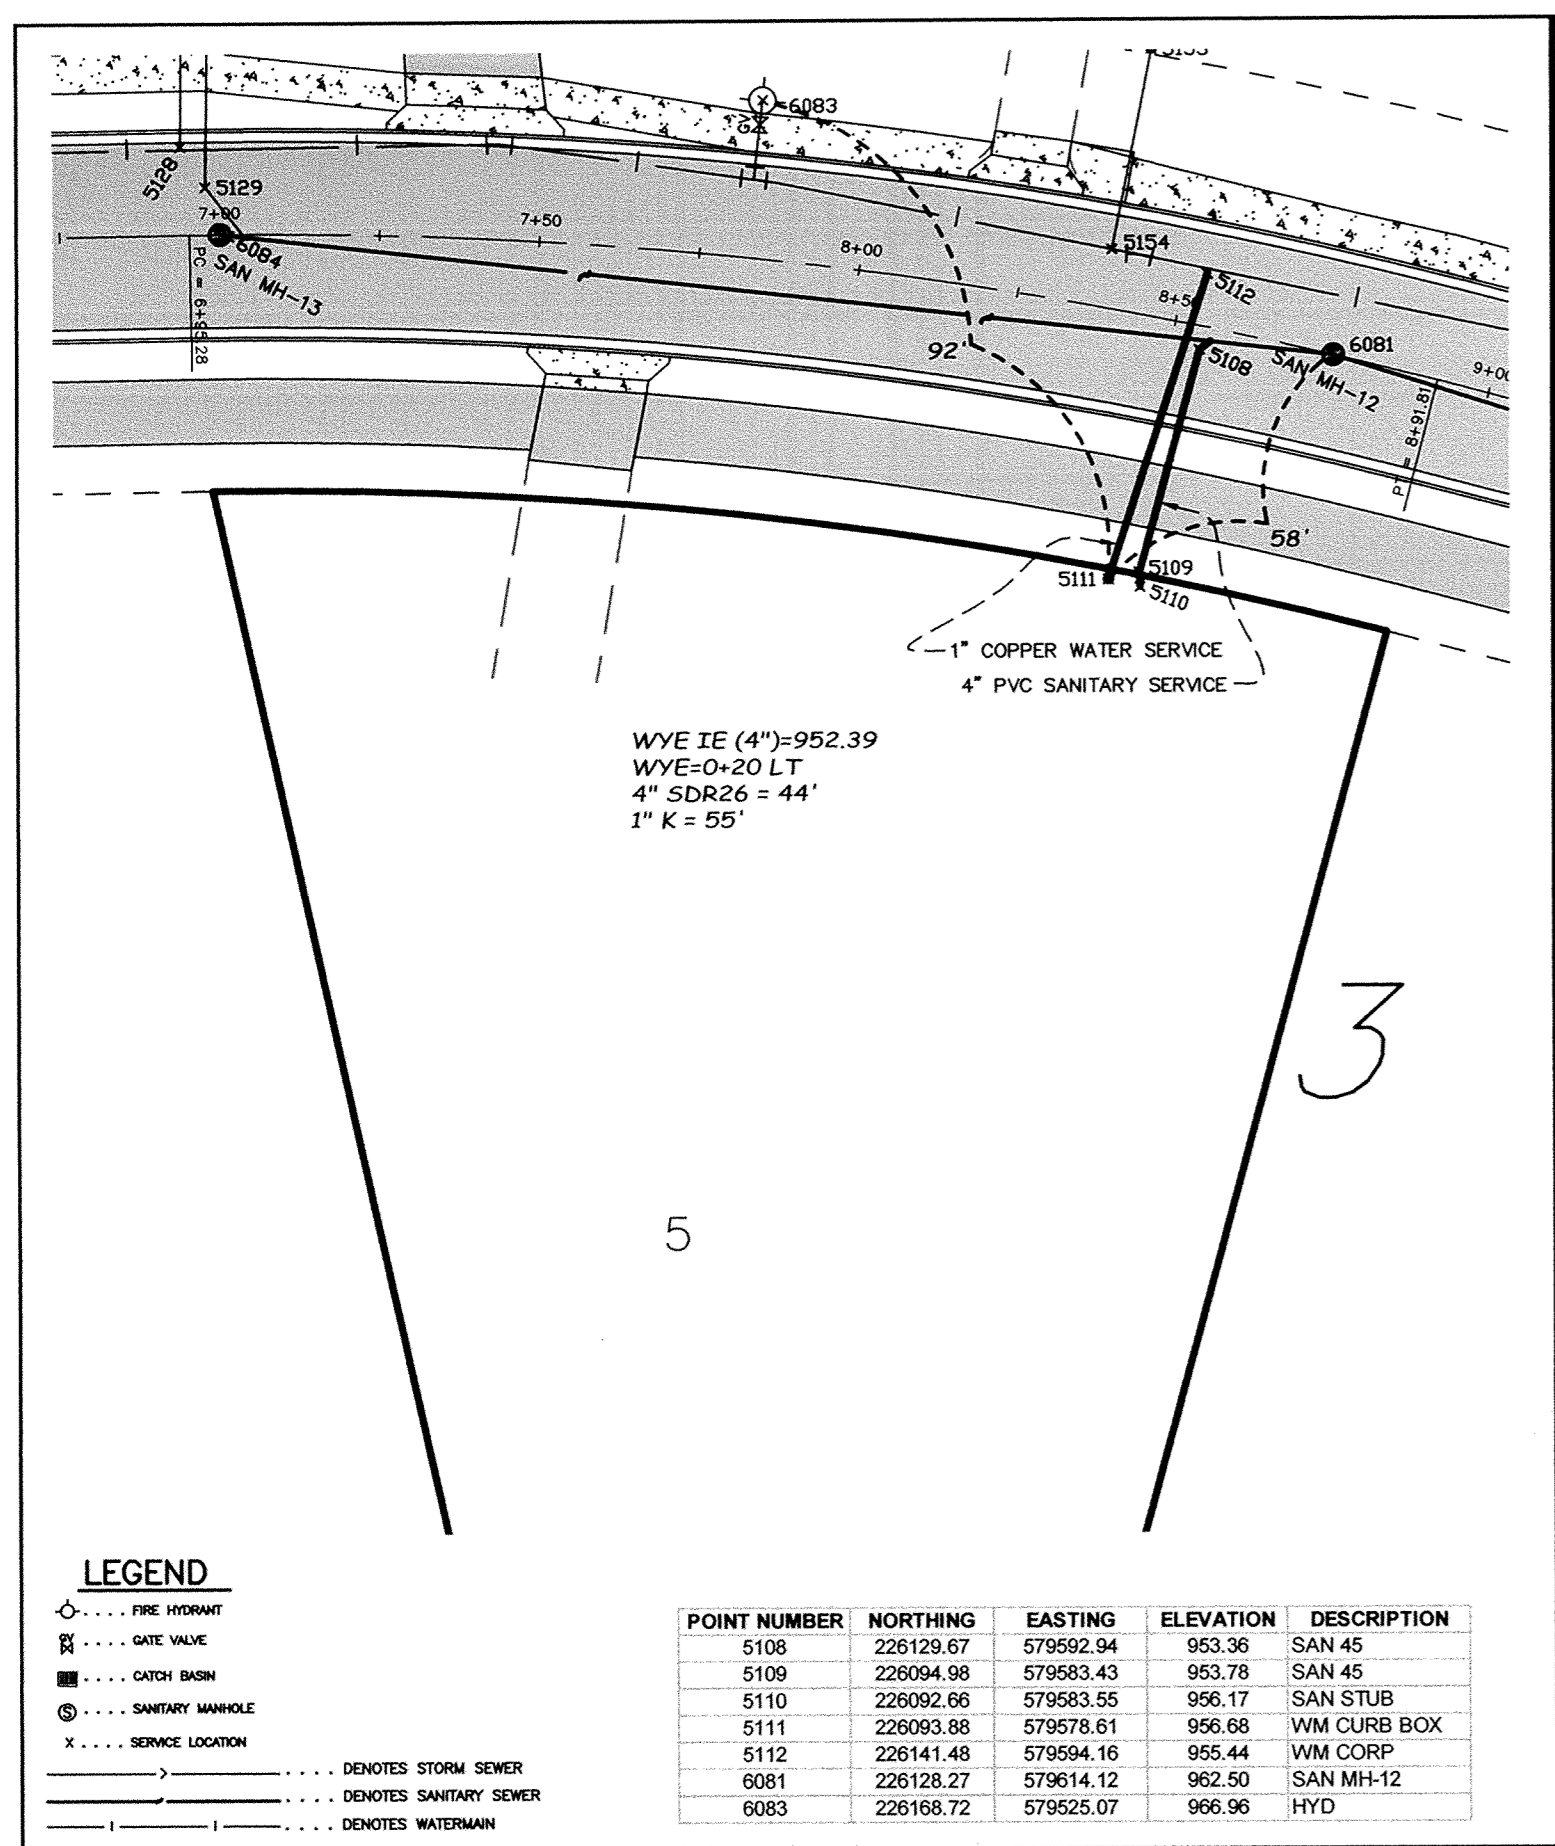


SERVICE LOCATION
12076 HIGHLAND RD NW
CITY OF ELK RIVER
HIGHLAND ROAD

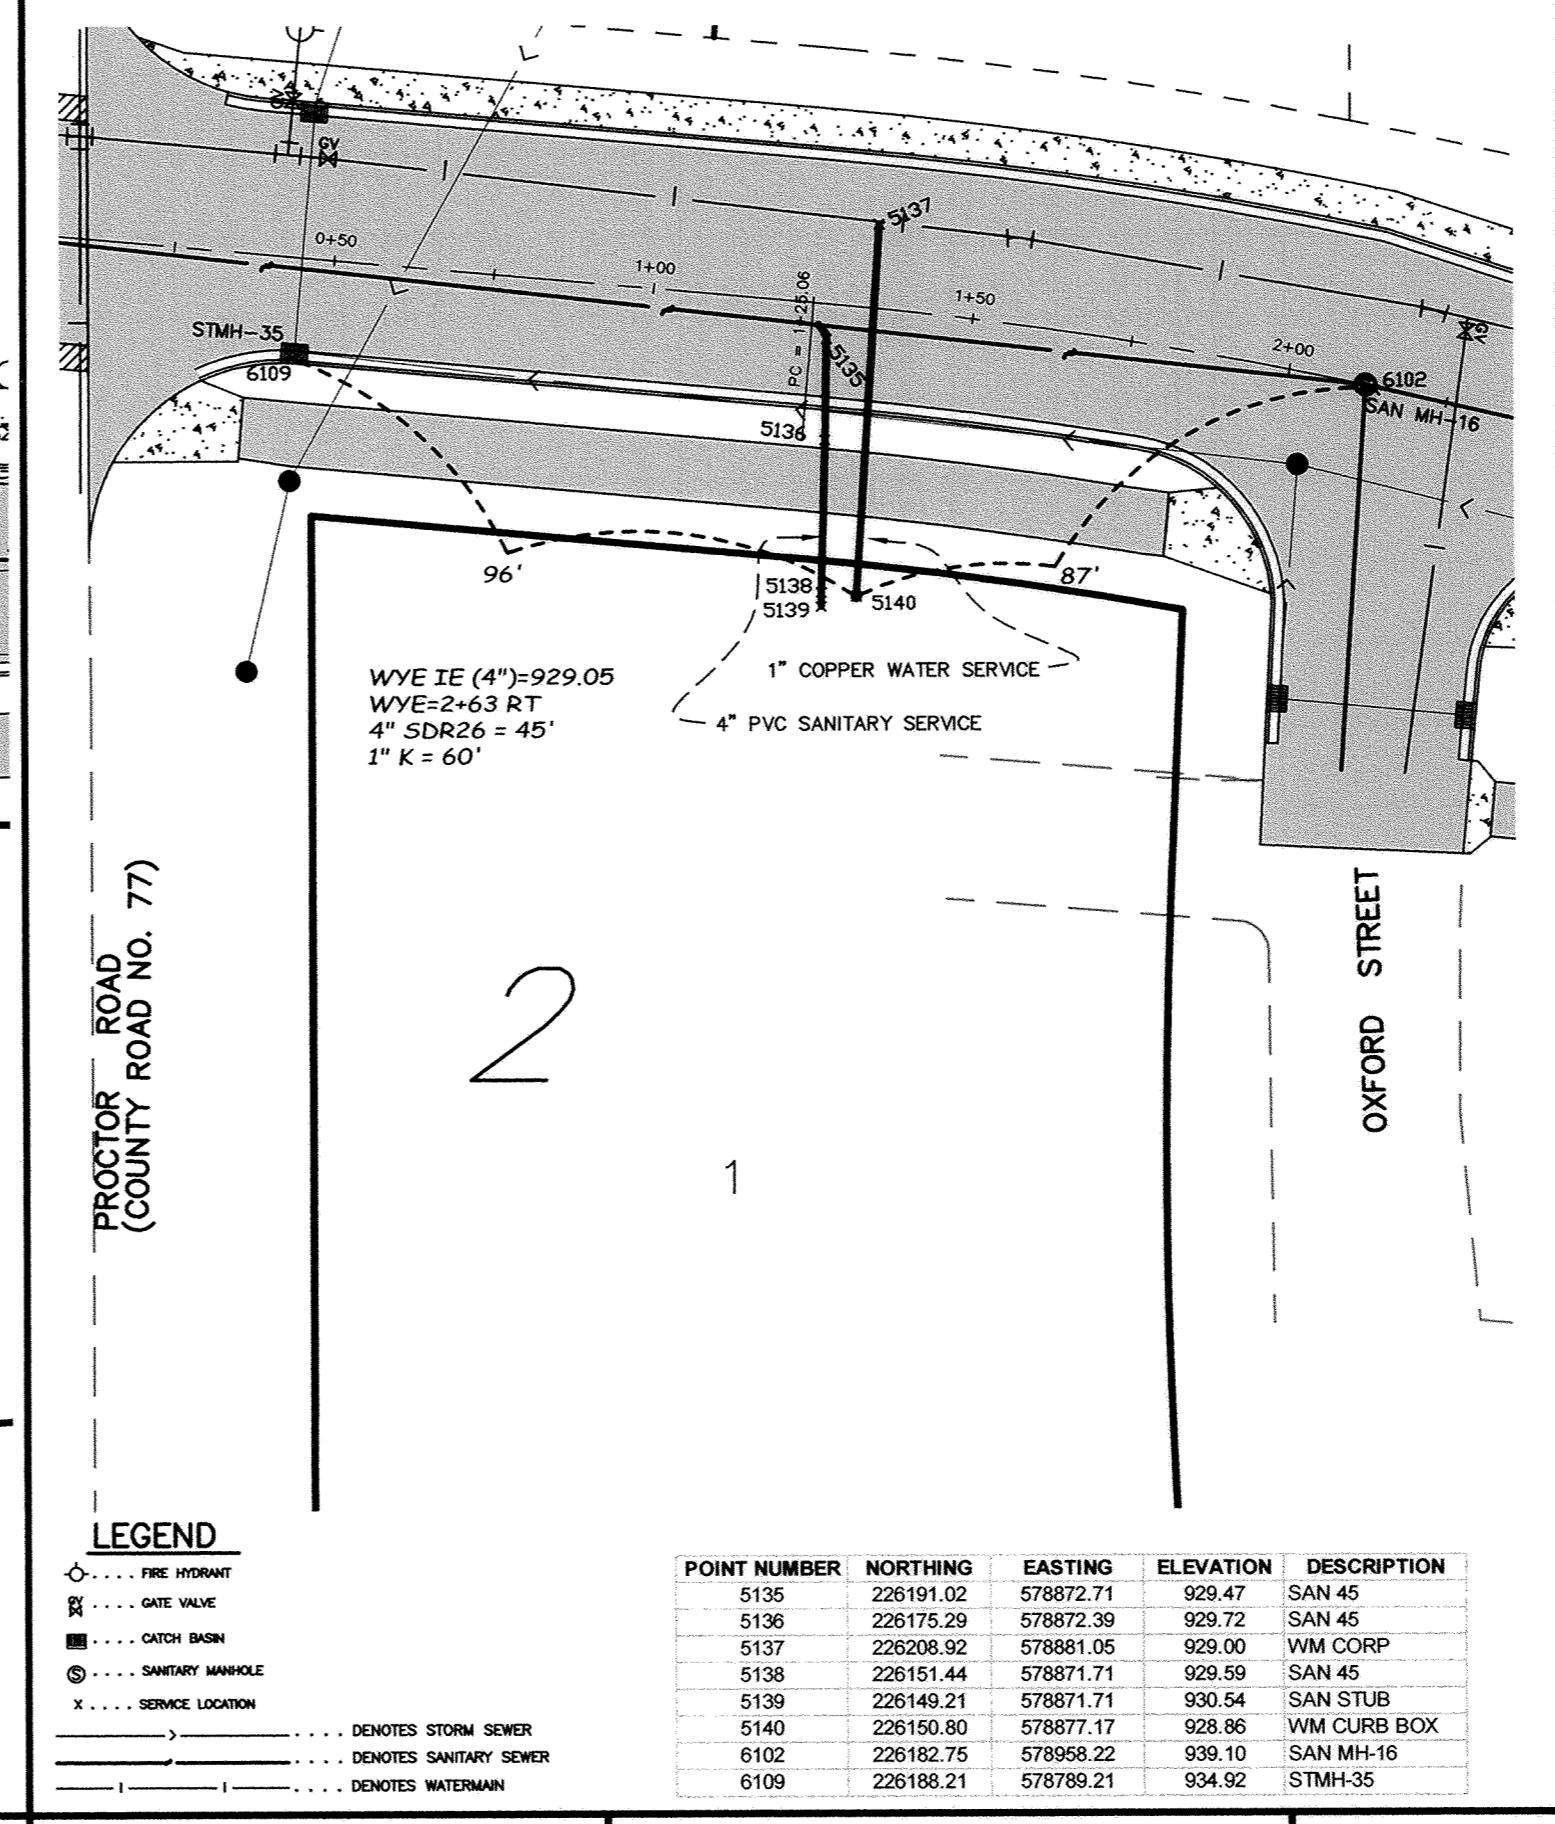

SERVICE LOCATION
19388 OXFORD ST NW
CITY OF ELK RIVER
HIGHLAND ROAD

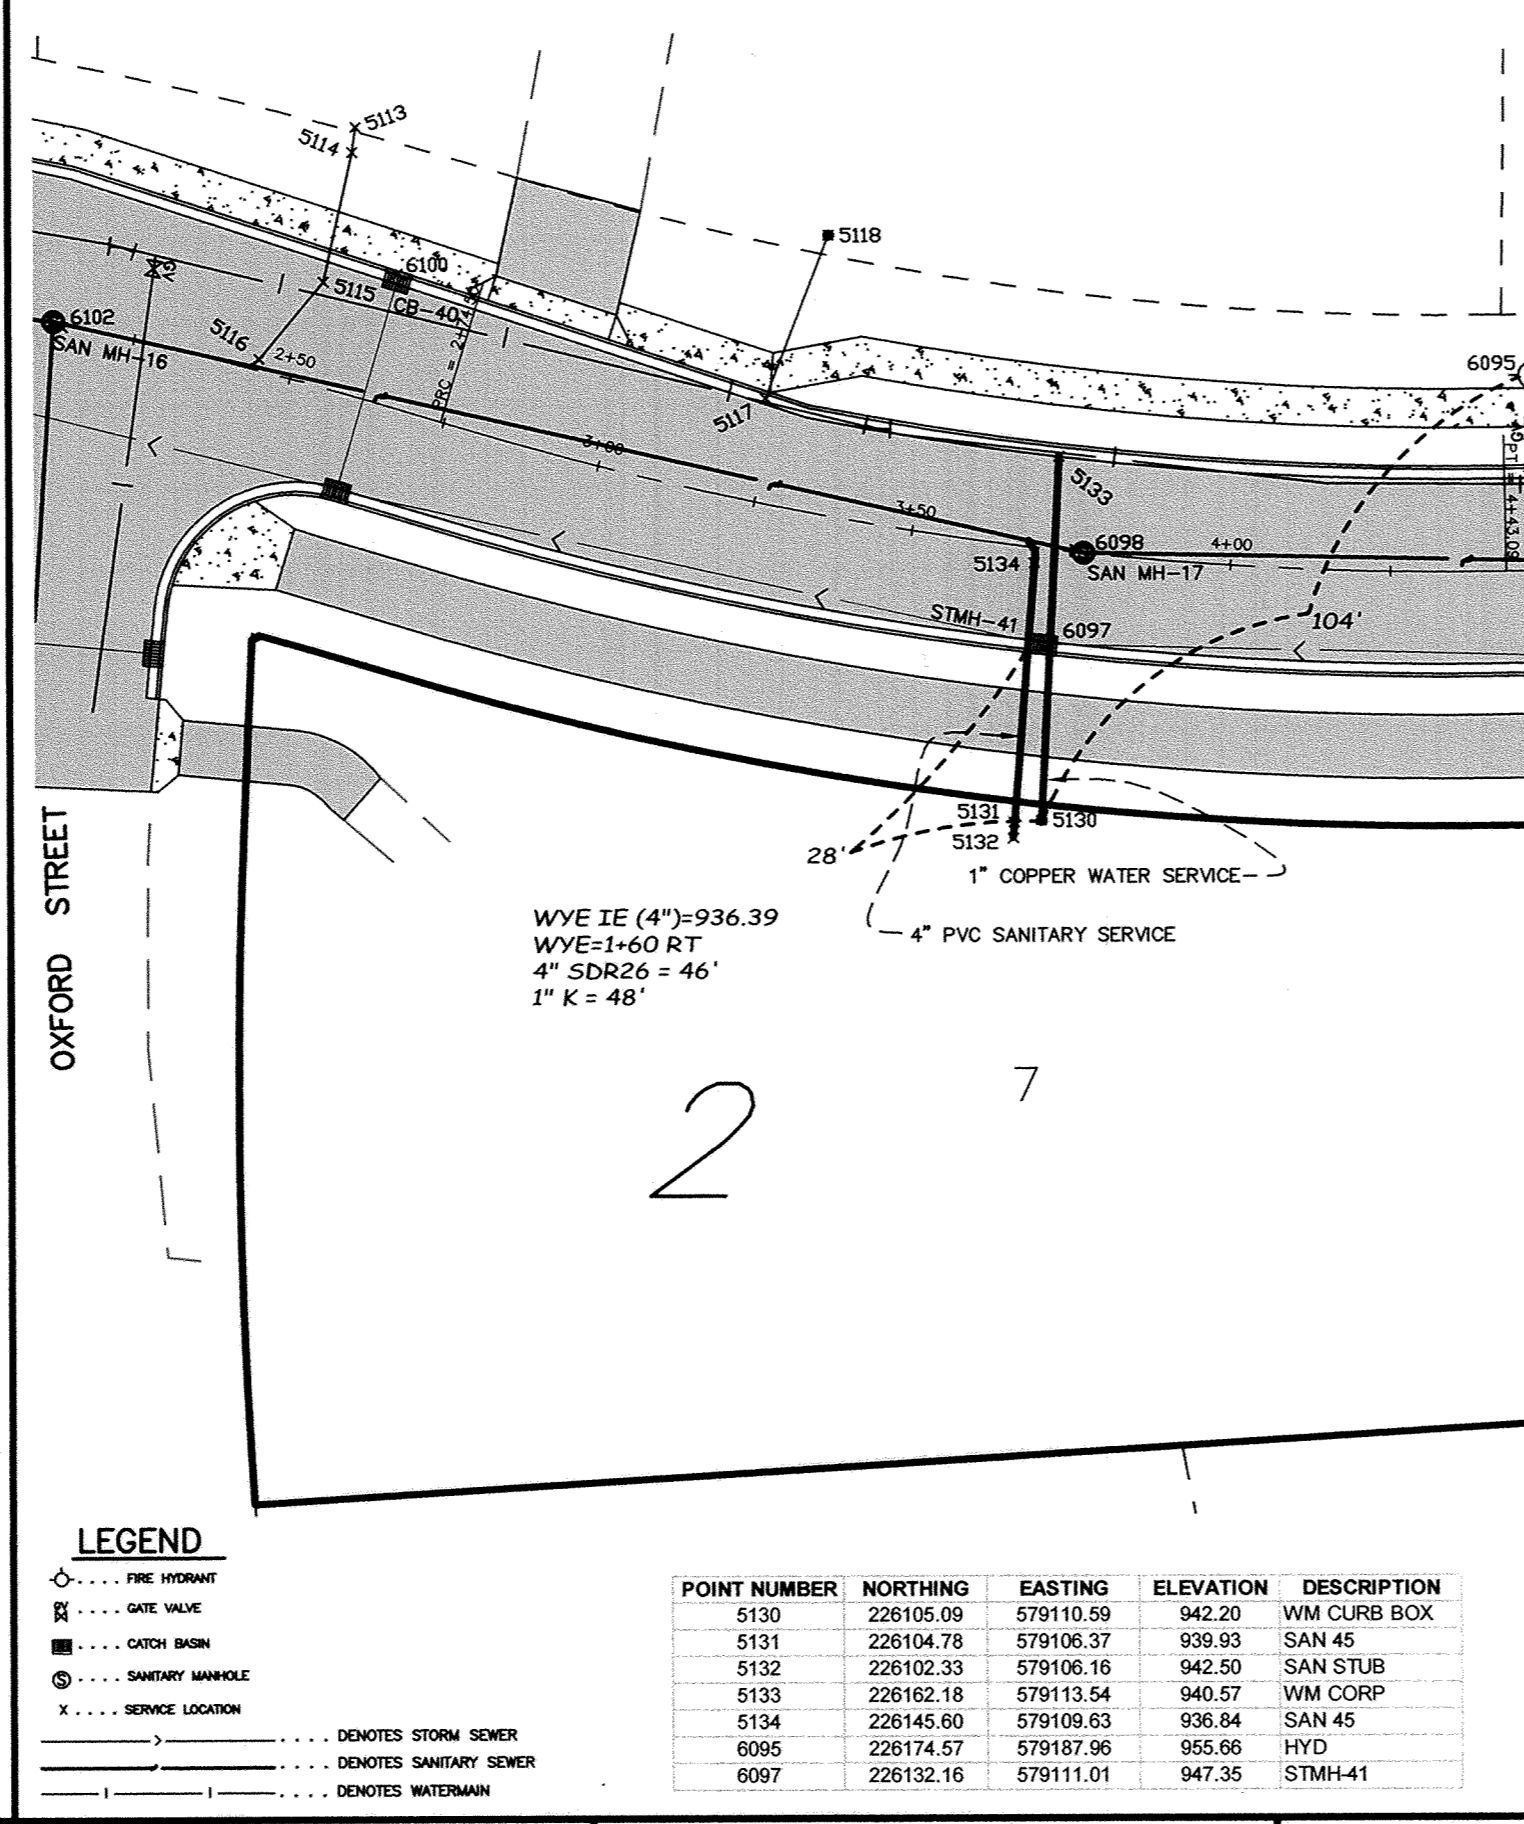

SERVICE LOCATION
19375 OXFORD ST NW
CITY OF ELK RIVER
HIGHLAND ROAD

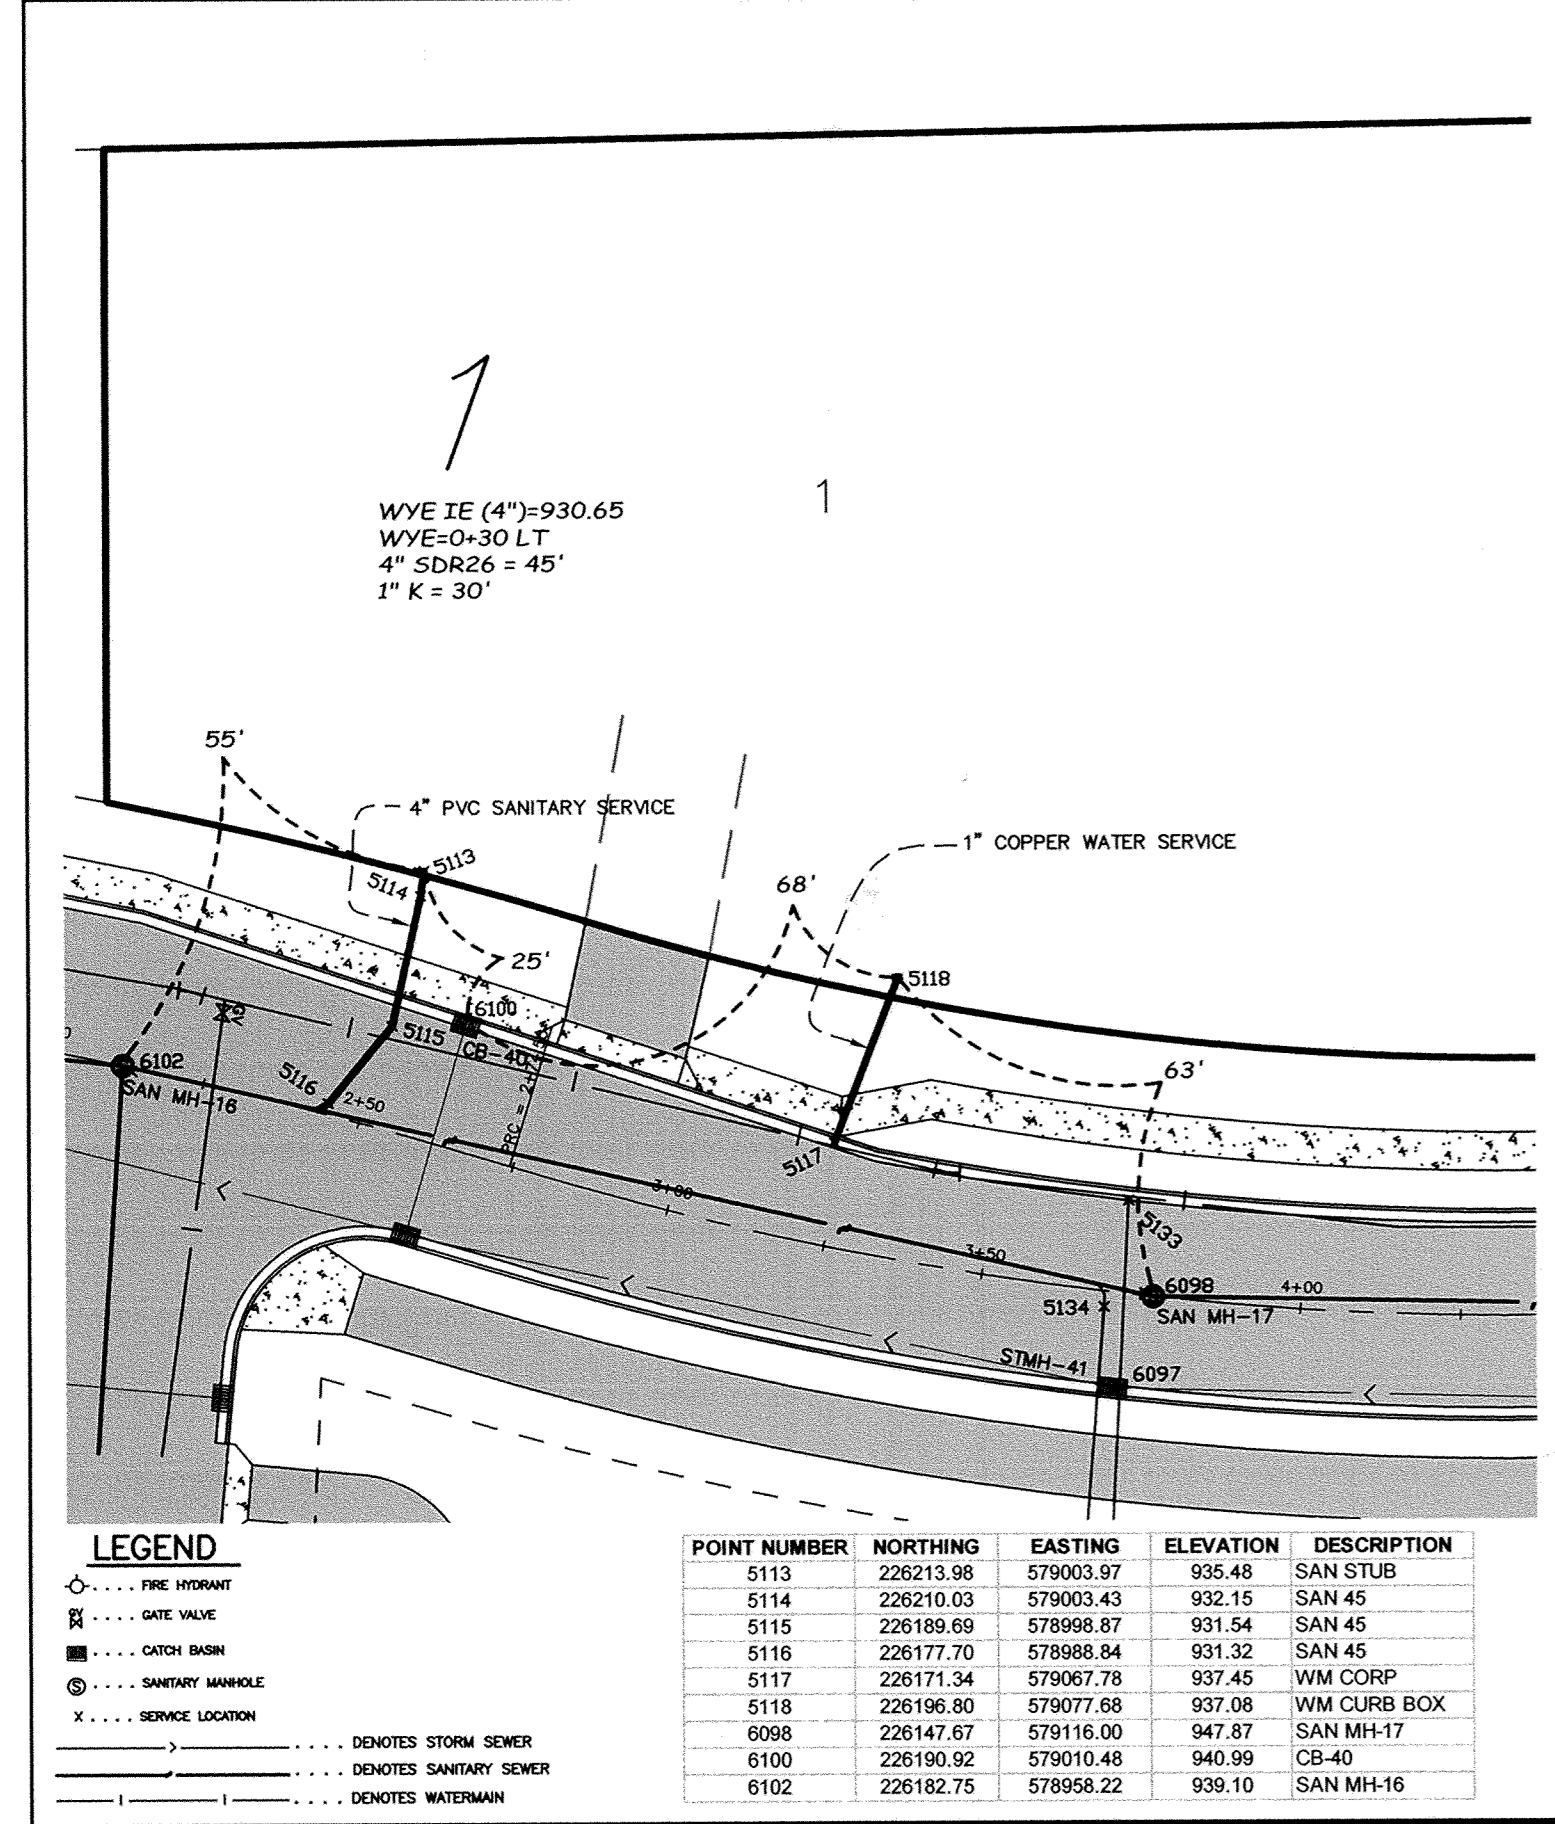

SERVICE LOCATION
12155 HIGHLAND RD NW
CITY OF ELK RIVER
HIGHLAND ROAD

