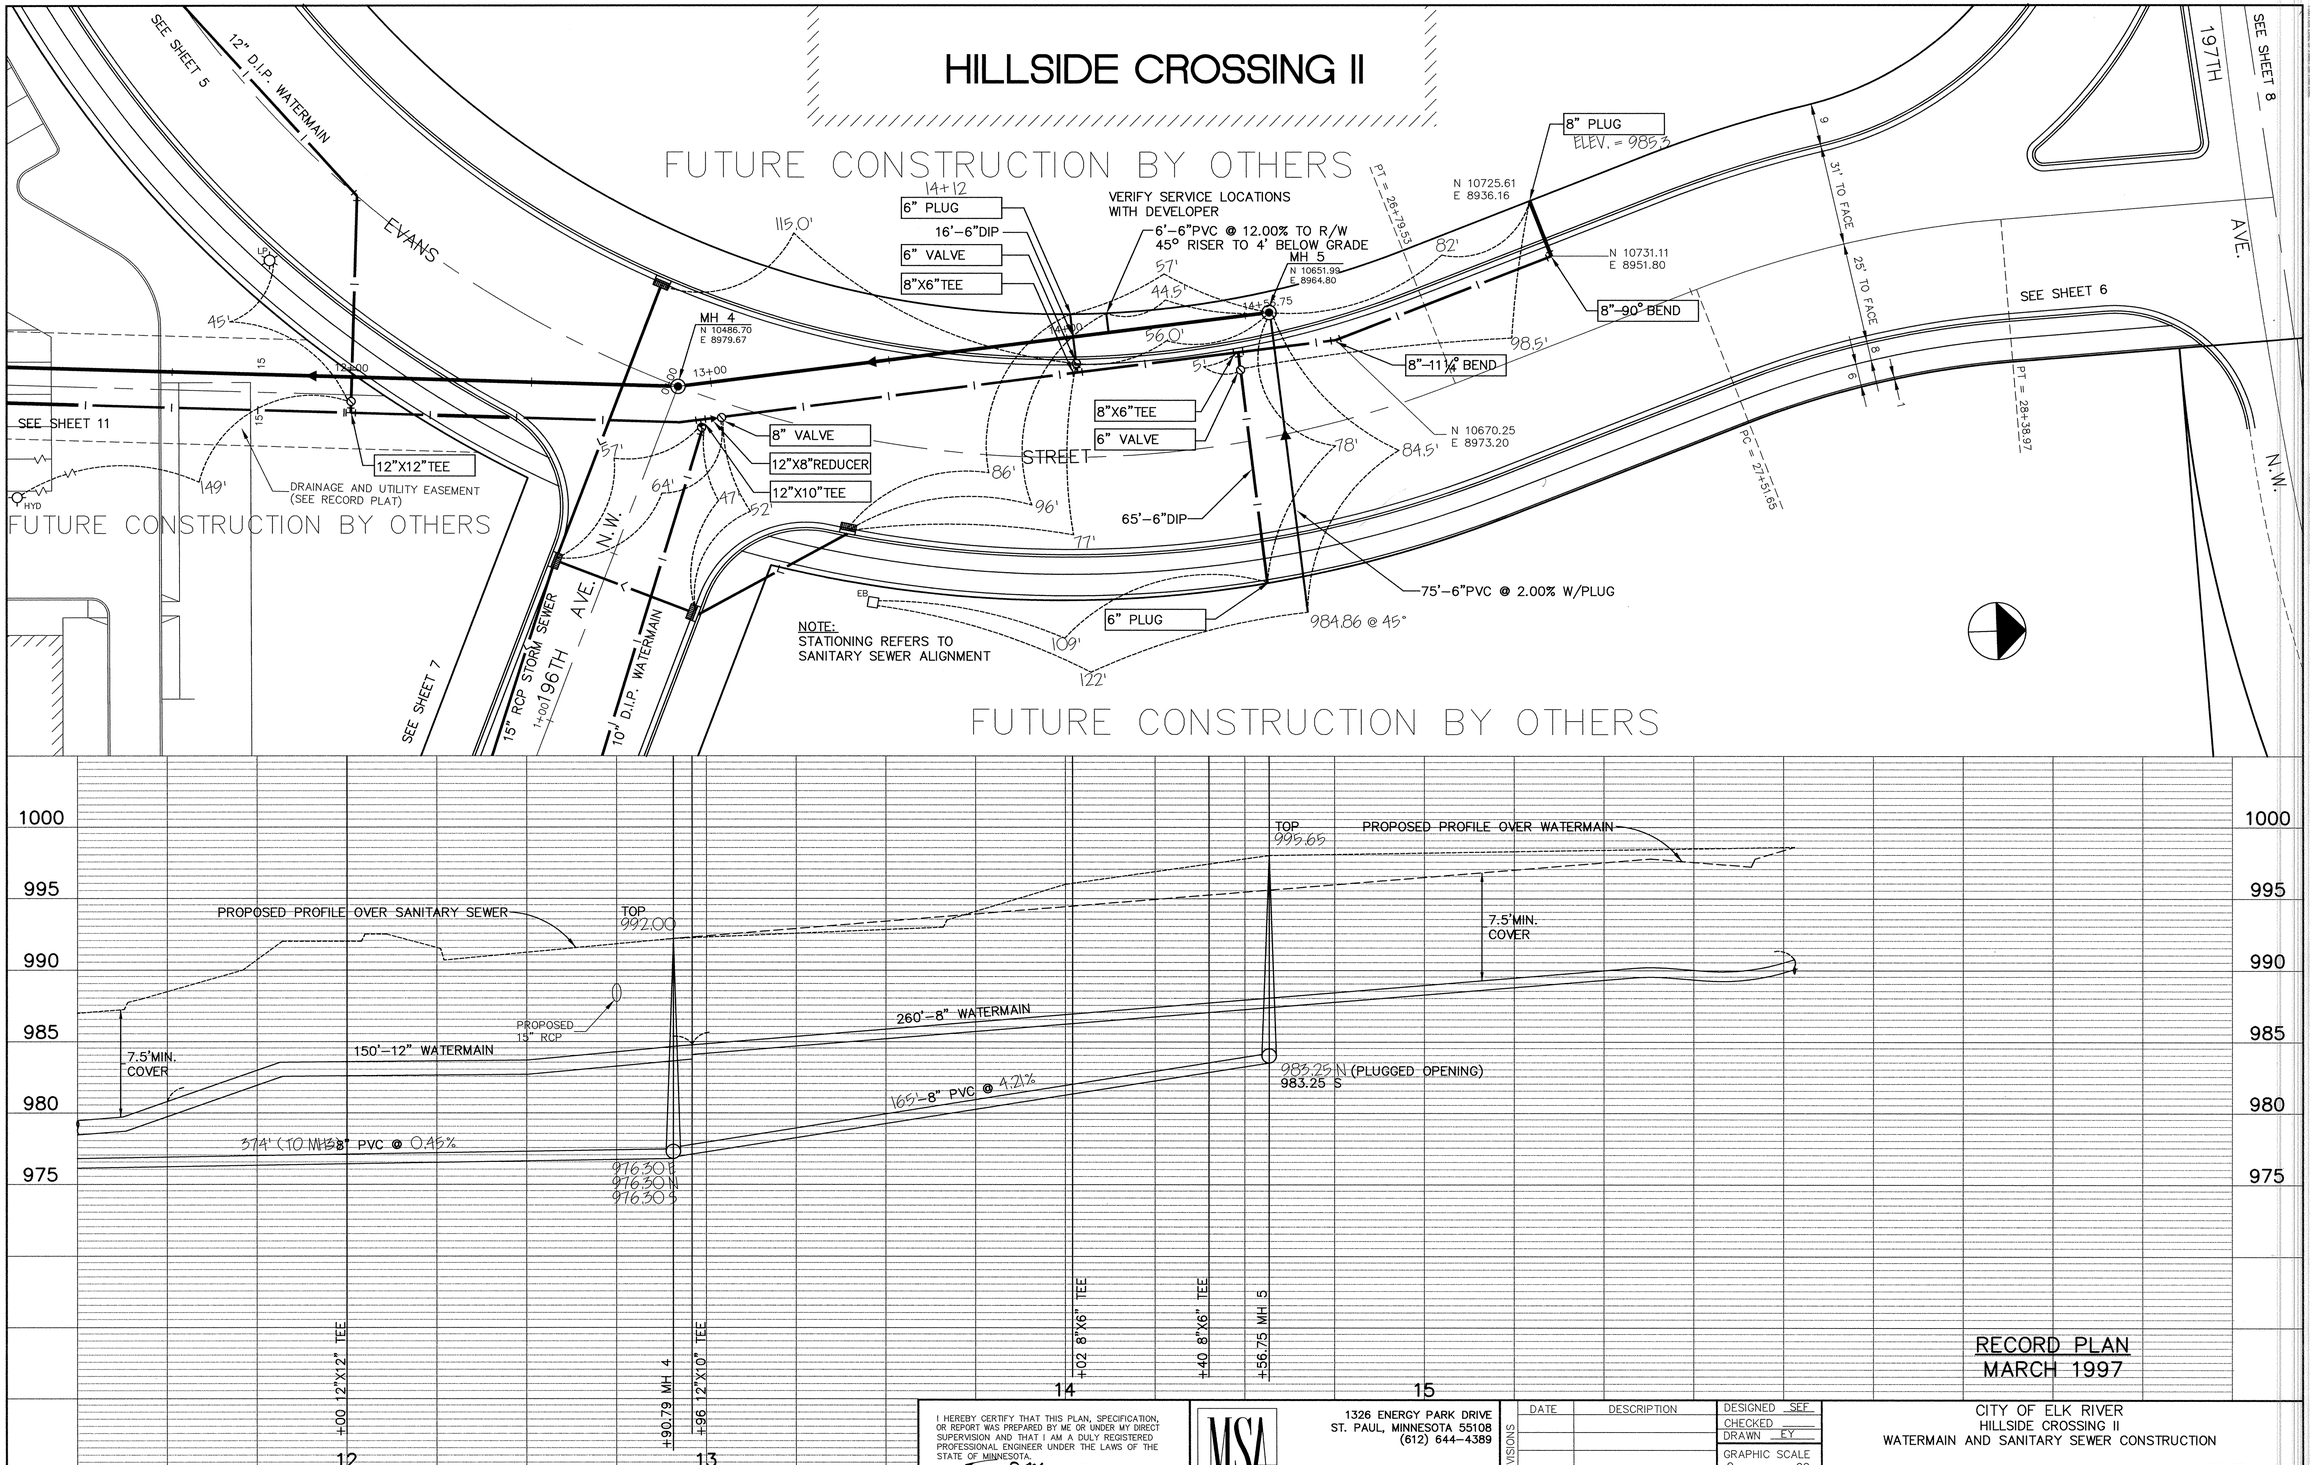

I HEREBY CERTIFY THAT THIS PLAN, SPECIFICATION, OR REPORT WAS PREPARED BY ME OR UNDER MY DIRECT SUPERVISION AND THAT I AM A DULY REGISTERED PROFESSIONAL ENGINEER UNDER THE LAWS OF THE STATE OF MINNESOTA.

DATE 4/15/96 REG.NO. 15316

MSA CONSULTING ENGINEERS

1326 ENERGY PARK DRIVE
ST. PAUL, MINNESOTA 55108
(612) 644-4389

REVISIONS	DATE	DESCRIPTION

DESIGNED SEF
CHECKED
DRAWN EY
GRAPHIC SCALE 0 20
0 VERT. 5

CITY OF ELK RIVER
HILLSIDE CROSSING II
WATERMAIN AND SANITARY SEWER CONSTRUCTION

11+50 TO 16+00

DATE APRIL 1996 | SHEET 12 OF 31 SHEETS | PROJECT NO. 230-297

ER297-9

1201

DRAWING NUMBER



HILLSC2.97
12

O:\CAD\ElkRiver\ER297\Er297-9.dwg Fri Dec 26 14:02:46 1997