U.S. HIGHWAY NO. 169

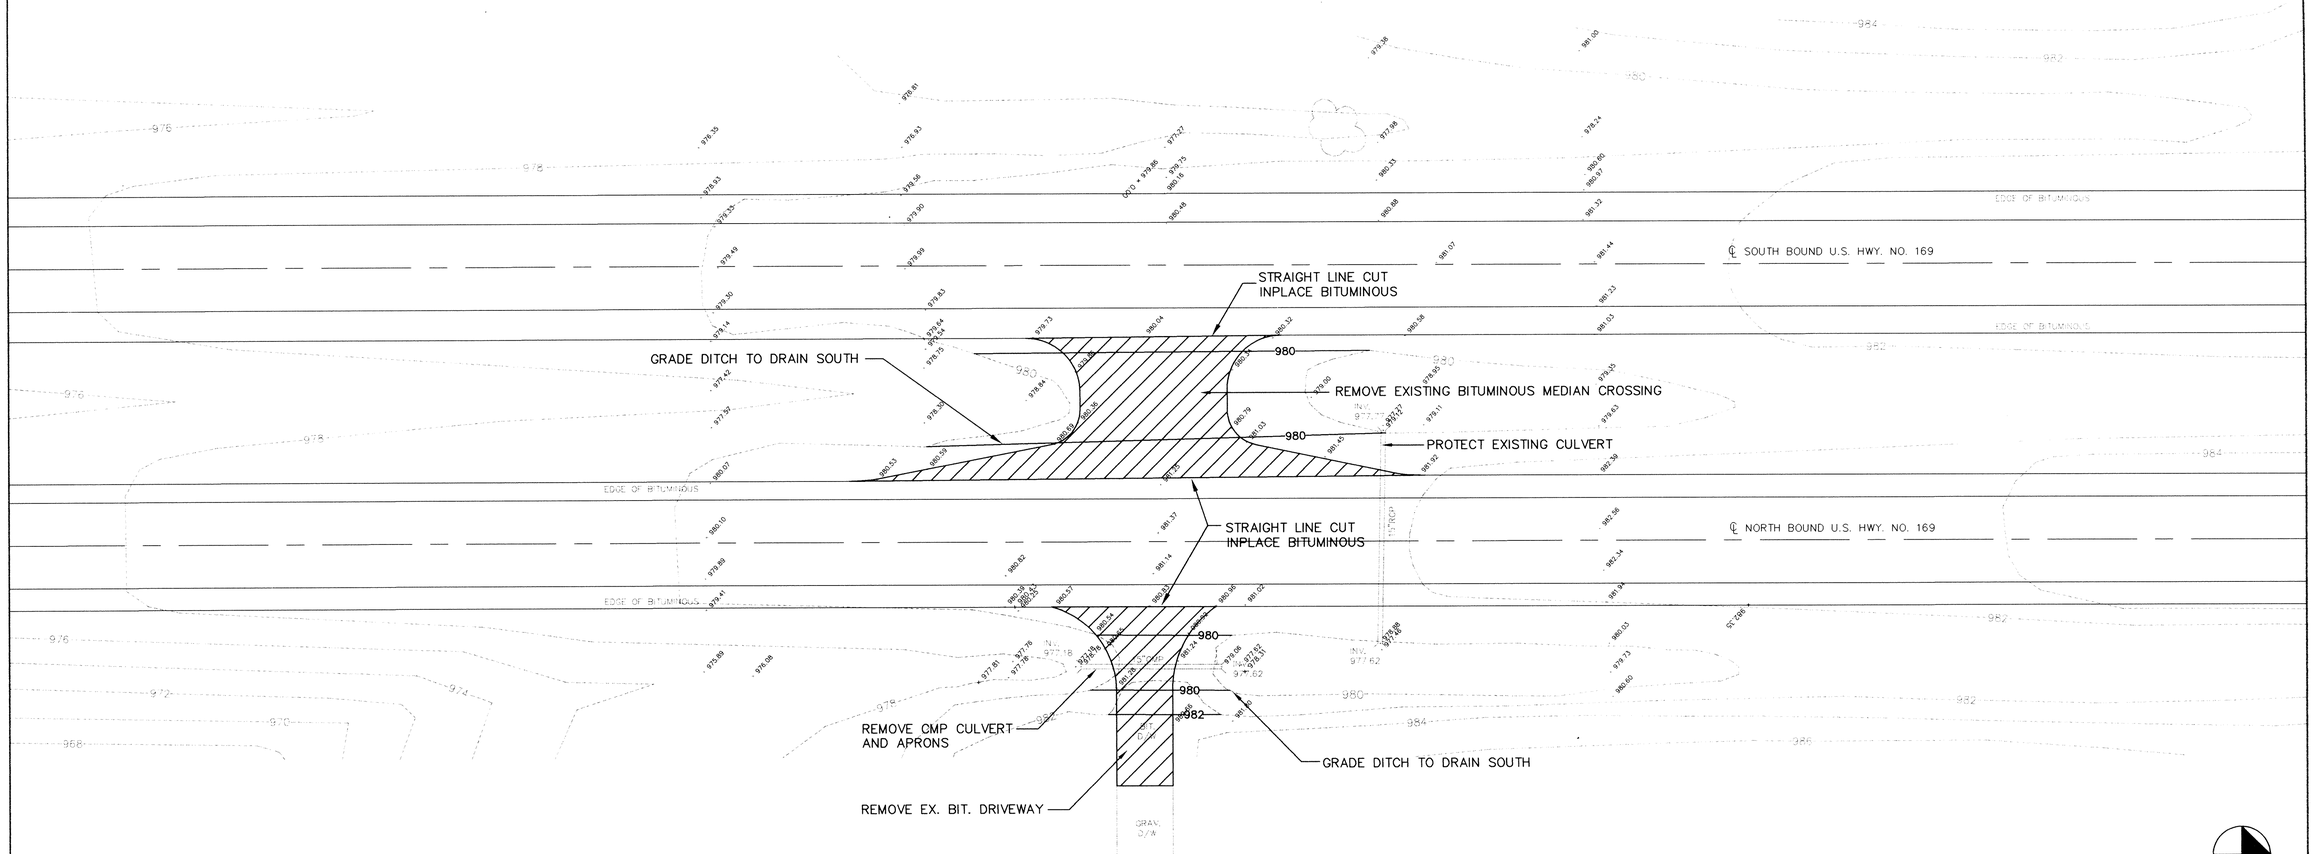

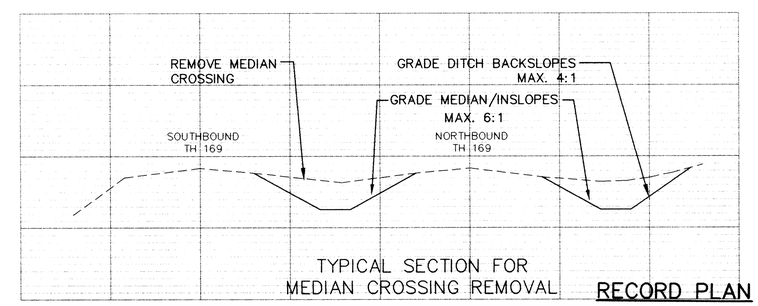

TYPICAL SECTION FOR
MEDIAN CROSSING REMOVAL

RECORD PLAN
MARCH 1997

I HEREBY CERTIFY THAT THIS PLAN, SPECIFICATION, OR REPORT WAS PREPARED BY ME OR UNDER MY DIRECT SUPERVISION AND THAT I AM A DULY REGISTERED PROFESSIONAL ENGINEER UNDER THE LAWS OF THE STATE OF MINNESOTA.

DATE 4/15/96 REG.NO. 15316

MSA CONSULTING ENGINEERS

1326 ENERGY PARK DRIVE
ST. PAUL, MINNESOTA 55108
(612) 644-4389

REVISIONS	DATE	DESCRIPTION

DESIGNED SEF
CHECKED
DRAWN EY

GRAPHIC SCALE 0 20 / 0 VERT. 5

CITY OF ELK RIVER
HILLSIDE CROSSING II
HIGHWAY CROSSING REMOVAL
U.S. HIGHWAY NO. 169

DATE APRIL 1996 | SHEET 19 OF 31 SHEETS | PROJECT NO. 230-297

ER297-10

1194

DRAWING NUMBER



HILLSC2.97
19

Thu Apr 11 14:24:59 1996