HILLSIDE CROSSING

SEE SHEET 7

SEE SHEET 5

SEE SHEET 8

ST MH 4 (60"ø)
R-1733 CSTG W/ TYPE C GRATE
TOP 954.53
N 8722.01
E 8856.16

MH 4
N 8798.65
E 8900.26

ST MH 5 (60"ø)
R-1733 CSTG W/ TYPE C GRATE
TOP 955.15
N 8845.93
E 8860.59

12"x6"TEE
15'-6"DIP
HYD W/VALVE
4+60, 14.83'LT

ST MH 6 (60"ø)
R-1733 CSTG W/ TYPE C GRATE
TOP 955.77 N 8969.86
E 8865.02

ST MH 7 (60"ø)
R-1733 CSTG W/ TYPE C GRATE
TOP 956.08
N 9031.82
E 8867.24

ST MH 8 (60"ø)
R-1733 CSTG W/ TYPE C GRATE
TOP 956.39
N 9093.78
E 8869.46

MH 45
N 9198.40
E 8914.51

ST MH 9 (60"ø)
GL 957.42 956.42
N 9224.43
E 8874.13

FUTURE CURB BY OTHERS

N 9257.05
E 8875.30

70'-15"RCP @ 2.00%

12" PLUG
8+57

12"x6"TEE
15'-6"DIP
HYD W/VALVE
8+12, 23.72'RT
8+12

CB 6
GL 956.00
INV 952.50
N 9219.19
E 8944.33

PROPOSED BACK OF CURB

3+75, 10'RT
12"X8"TEE
8" VALVE
3+75

25'-6" PVC W/ PLUG

PARKING BY OTHERS

PROPOSED BUILDING

73.00
31.71
21.71

NOTE:
1. STATIONING REFERS TO SANITARY SEWER ALIGNMENT
2. SANITARY SEWER AND STORM SEWER TOP ELEVATIONS AS PER GRADING PLAN BY JOHN OLIVER AND ASSOC.,INC.

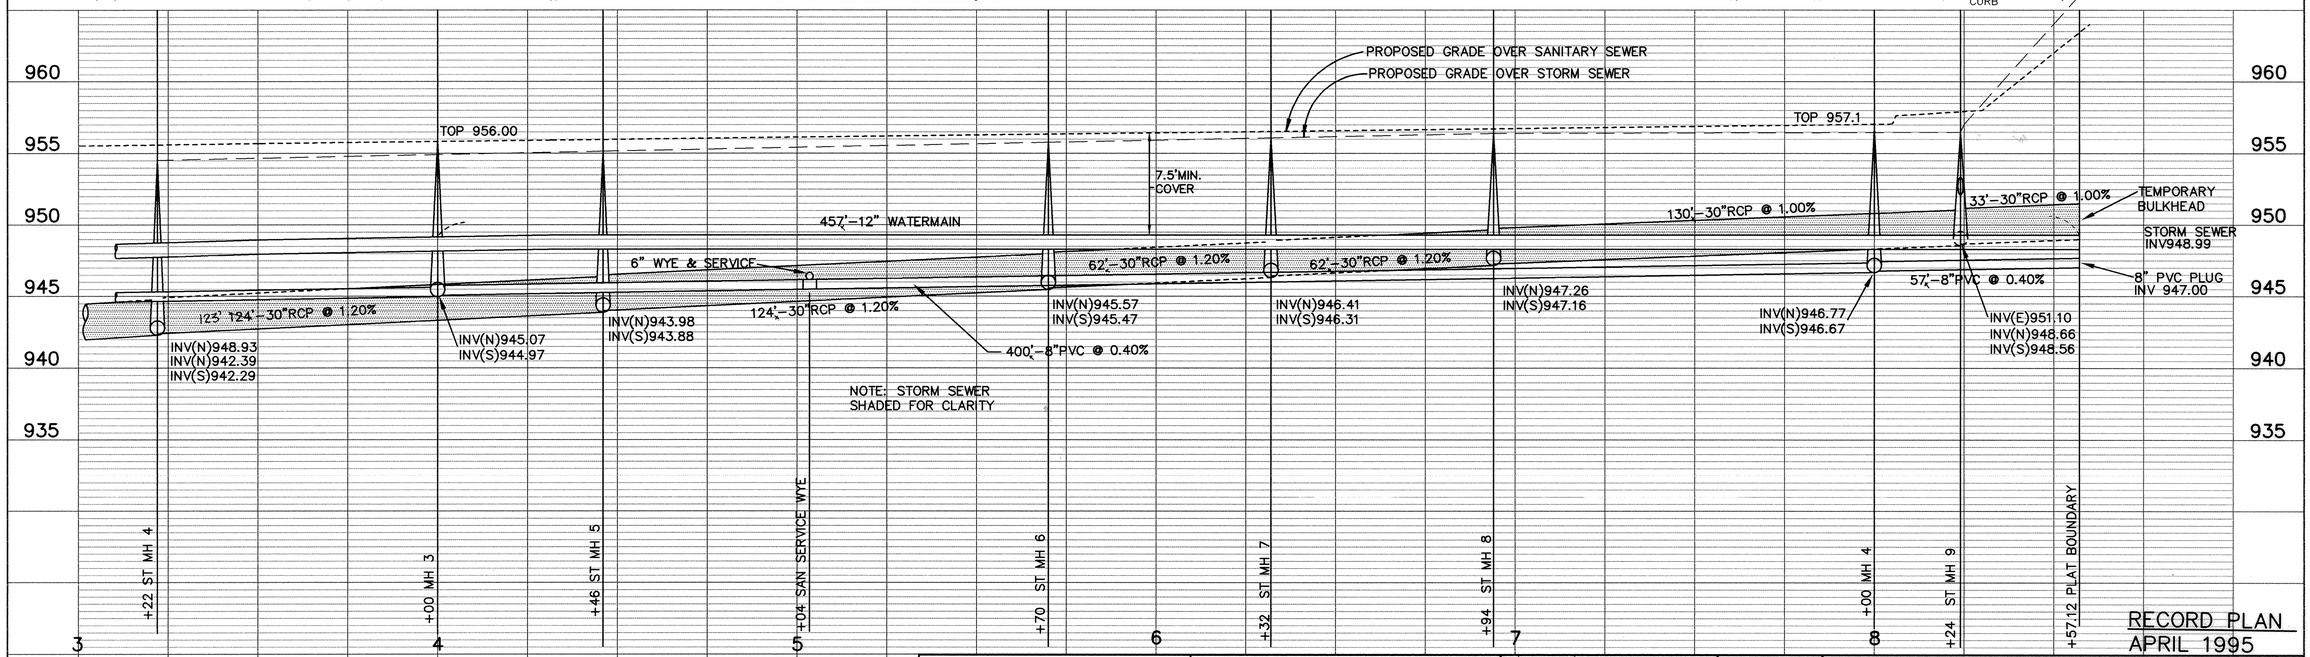

RECORD PLAN
APRIL 1995

I HEREBY CERTIFY THAT THIS PLAN, SPECIFICATION, OR REPORT WAS PREPARED BY ME OR UNDER MY DIRECT SUPERVISION AND THAT I AM A DULY REGISTERED PROFESSIONAL ENGINEER UNDER THE LAWS OF THE STATE OF MINNESOTA.
DATE 8/9/94 REG.NO. 15316

MSA CONSULTING ENGINEERS

1326 ENERGY PARK DRIVE
ST. PAUL, MINNESOTA 55108
(612) 644-4389

9800 SHELARD PARKWAY
MINNEAPOLIS, MINNESOTA 55441
(612) 546-0432

REVISIONS	DATE	DESCRIPTION

DESIGNED
CHECKED
DRAWN
GRAPHIC SCALE 0 20 (HORIZ.) 0 5 (VERT.)

CITY OF ELK RIVER
SANITARY SEWER,STORM SEWER AND WATERMAIN
HILLSIDE CROSSING

DATE AUG 1994 | SHEET 6 OF 12 SHEETS | PROJECT NO. 230-226

ER226-11

899

DRAWING NUMBER
SAFCO PRODUCTS • NEW HOPE, MINNESOTA
REORDER BY PART NUMBER 6562

DRAWING NUMBER
HILLSC.96
6

Fri Aug 5 10:54:20 1994