CONSTRUCTION PLANS FOR
HILLSIDE ESTATES 10TH ADDITION

UTILITY AND STREET IMPROVEMENTS

CITY OF ELK RIVER, MINNESOTA

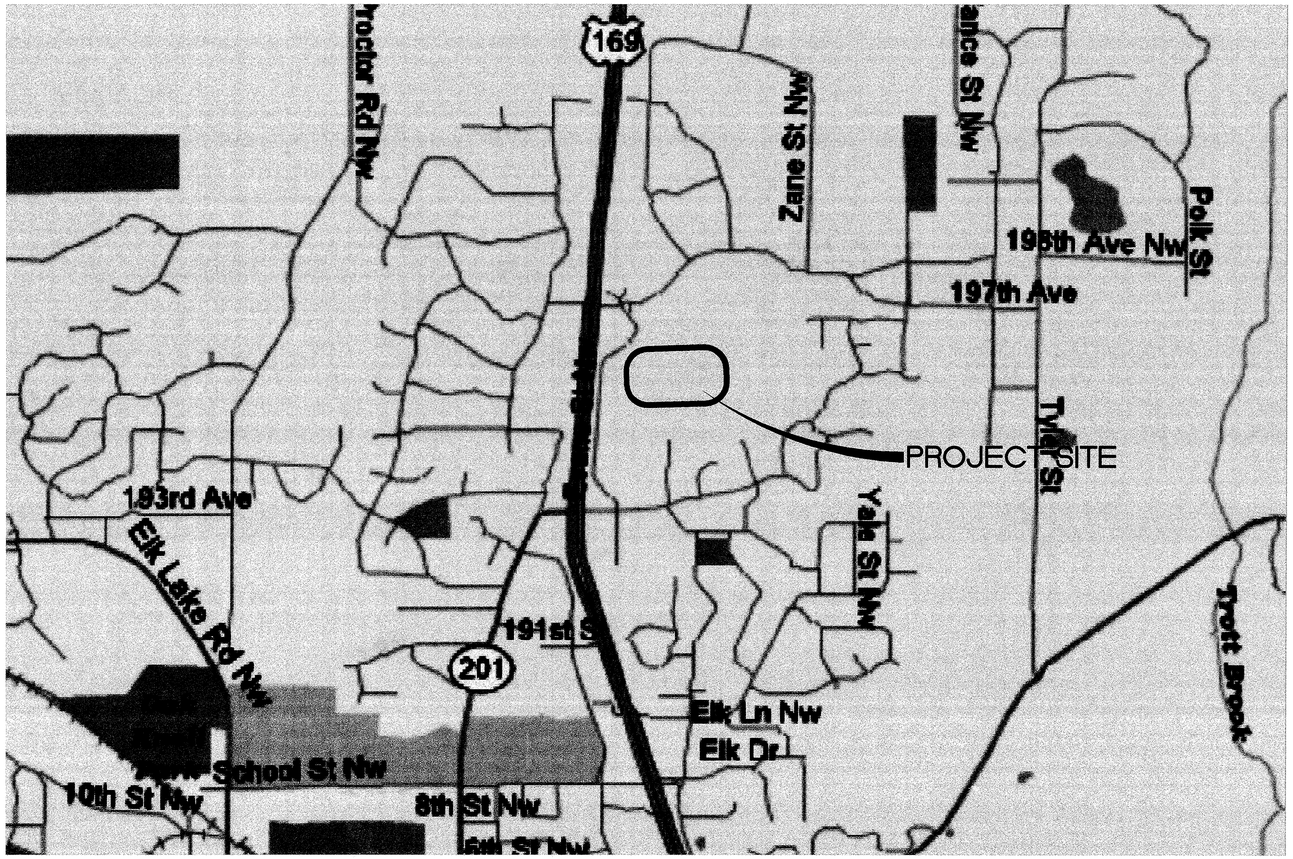

N

APPROVED BY CITY ENGINEER OF ELK RIVER.

I HEREBY CERTIFY THAT THIS PLAN WAS APPROVED BY THE CITY ENGINEER OF THE CITY OF ELK RIVER.

TERRY MAUER CITY ENGINEER

DATE _____ LICENSE NO. _____

CONTRACTOR:

KOBER EXCAVATING INC.
16112 JARVIS STREET NW
ELK RIVER, MN. 55330-6216
(763) 441-2853

STREETS:

BAUERLY BROTHERS
4787 HIGHWAY 23 NE
SAUK RAPIDS, MN. 56379
(320) 251-3378

INDEX:

C1	COVER SHEET
U1–U3	STORM SEWER – PLAN AND PROFILE
D1	STORM SEWER DETAILS

RECORD PLAN
2006

DRAWN	EY
DATE	12/1/03
SCALE	
PROJECT	R01101.003
CHECKED	
APPROVED	

STORM SEWER IMPROVEMENTS
COVER SHEET
HILLSIDE ESTATES
10TH ADDITION
CITY OF ELK RIVER, MINNESOTA

OWNER/DEVELOPER

RIVERSIDE COMPANIES
19230 EVANS STREET
ELK RIVER, MINNESOTA
PHONE:763-241-1801

DATE	REVISIONS	BY
04/10/07	AS-BUILT PER CITY	EY

C1

DRAWING NUMBER

DRAWING NUMBER

DRAWING NUMBER

DRAWING NUMBER
HILLSE10.07
1