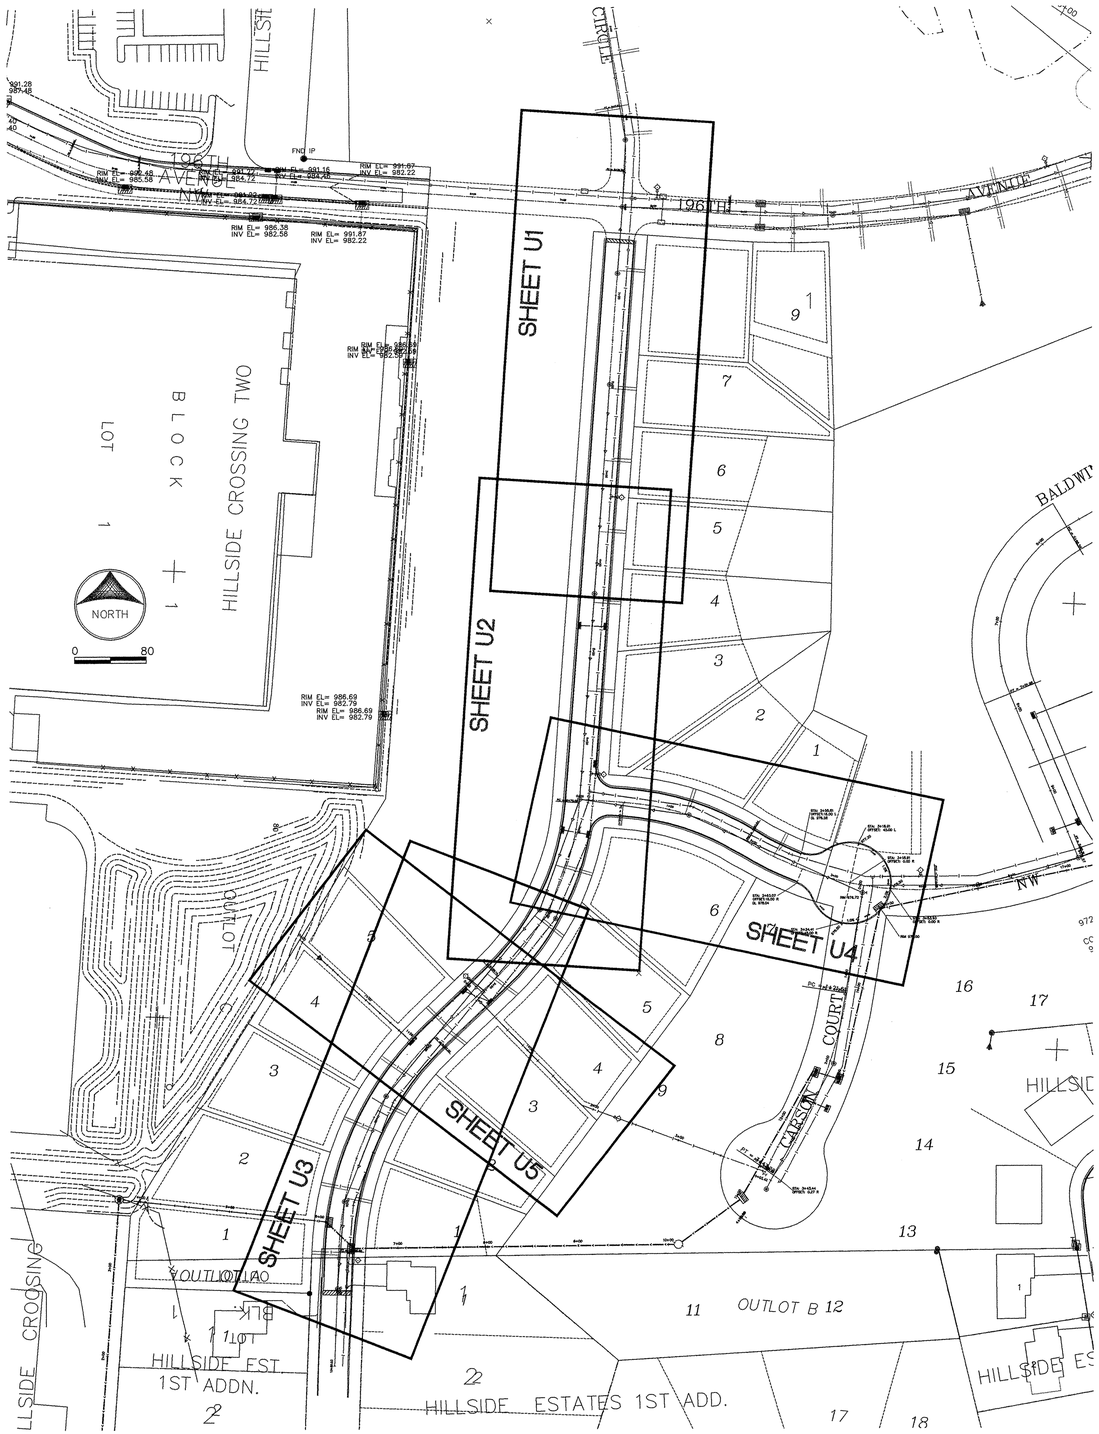

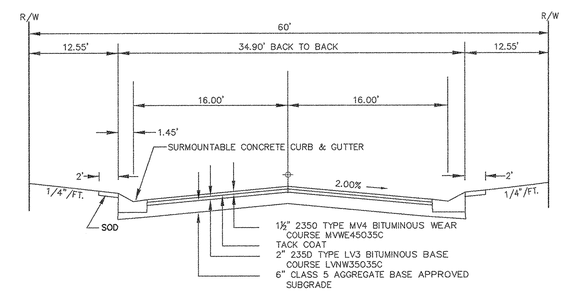

TYPICAL STREET SECTION

NOTE:
B618 CONCRETE CURB AND GUTTER SHALL BE PLACED AROUND RADII AND AT STORM SEWER STRUCTURES.

WEAR COURSE
2007

RECORD PLAN
2006

DRAWN	TK
DATE	12/1/03
SCALE	1"=80'
PROJECT	R0101.003
CHECKED	
APPROVED	

LOCATION MAP
HILLSIDE ESTATES 10TH ADDITION
TYPICAL SECTION

CITY OF ELK RIVER, MINNESOTA

OWNER/DEVELOPER

RIVERSIDE COMPANIES
19230 EVANS STREET, SUITE 115
ELK RIVER, MINNESOTA
PHONE:763-241-1801

METRO
LAND SURVEYING & ENGINEERING
12310 Fletcher Lane North-Unit B, Rogers, MN 55374
Telephone:(763)428-5172 Fax:(763)428-5172
Email: Metro@metroinc.com
Little Canada: (651) 766-0112 Pine City: (320) 629-3287

DATE	REVISIONS	BY
06/17/05	REVISED STORM DESIGN	JS/PK
08/10/05	REVISED PER CITY COMMENTS	JS/PK
02/09/06	REVISED PER CLIENT REQUEST	JPS
04/10/07	AS-BUILT PER CITY	EY

L1

DRAWING NUMBER

SAFCO PRODUCTS • NEW HOPE, MINNESOTA
REORDER BY PART NUMBER 6552
POSITION EDGE OF PRINT ON THIS LINE

DRAWING NUMBER

SAFCO PRODUCTS • NEW HOPE, MINNESOTA
REORDER BY PART NUMBER 6552
POSITION EDGE OF PRINT ON THIS LINE

DRAWING NUMBER

SAFCO PRODUCTS • NEW HOPE, MINNESOTA
REORDER BY PART NUMBER 6552
POSITION EDGE OF PRINT ON THIS LINE

DRAWING NUMBER
HILLSE10.07
2

SAFCO PRODUCTS • NEW HOPE, MINNESOTA
REORDER BY PART NUMBER 6552
POSITION EDGE OF PRINT ON THIS LINE