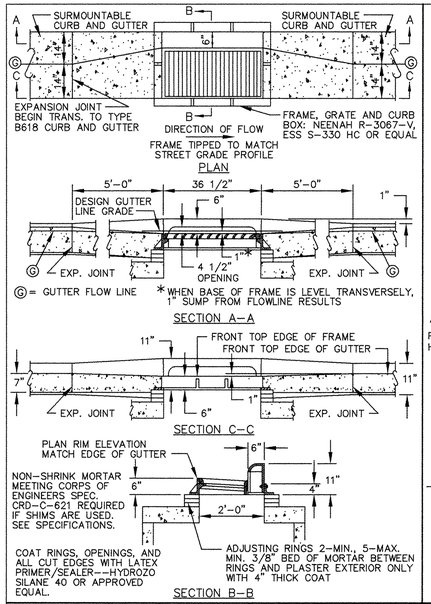

CATCH BASIN FRAME PLACEMENT
SURMOUNTABLE CURB AND GUTTER

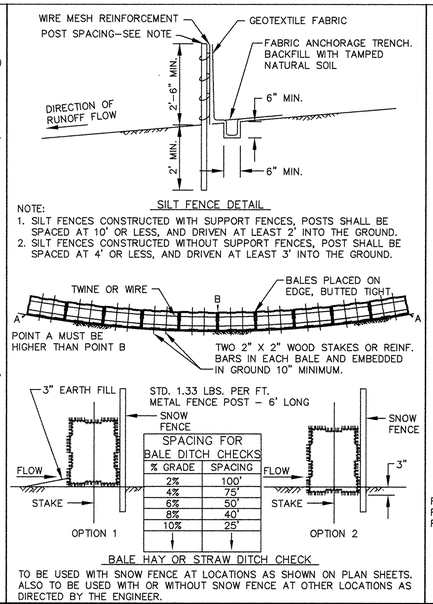

EROSION CONTROL DETAIL

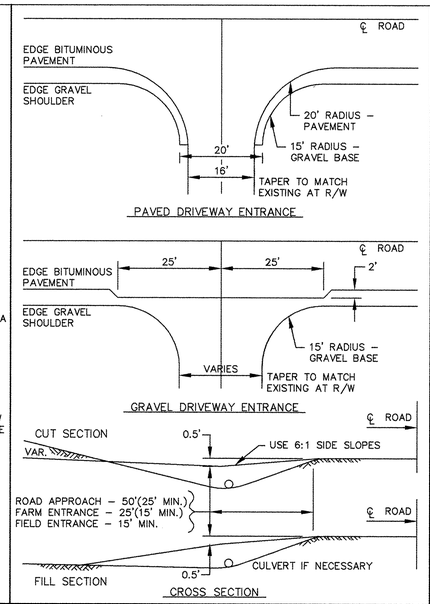

RURAL DRIVEWAY ENTRANCE

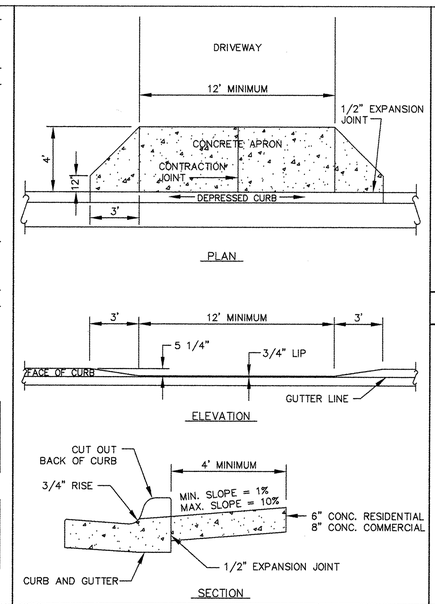

DEPRESSED CURB WITH DRIVEWAY APRON

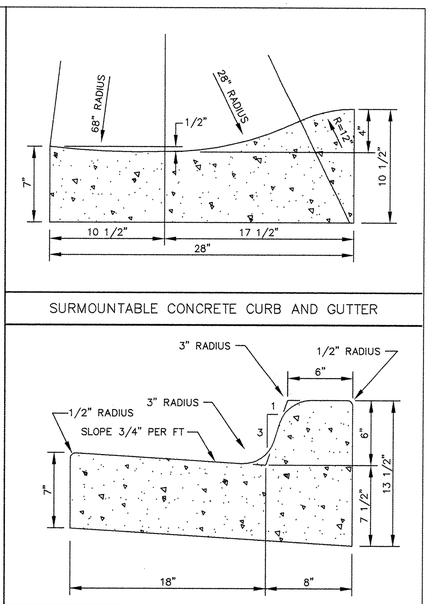

CONCRETE CURB AND GUTTER B618

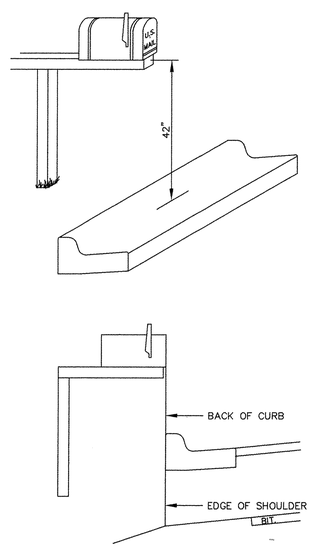

MAIL BOX

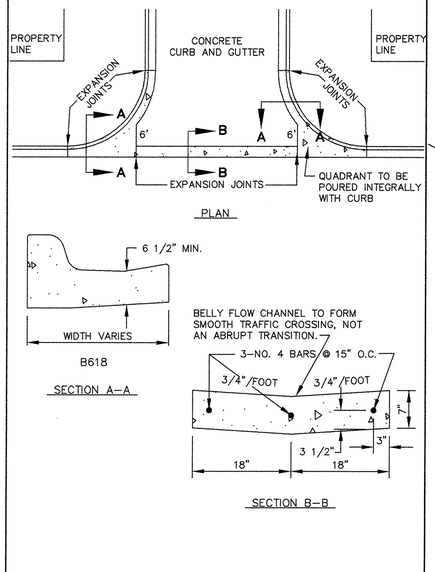

CONCRETE "V" GUTTER

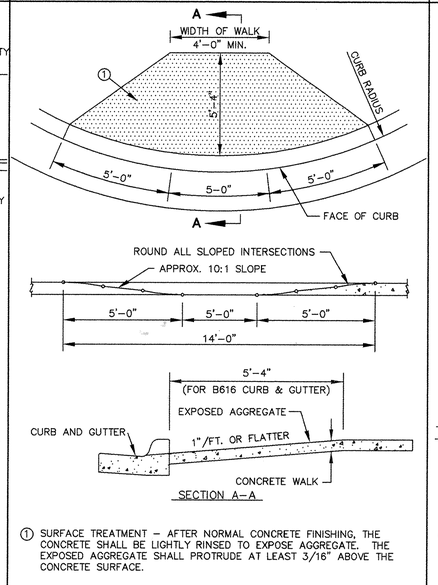

① SURFACE TREATMENT - AFTER NORMAL CONCRETE FINISHING, THE CONCRETE SHALL BE LIGHTLY RINSED TO EXPOSE AGGREGATE. THE EXPOSED AGGREGATE SHALL PROTRUDE AT LEAST 3/16" ABOVE THE CONCRETE SURFACE.

PEDESTRIAN CURB RAMPS FOR SIDEWALKS

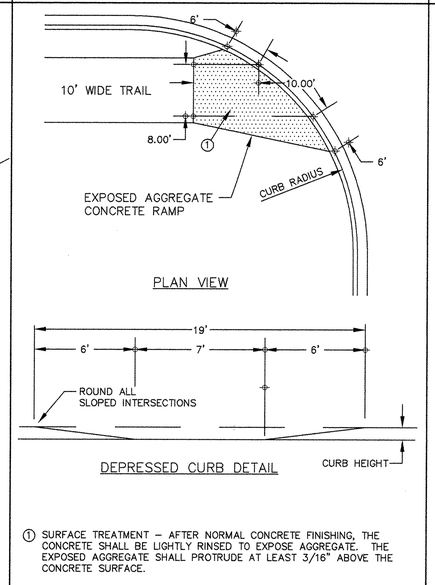

① SURFACE TREATMENT - AFTER NORMAL CONCRETE FINISHING, THE CONCRETE SHALL BE LIGHTLY RINSED TO EXPOSE AGGREGATE. THE EXPOSED AGGREGATE SHALL PROTRUDE AT LEAST 3/16" ABOVE THE CONCRETE SURFACE.

PEDESTRIAN CURB RAMPS FOR TRAILS

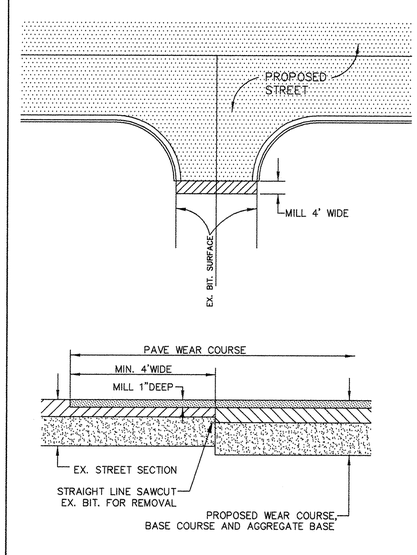

MATCH EXISTING BITUMINUOUS SURFACING

RECORD PLAN
2006

DRAWN TK
DATE 12/1/03
SCALE NA
PROJECT R0101.003
CHECKED
APPROVED

STREET CONSTRUCTION DETAILS
HILLSIDE ESTATES 10TH ADDITION
CITY OF ELK RIVER, MINNESOTA

OWNER/DEVELOPER
RIVERSIDE COMPANIES
19230 EVANS STREET, SUITE 115
ELK RIVER, MINNESOTA
PHONE: 763-241-1801

METRO
LAND SURVEYING & ENGINEERING
1250 Fletcher Lane, Northfield, MN 55057
Telephone: (763)428-5130 Fax: (763)428-5374
E-mail: survey@metrols.com
Little Canada: (651) 766-0112 Pine City: (320) 629-2367

DATE	REVISIONS	BY
04/10/07	AS-BUILT PER CITY	EY

D4

DRAWING NUMBER

DRAWING NUMBER
HILLSE10.07
11

SHIELD PRODUCTS • NEW HOPE, MINNESOTA
REORDER BY PART NUMBER 6502