193RD AVENUE N.W.

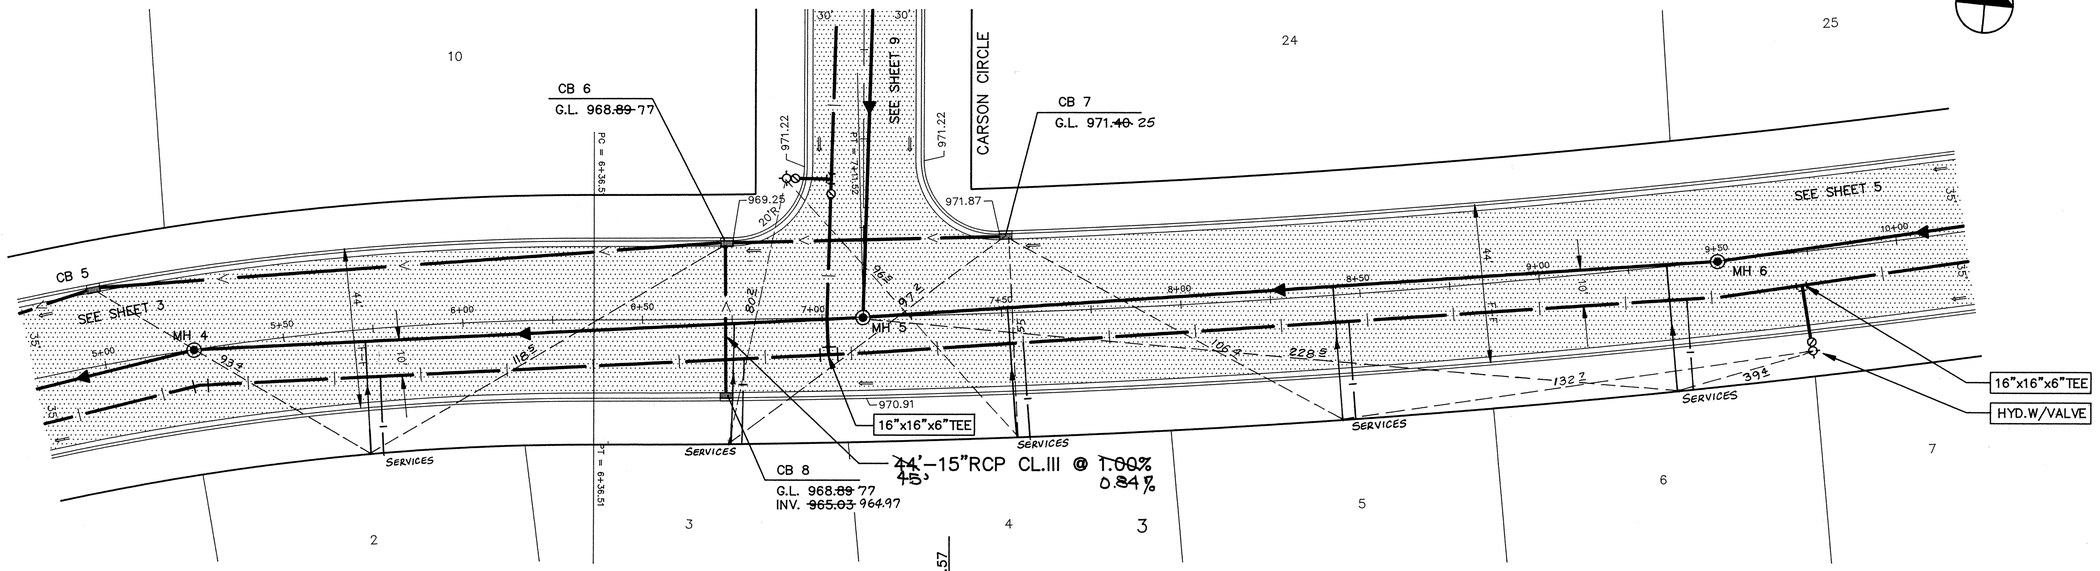

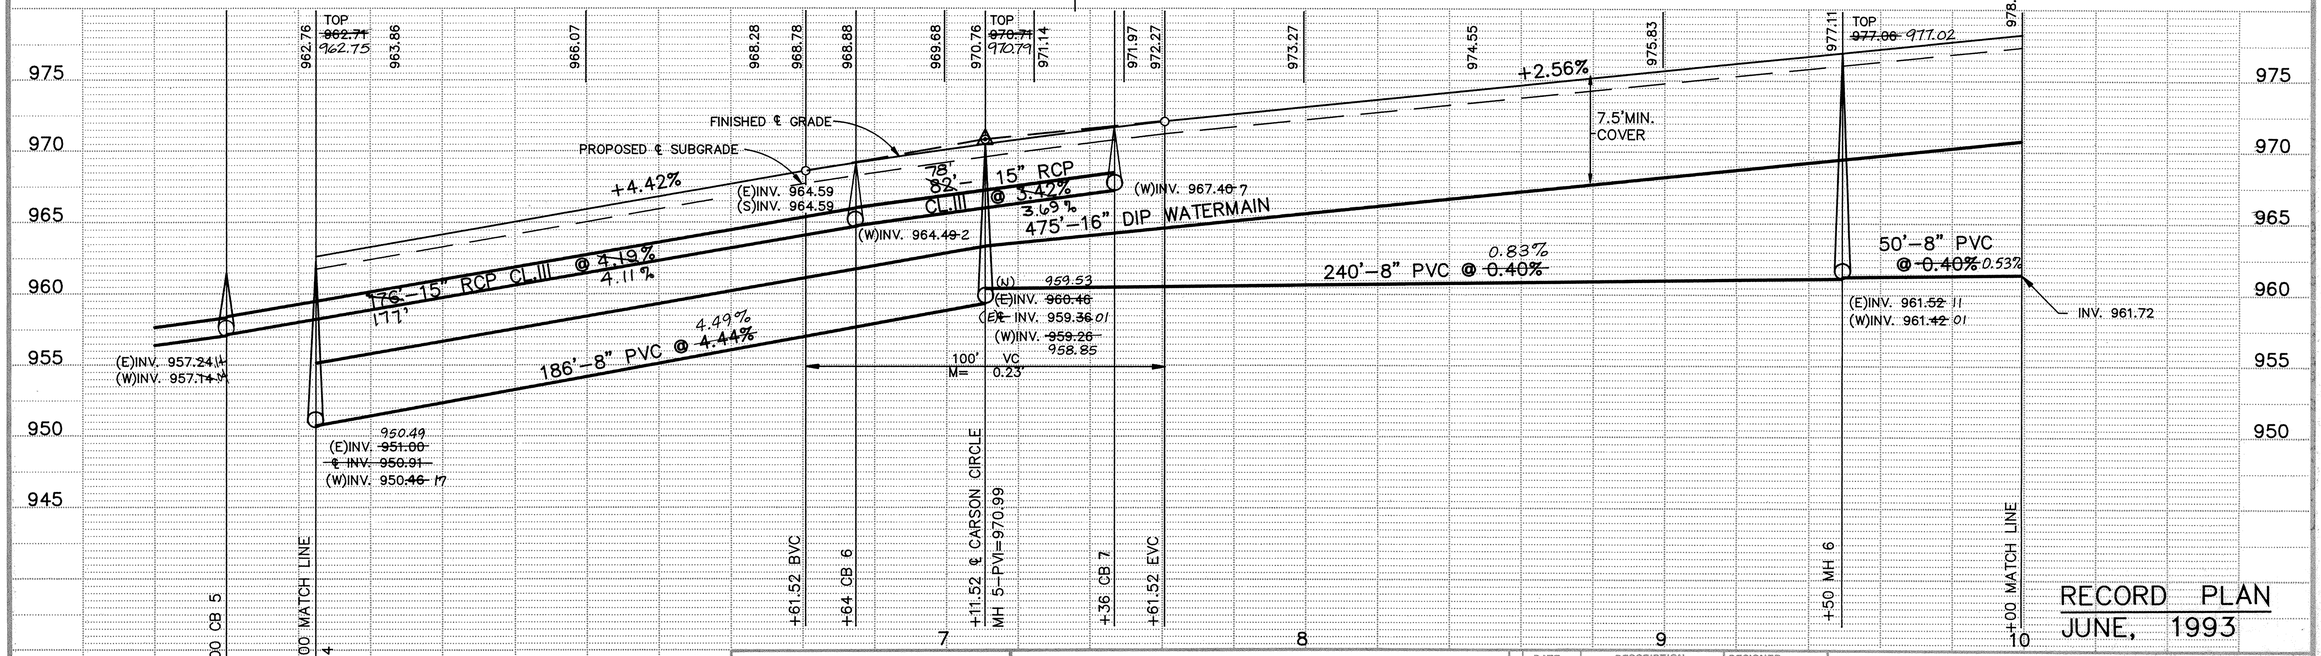

RECORD PLAN
JUNE, 1993

I HEREBY CERTIFY THAT THIS PLAN, SPECIFICATION, OR REPORT WAS PREPARED BY ME OR UNDER MY DIRECT SUPERVISION AND THAT I AM A DULY REGISTERED PROFESSIONAL ENGINEER UNDER THE LAWS OF THE STATE OF MINNESOTA.
Terry J Maurer
DATE 6/8/92 REG. NO. 15316

CONSULTING ENGINEERS
Maier Stewart & Associates Inc.
9800 SHELARD PARKWAY (612) 546-0432 MINNEAPOLIS, MINNESOTA 55441
1959 SLOAN PLACE (612) 774-6021 ST. PAUL, MINNESOTA 55117

REVISIONS	DATE	DESCRIPTION

DESIGNED
CHECKED
DRAWN MRF
GRAPHIC SCALE
HORIZ. 20
VERT. 5

CITY OF ELK RIVER
SANITARY SEWER, WATERMAIN, STORM SEWER AND STREET CONSTRUCTION
193RD AVENUE N.W.

DATE JUNE, 1992 | SHEET 4 OF 19 SHEETS | PROJECT NO. 230-140

ER140-2

DRAWING NUMBER

DRAWING NUMBER

DRAWING NUMBER
HILLSE1.93
4