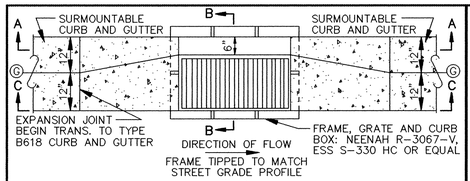

CATCH BASIN FRAME PLACEMENT
SURMOUNTABLE CURB AND GUTTER

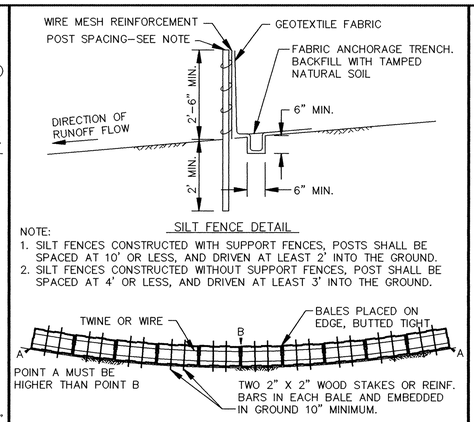

EROSION CONTROL DETAIL

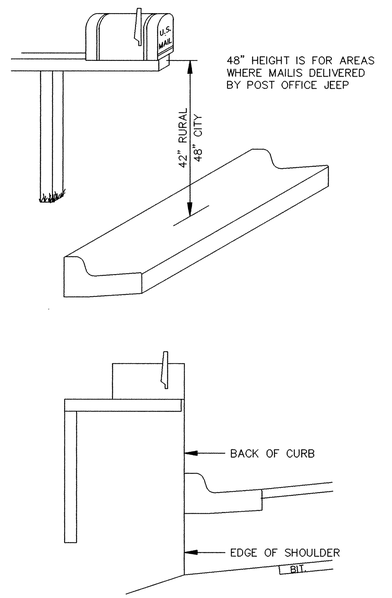

MAIL BOX

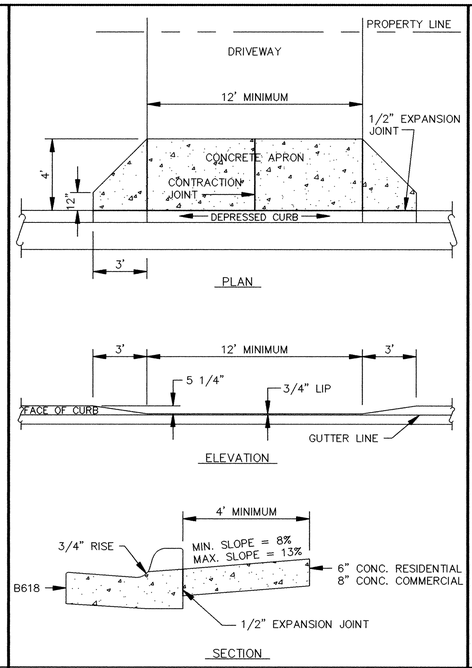

DEPRESSED CURB WITH DRIVEWAY APRON

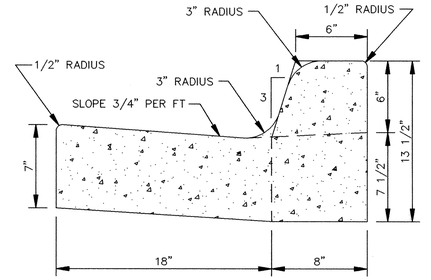

CONCRETE CURB AND GUTTER B618

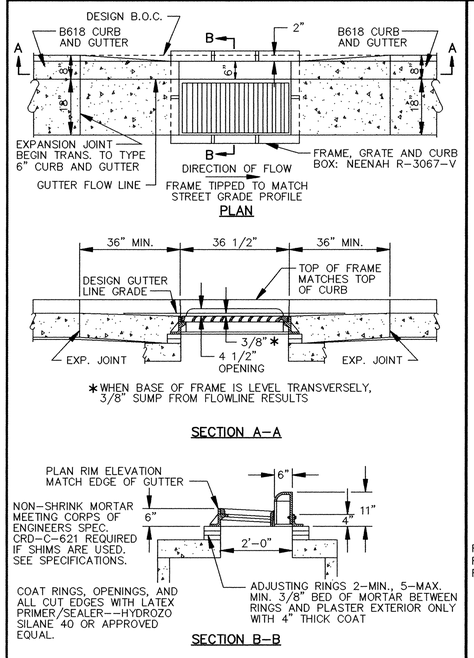

CATCH BASIN FRAME PLACEMENT
B618 CURB AND GUTTER

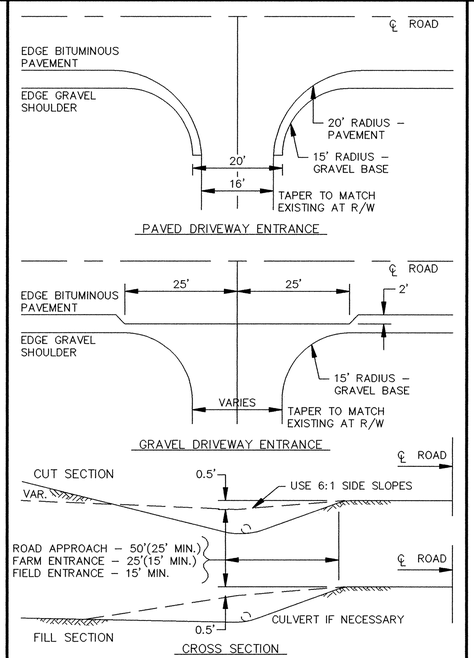

RURAL DRIVEWAY ENTRANCE

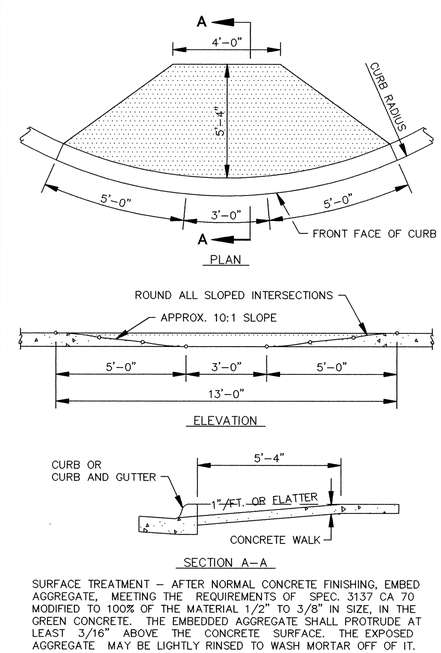

PEDESTRIAN CURB RAMPS

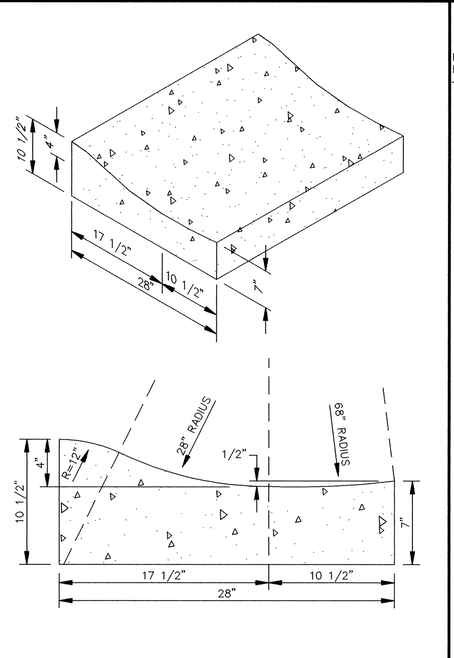

SURMOUNTABLE CONCRETE CURB AND GUTTER

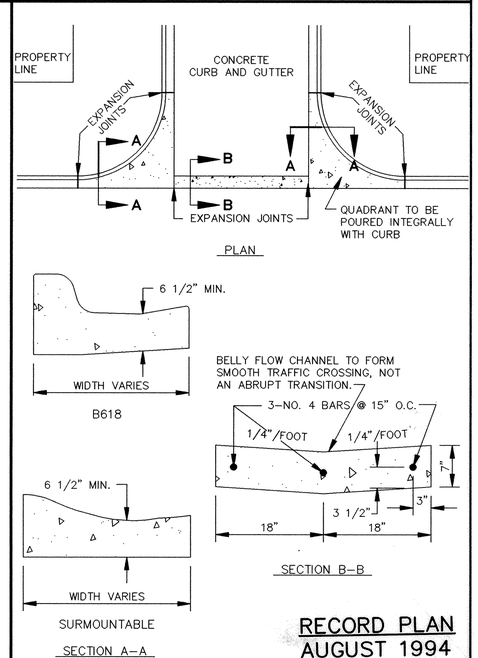

RECORD PLAN
AUGUST 1994

CONCRETE "V" GUTTER

ER199-D3

I HEREBY CERTIFY THAT THIS PLAN, SPECIFICATION, OR REPORT WAS PREPARED BY ME OR UNDER MY DIRECT SUPERVISION AND THAT I AM A DULY REGISTERED PROFESSIONAL ENGINEER UNDER THE LAWS OF THE STATE OF MINNESOTA.
Mark V. Graham
DATE 10/27/93 REG. NO. 19130

MSA CONSULTING ENGINEERS

1326 ENERGY PARK DRIVE
ST. PAUL, MINNESOTA 55108
(612) 644-4389

9800 SHELARD PARKWAY
MINNEAPOLIS, MINNESOTA 55441
(612) 546-0432

REVISIONS	DATE	DESCRIPTION

DESIGNED
CHECKED
DRAWN CLS
GRAPHIC SCALE
0 HORIZ.
0 VERT.

CITY OF ELK RIVER
HILLSIDE ESTATES SECOND ADDITION
STREET CONSTRUCTION DETAILS

DATE OCT. 1993 | SHEET 6 OF 7 SHEETS | PROJECT NO. 230-199

DRAWING NUMBER
DRAWING NUMBER
DRAWING NUMBER
HILLSE2 94
6