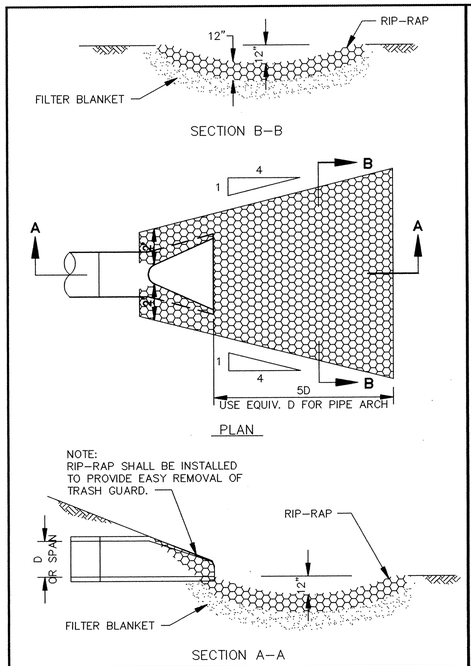

RIP-RAP INSTALLATION

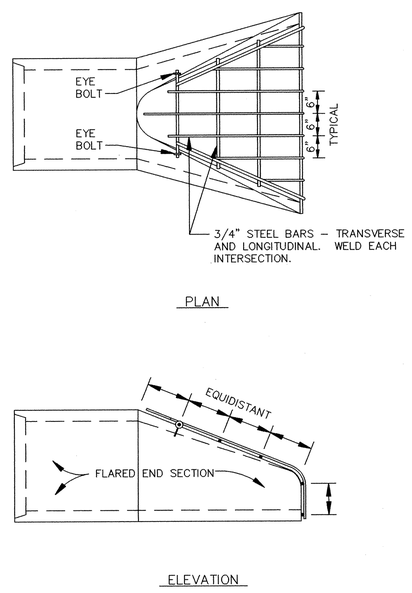

TRASH GUARD

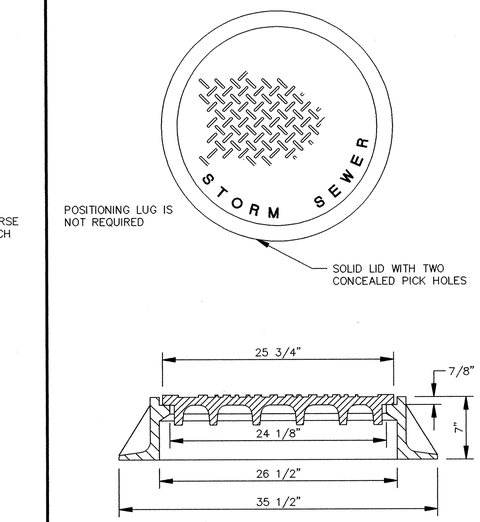

STANDARD MANHOLE CASTING

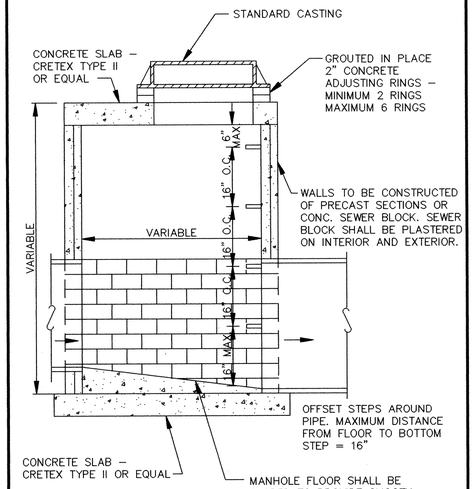

NOTE:
THIS TYPE MANHOLE SHALL BE USED WHEN SPECIFIED OR WHEN THE MANHOLE DEPTH IS LESS THAN EIGHT FEET.

SLAB TOP MANHOLE

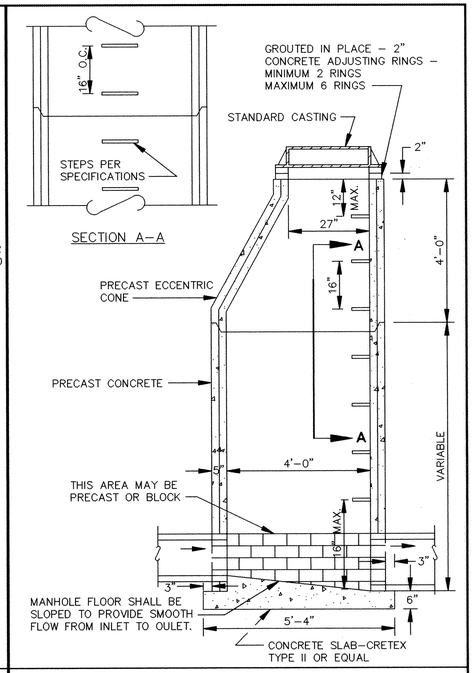

STANDARD MANHOLE

PIPE SIZE	THREAD DIAMETER
12 15 18 21 24 27	5/8" ROLLED THREADS (SEE NOTE 4)
30 33 36 42 48 54 60 66	3/4" CUT OR ROLLED
72 78 84 90 96 102 108 120 132	1" CUT OR ROLLED

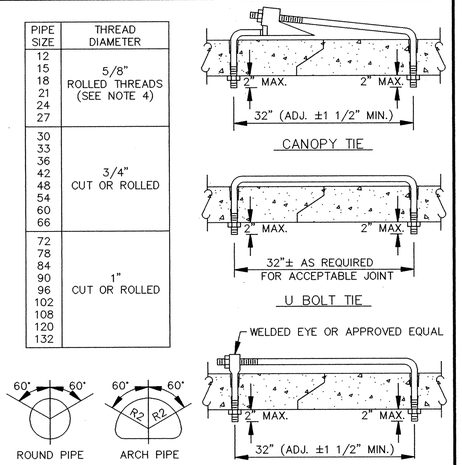

NOTE:
1. HOLES SHALL BE CAST-IN OR DRILLED 16" FROM OUTSIDE EDGE OF JOINT.
2. NUTS AND WASHERS ARE NOT REQUIRED ON INSIDE OF PIPE WITH 27" DIAMETER OR LESS.
3. TIES ARE NOT REQUIRED FOR BELL PIPE 24" AND SMALLER. ON OTHER SIZES, TIE MAY BE INSERTED FROM INSIDE.
4. CUT THREADS MAY BE USED IF WASHER AND NUT ARE USED.
5. PIPE SIZES LISTED ARE INSIDE DIAMETER OF ROUND PIPE OR EQUIVALENT DIAMETER OF PIPE ARCH.

CONCRETE PIPE JOINT TIES

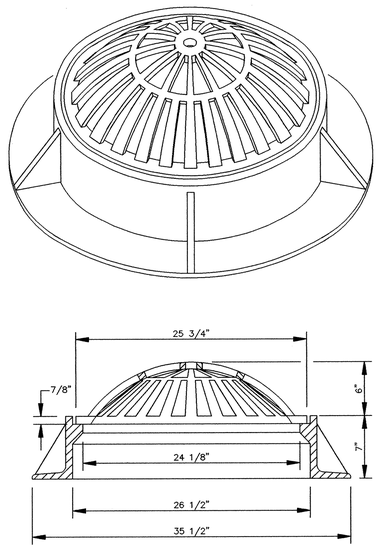

BEEHIVE CASTING

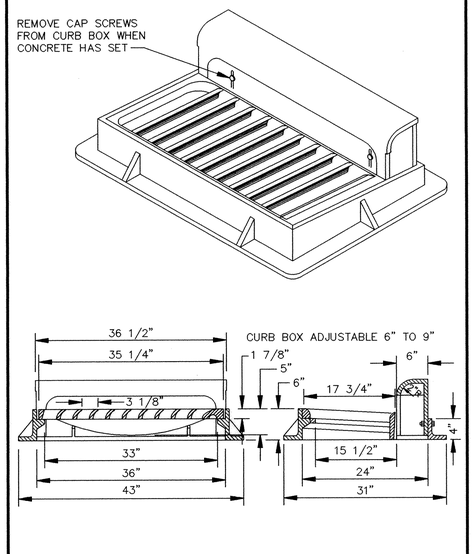

STANDARD INLET CASTING

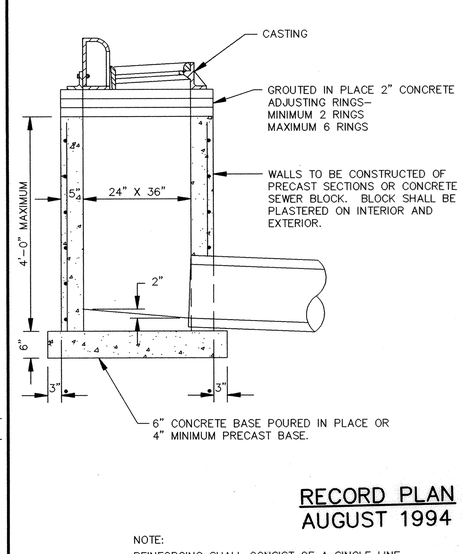

RECORD PLAN
AUGUST 1994

NOTE:
REINFORCING SHALL CONSIST OF A SINGLE LINE OF STEEL WIRE FABRIC HAVING AN AREA OF NOT LESS THAN 0.17 SQ. IN. PER FOOT OF HEIGHT.

SHALLOW CATCH BASIN

ER199-D4

I HEREBY CERTIFY THAT THIS PLAN, SPECIFICATION, OR REPORT WAS PREPARED BY ME OR UNDER MY DIRECT SUPERVISION AND THAT I AM A DULY REGISTERED PROFESSIONAL ENGINEER UNDER THE LAWS OF THE STATE OF MINNESOTA.
Mark V. Graham
DATE 10/27/93 REG. NO. 19130

MSA CONSULTING ENGINEERS
1326 ENERGY PARK DRIVE
ST. PAUL, MINNESOTA 55108
(612) 644-4389
9800 SHELARD PARKWAY
MINNEAPOLIS, MINNESOTA 55441
(612) 546-0432

REVISIONS	DATE	DESCRIPTION

DESIGNED
CHECKED
DRAWN CLS
GRAPHIC SCALE
0 HORIZ.
0 VERT.

CITY OF ELK RIVER
HILLSIDE ESTATES SECOND ADDITION
STORM SEWER DETAILS

DATE OCT. 1993 | SHEET 7 OF 7 SHEETS | PROJECT NO. 230-199

712

DRAWING NUMBER
DRAWING NUMBER
DRAWING NUMBER
7
HILLSE2.94