NOTE :

GRADE TO PROPOSED FINISHED STREET CENTERLINE.

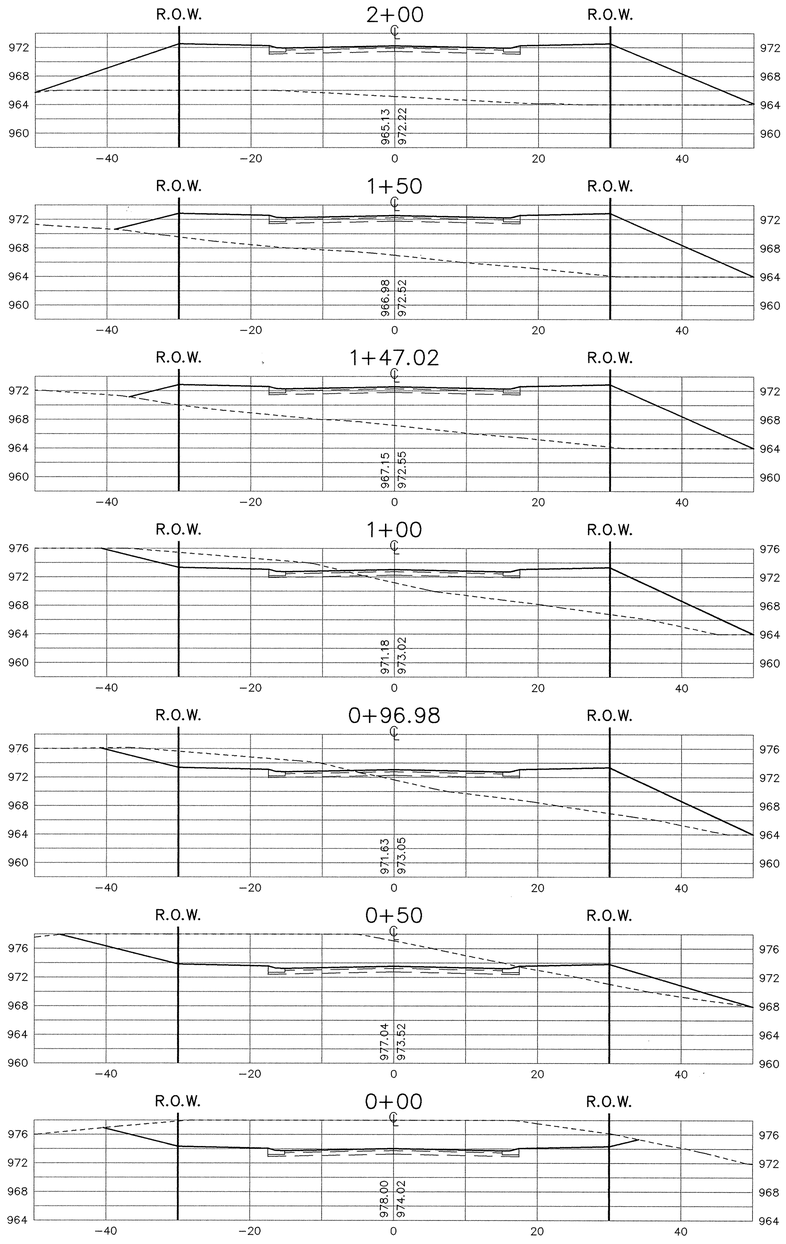

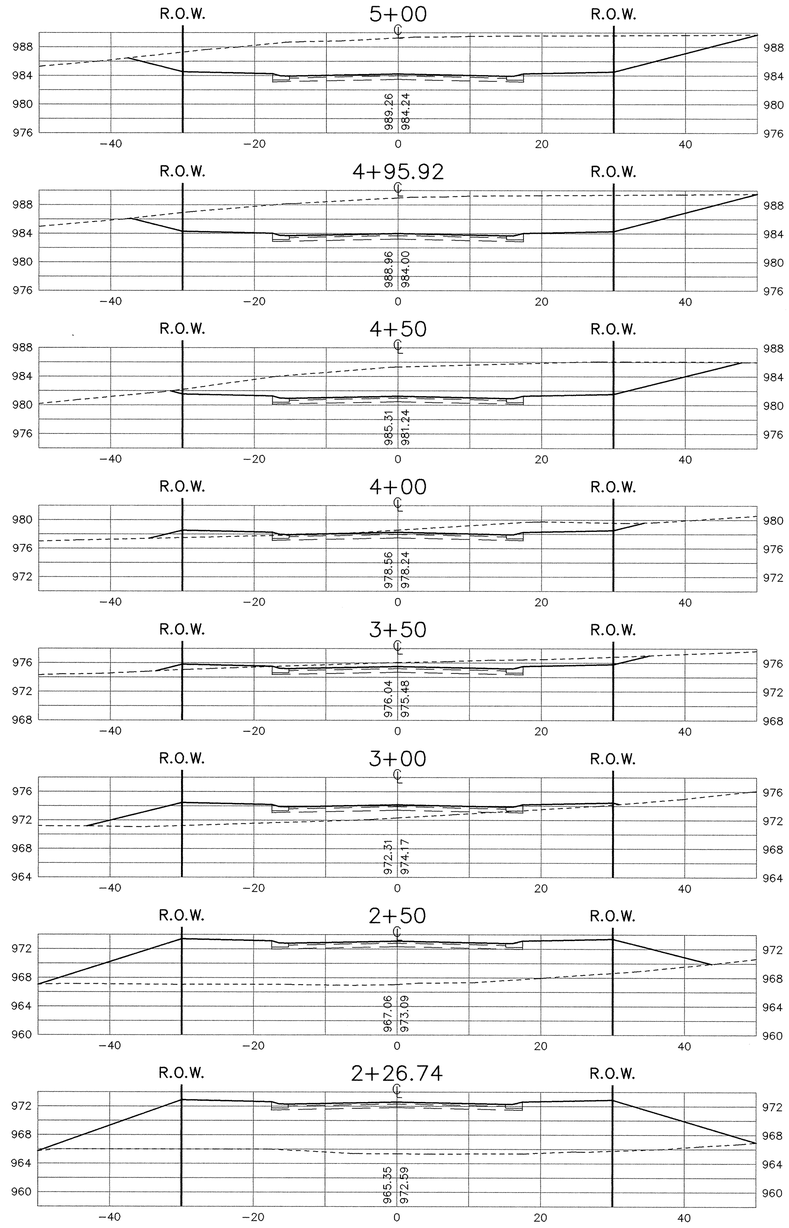

RECORD PLAN
JUNE 1994

I HEREBY CERTIFY THAT THIS PLAN, SPECIFICATION, OR REPORT WAS PREPARED BY ME OR UNDER MY DIRECT SUPERVISION AND THAT I AM A DULY REGISTERED PROFESSIONAL ENGINEER UNDER THE LAWS OF THE STATE OF MINNESOTA.

Mark V. Gustafson

DATE 10/21/93 REG. NO. 19130

MSA CONSULTING ENGINEERS

1326 ENERGY PARK DRIVE
ST. PAUL, MINNESOTA 55108
(612) 644-4389

9800 SHELARD PARKWAY
MINNEAPOLIS, MINNESOTA 55441
(612) 546-0432

REVISIONS	DATE	DESCRIPTION

DESIGNED
CHECKED
DRAWN CLS
GRAPHIC SCALE
0 HORIZ. 10
0 VERT. 5

CITY OF ELK RIVER
FUTURE STREET
CROSS SECTIONS

STA.
0+00 TO 5+00

DATE OCT. 1993 | SHEET 8 OF 12 SHEETS | PROJECT NO. 230-190

DRAWING NUMBER
DRAWING NUMBER
DRAWING NUMBER
HILLSE3N.93
8
SOFCO PRODUCTS • NEW HOPE, MINNESOTA
REORDER BY PART NUMBER 6582