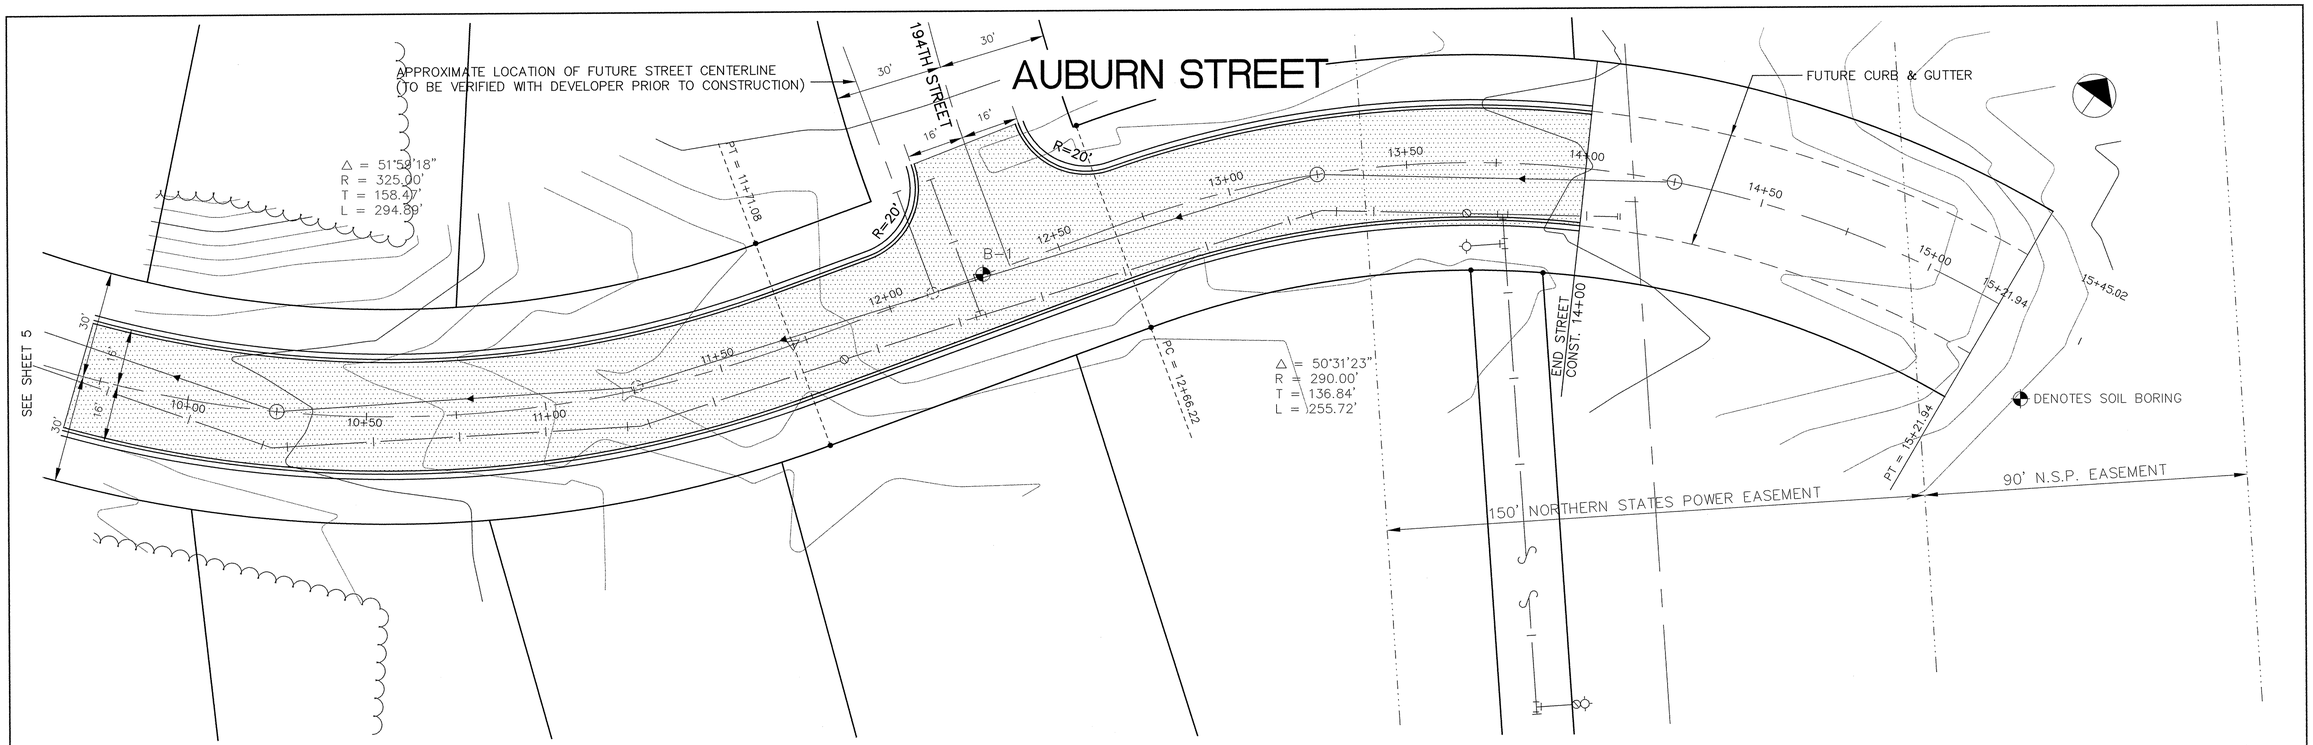

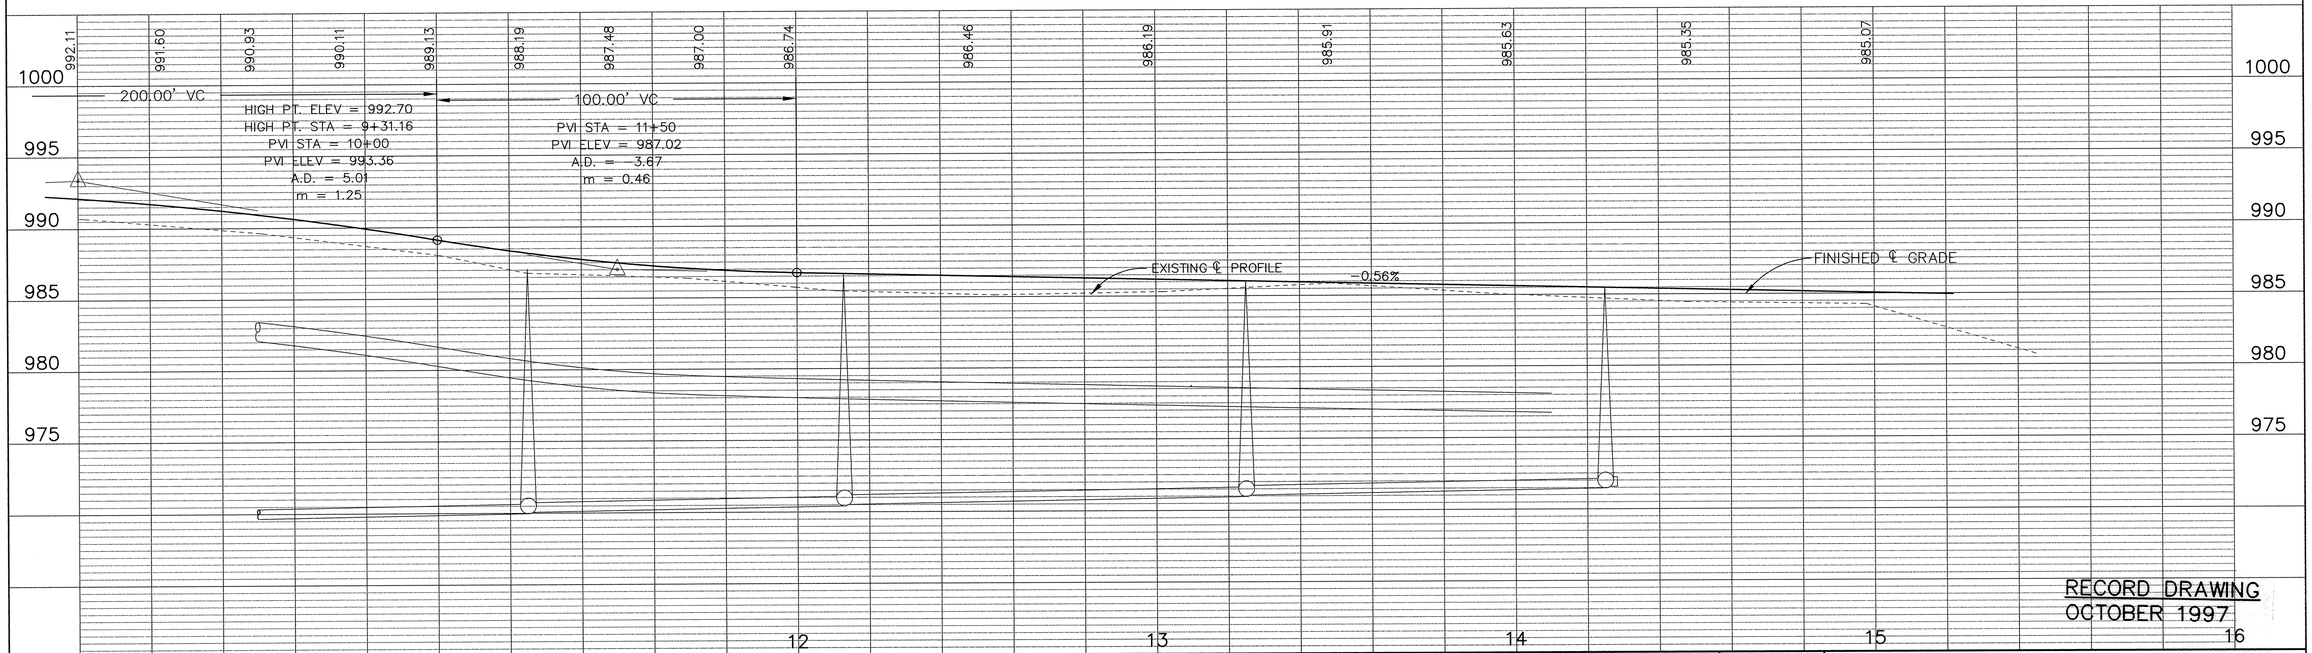

RECORD DRAWING
OCTOBER 1997

I HEREBY CERTIFY THAT THIS PLAN, SPECIFICATION, OR REPORT WAS PREPARED BY ME OR UNDER MY DIRECT SUPERVISION AND THAT I AM A DULY REGISTERED PROFESSIONAL ENGINEER UNDER THE LAWS OF THE STATE OF MINNESOTA.
Steven J. Maurer
DATE 10/10/94 REG. NO. 15376

MSA CONSULTING ENGINEERS
1326 ENERGY PARK DRIVE
ST. PAUL, MINNESOTA 55108
(612) 644-4389
9800 SHELARD PARKWAY
MINNEAPOLIS, MINNESOTA 55441
(612) 546-0432

REVISIONS	DATE	DESCRIPTION

DESIGNED LCS
CHECKED
DRAWN LCS
GRAPHIC SCALE
0 HORIZ. 20
0 VERT. 5

CITY OF ELK RIVER
SANITARY SEWER AND WATERMAIN
AUBURN STREET
STA. 10+50 TO 15+21.94

DATE SEPT. 1994 | SHEET 6 OF 15 SHEETS | PROJECT NO. 230-223

ER190-7

1115

DRAWING NUMBER

SARCO PRODUCTS • NEW HOPE, MINNESOTA
REORDER BY PART NUMBER 6906

DRAWING NUMBER

SARCO PRODUCTS • NEW HOPE, MINNESOTA
REORDER BY PART NUMBER 6906

DRAWING NUMBER
HILLSE3.94
6

SARCO PRODUCTS • NEW HOPE, MINNESOTA
REORDER BY PART NUMBER 6906

Wed Oct 12 12:33:52 1994