12+00

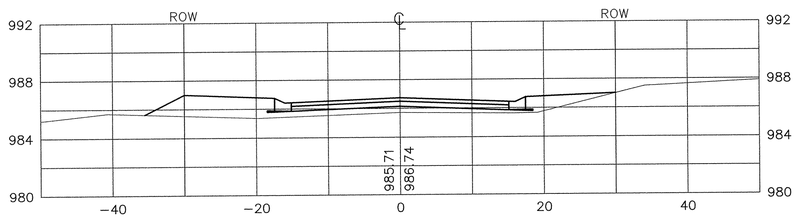

13+50

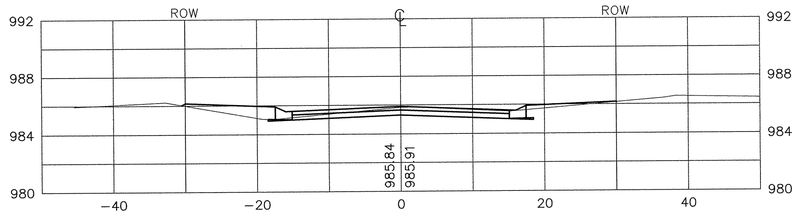

11+50

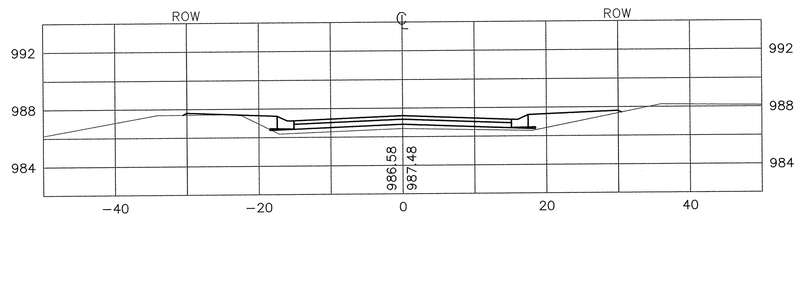

13+00

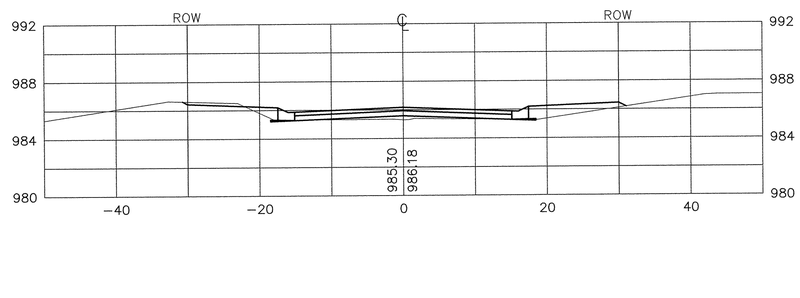

11+00

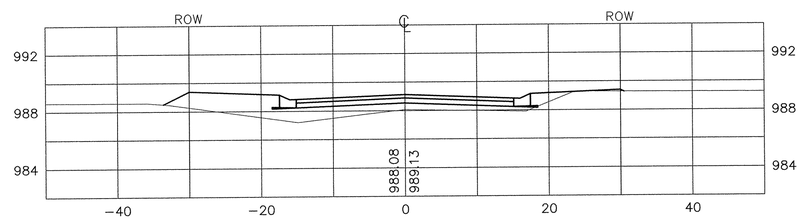

12+50

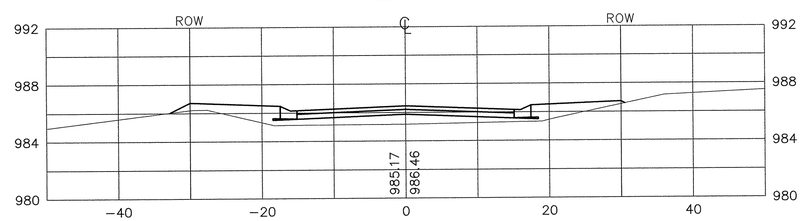

RECORD DRAWING
OCTOBER 1997

I HEREBY CERTIFY THAT THIS PLAN, SPECIFICATION, OR REPORT WAS PREPARED BY ME OR UNDER MY DIRECT SUPERVISION AND THAT I AM A DULY REGISTERED PROFESSIONAL ENGINEER UNDER THE LAWS OF THE STATE OF MINNESOTA.

DATE 10/10/97 REG.NO. 15316

MSA CONSULTING ENGINEERS

1326 ENERGY PARK DRIVE
ST. PAUL, MINNESOTA 55108
(612) 644-4389

9800 SHELARD PARKWAY
MINNEAPOLIS, MINNESOTA 55441
(612) 546-0432

REVISIONS	DATE	DESCRIPTION

DESIGNED
CHECKED
DRAWN

GRAPHIC SCALE
0 10
0 VERT. 5

CITY OF ELK RIVER
AUBURN STREET
CROSS SECTIONS
11+00 TO 13+50

DATE SEPT 1994 | SHEET 13 OF 15 SHEETS | PROJECT NO. 230-227

1108

ER227X-1

Wed Oct 12 12:43:15 1994

DRAWING NUMBER
HILLSE3.94
13

SARCO PRODUCTS • NEW HOPE, MINNESOTA
REORDER BY PART NUMBER 6592