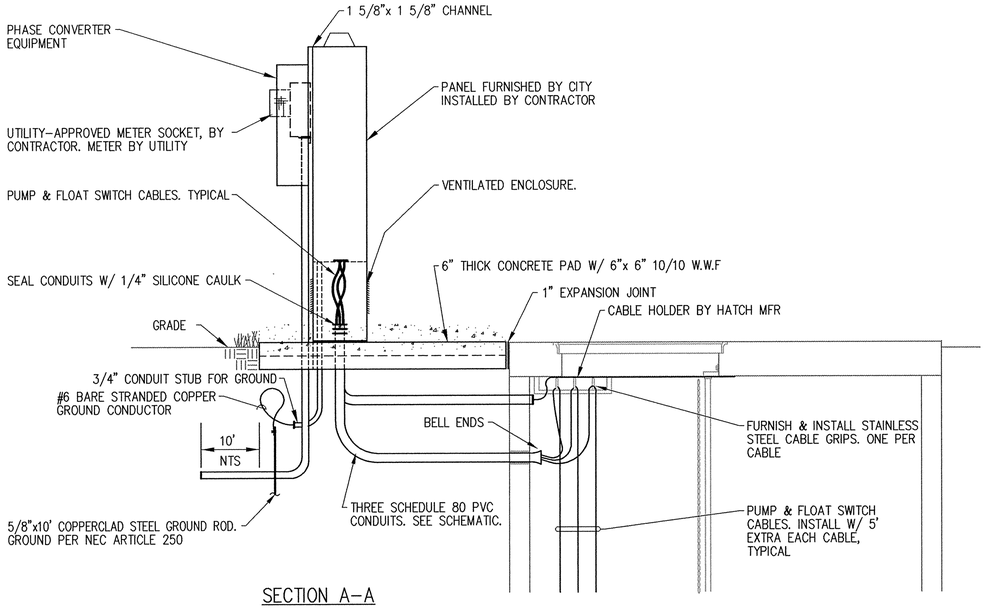

SECTION A–A

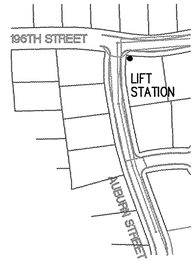

SITE PLAN
NO SCALE

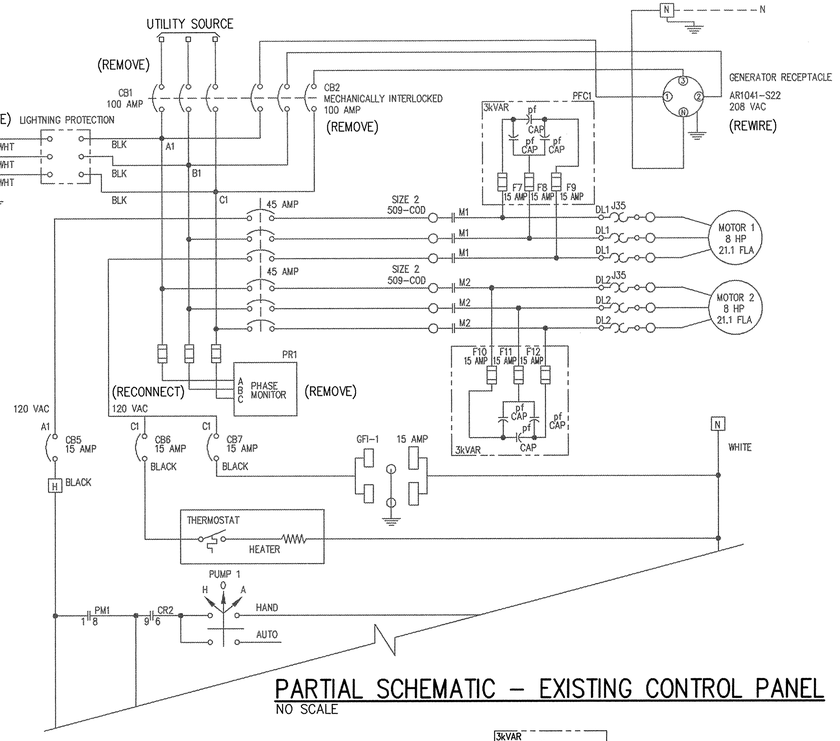

PARTIAL SCHEMATIC – EXISTING CONTROL PANEL
NO SCALE

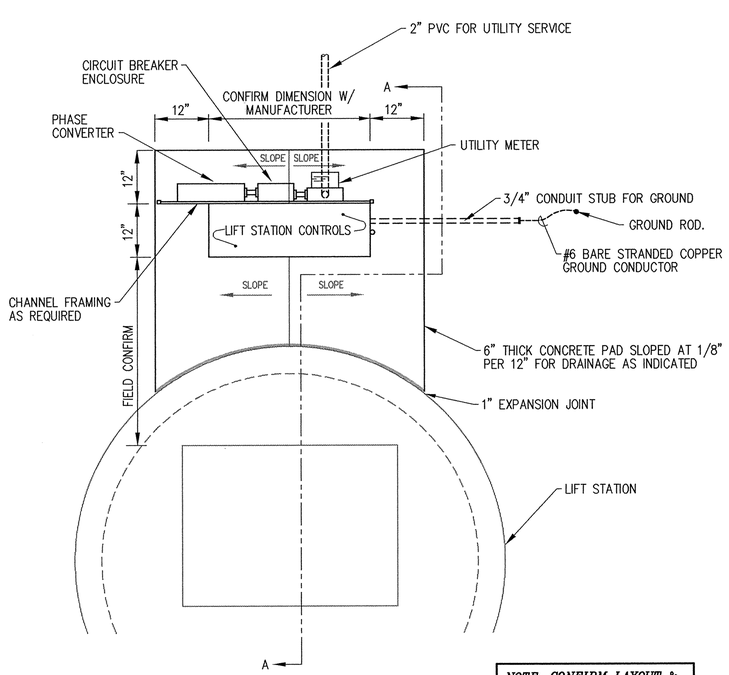

LIFT STATION DETAILS
NO SCALE

NOTE: CONFIRM LAYOUT & ORIENTATION W/ OWNER, ENGINEER & SERVING UTILITY

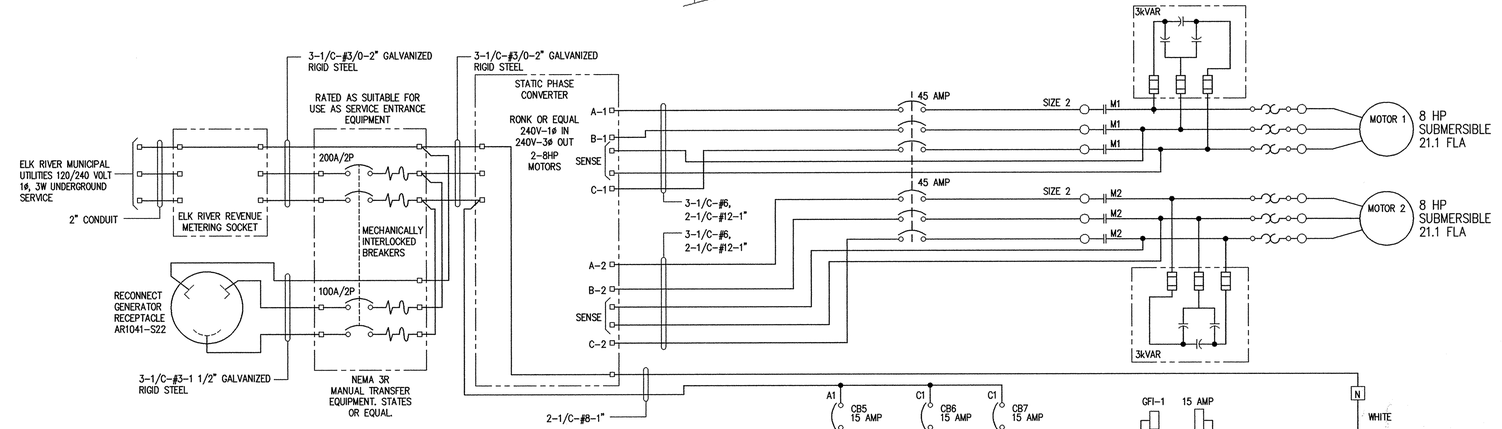

PARTIAL SCHEMATIC – EXISTING CONTROL PANEL – REVISED
NO SCALE

RECORD PLAN
JANUARY 1997

© 1996 Kaeding and Associates, Inc.

I HEREBY CERTIFY THAT THIS PLAN, SPECIFICATION, OR REPORT WAS PREPARED BY ME OR UNDER MY DIRECT SUPERVISION AND THAT I AM A DULY REGISTERED PROFESSIONAL ENGINEER UNDER THE LAWS OF THE STATE OF MINNESOTA.

DATE 05 AUG 96 REG.NO. 9955

MSA CONSULTING ENGINEERS
1326 ENERGY PARK DRIVE
ST. PAUL, MINNESOTA 55108
(612) 644–4389

REVISIONS

DATE	DESCRIPTION

DESIGNED PFK
CHECKED PFK
DRAWN CML
GRAPHIC SCALE
0 HORIZ.
0 VERT.

CITY ELK RIVER

HILLSIDE ESTATES FIFTH ADDITION
ELECTRICAL DRAWING

DATE JUL 1996 | SHEET 12 OF 16 SHEETS | PROJECT NO. 230–292

1063

DRAWING NUMBER
HILLSE5.96
12

SAFCO PRODUCTS • NEW HOPE, MINNESOTA
REORDER BY PART NUMBER 6562