# AS-BUILT PLANS FOR
# HILLSIDE ESTATES 9TH ADDITION
## UTILITY AND STREET IMPROVEMENTS
CITY OF ELK RIVER, MINNESOTA

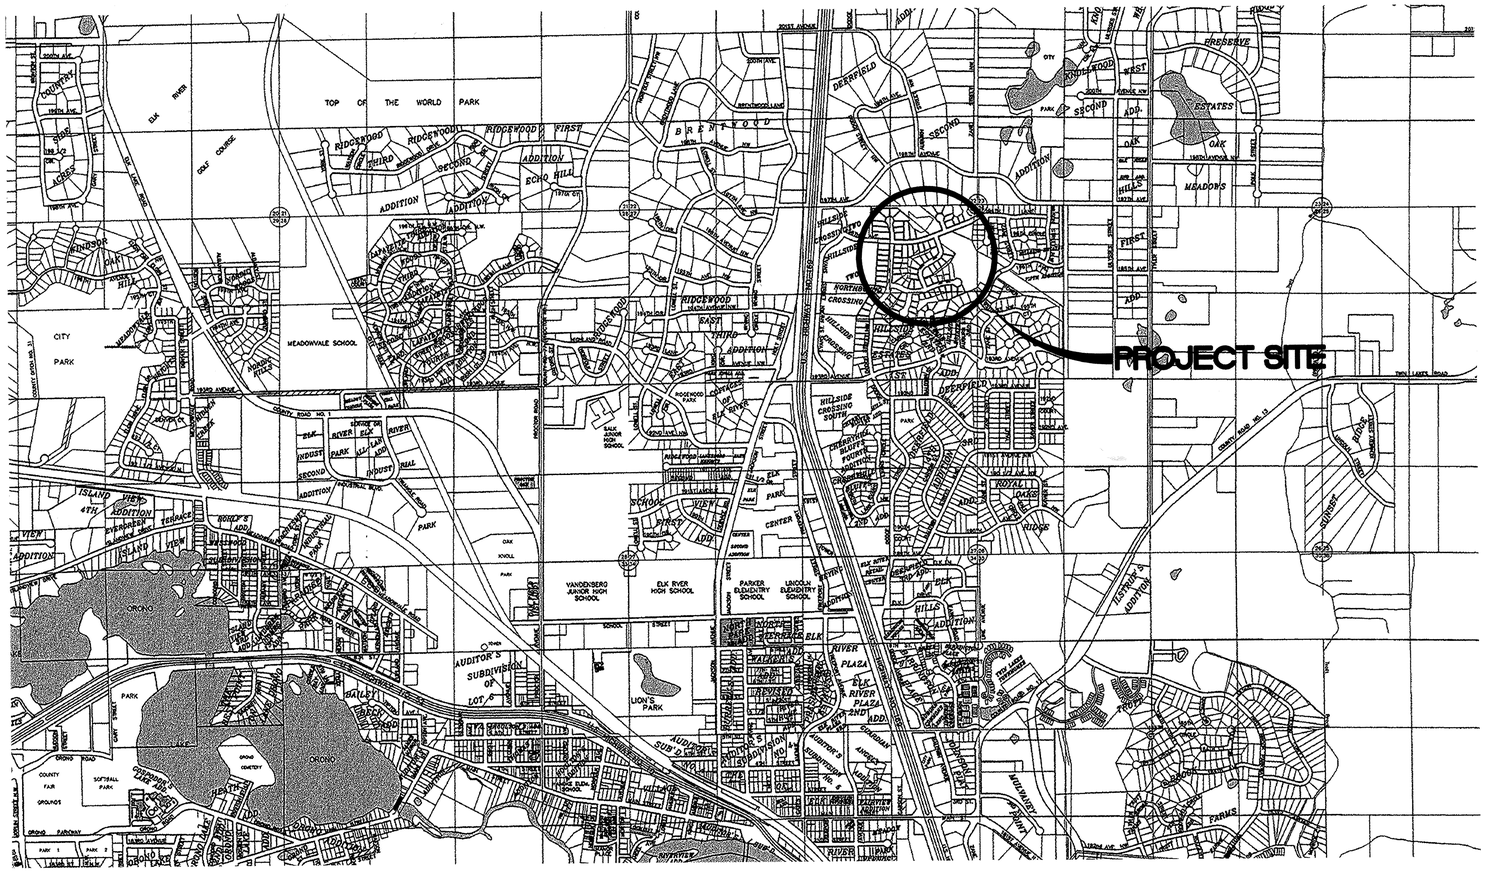


# PHASE 1

N

## INDEX:

### PHASE 1


| | |
|---|---|
| C1 | COVER SHEET |
| L1 | UTILITY OVERVIEW |
| U1–U4 | 196TH AVENUE NW – PLAN AND PROFILE |
| U5 | 196TH AVE. NW & BALDWIN AVE. – PLAN AND PROFILE |
| U6 | CARLSON CIRCLE – PLAN AND PROFILE |
| U7–U8 | STORM SEWER – PLAN AND PROFILES |
| U9 | AUBURN CIRCLE – PLAN AND PROFILE |
| D1 | SANITARY SEWER DETAILS |
| D2 | WATERMAIN DETAILS |
| D3 | STORM SEWER DETAILS |
| D4 | STREET CONSTRUCTION DETAILS |


RECORD DRAWING - JANUARY 2004

DRAWN GSO
DATE 5/12/03
SCALE 1"=80'
PROJECT 2001101.001
CHECKED
APPROVED

AS-BUILT UTILITY AND STREET PLAN
COVER SHEET
HILLSIDE ESTATES
9TH ADDITION
CITY OF ELK RIVER, MINNESOTA

OWNER/DEVELOPER
RIVERSIDE COMPANIES
19230 EVANS STREET
ELK RIVER, MINNESOTA
PHONE: 763-241-1801

METRO
LAND SURVEYING & ENGINEERING
412 East County Road D, Little Canada, MN 55117
Telephone: (651) 482-0132 Fax: (651) 482-0133
E-mail: metro@metrosurveying.com

I HEREBY CERTIFY THAT THIS PLAN, SPECIFICATION, OR REPORT WAS PREPARED BY ME OR UNDER MY DIRECT SUPERVISION AND THAT I AM A DULY LICENSED PROFESSIONAL ENGINEER UNDER THE LAWS OF THE STATE OF MINNESOTA.
JOHN C. JOHNSON
DATE 3/5/04 LICENSE NO. 11546

| DATE | REVISIONS | BY |
|---|---|---|

C1

DRAWING NUMBER
DRAWING NUMBER
DRAWING NUMBER
HILLSE9.04
1
SAECO PRODUCTS • NEW HOPE, MINNESOTA
REORDER BY PART NUMBER 6502