196TH LANE NW

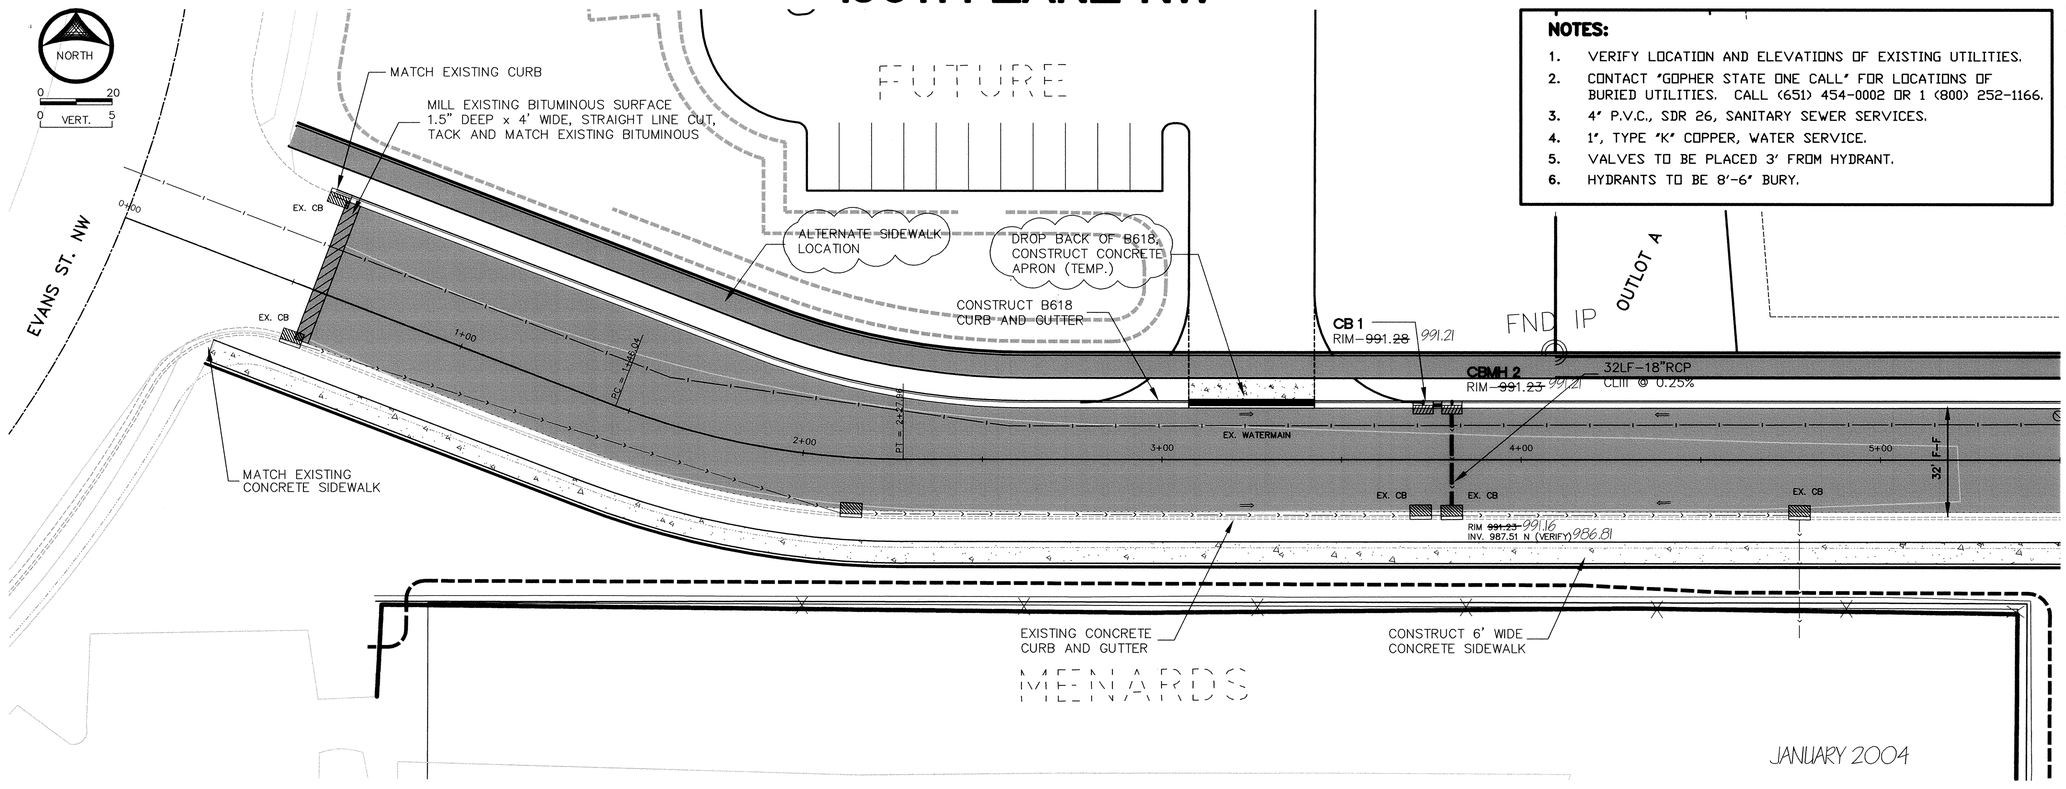

NOTES:

1. VERIFY LOCATION AND ELEVATIONS OF EXISTING UTILITIES.
2. CONTACT 'GOPHER STATE ONE CALL' FOR LOCATIONS OF BURIED UTILITIES. CALL (651) 454-0002 OR 1 (800) 252-1166.
3. 4" P.V.C., SDR 26, SANITARY SEWER SERVICES.
4. 1", TYPE 'K' COPPER, WATER SERVICE.
5. VALVES TO BE PLACED 3' FROM HYDRANT.
6. HYDRANTS TO BE 8'-6" BURY.

RECORD DRAWING - JANUARY 2004

SEE SHEET U2

JANUARY 2004

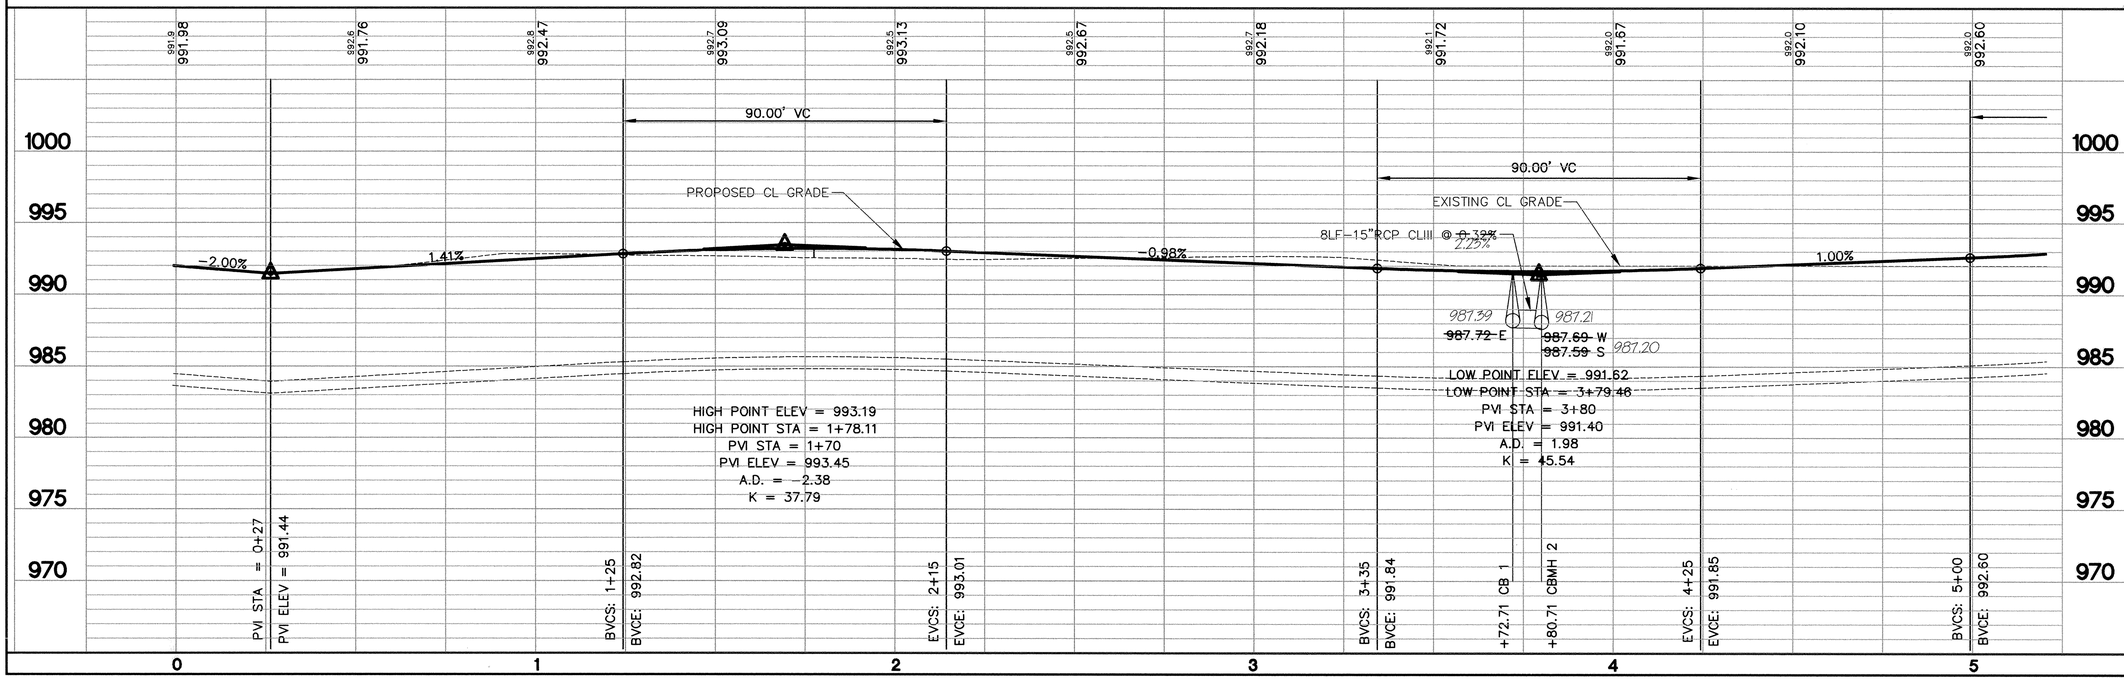

DRAWN MBW
DATE 1/26/04
SCALE 1"=50'
PROJECT 101.001
CHECKED
APPROVED

STORM SEWER AND STREET CONSTRUCTION
HILLSIDE ESTATES 9TH ADDITION
196TH LANE NW
STA. 0+00 TO 5+00
CITY OF ELK RIVER, MINNESOTA

OWNER/DEVELOPER
RIVERSIDE COMPANIES
19230 EVANS STREET, SUITE 115
ELK RIVER, MINNESOTA
PHONE: 763-241-1801

METRO
LAND SURVEYING & ENGINEERING
412 East County Road 4 White Bear Lake, MN 55127
Telephone: (651)766-0112 Fax: (651)766-0812
E-mail: survey@metrole.com

I HEREBY CERTIFY THAT THIS PLAN, SPECIFICATION, OR REPORT WAS PREPARED BY ME OR UNDER MY DIRECT SUPERVISION AND THAT I AM A DULY LICENSED PROFESSIONAL ENGINEER UNDER THE LAWS OF THE STATE OF MINNESOTA.
JOHN C. JOHNSON
DATE 3/2/05 LICENSE NO. 11546

DATE	REVISIONS	BY
6/25/03	PER CITY REVIEW	PK

U1

DRAWING NUMBER

DRAWING NUMBER
HILLSE9.04
3