# CARLSON CIRCLE

**NOTES:**

1. VERIFY LOCATION AND ELEVATIONS OF EXISTING UTILITIES.
2. CONTACT "GOPHER STATE ONE CALL" FOR LOCATIONS OF BURIED UTILITIES. CALL (651) 454-0002 OR 1 (800) 252-1166.
3. 4" P.V.C., SDR 26, SANITARY SEWER SERVICES.
4. 1", TYPE "K" COPPER, WATER SERVICE.
5. VALVES TO BE PLACED 3' FROM HYDRANT.
6. HYDRANTS TO BE 8'-6" BURY.

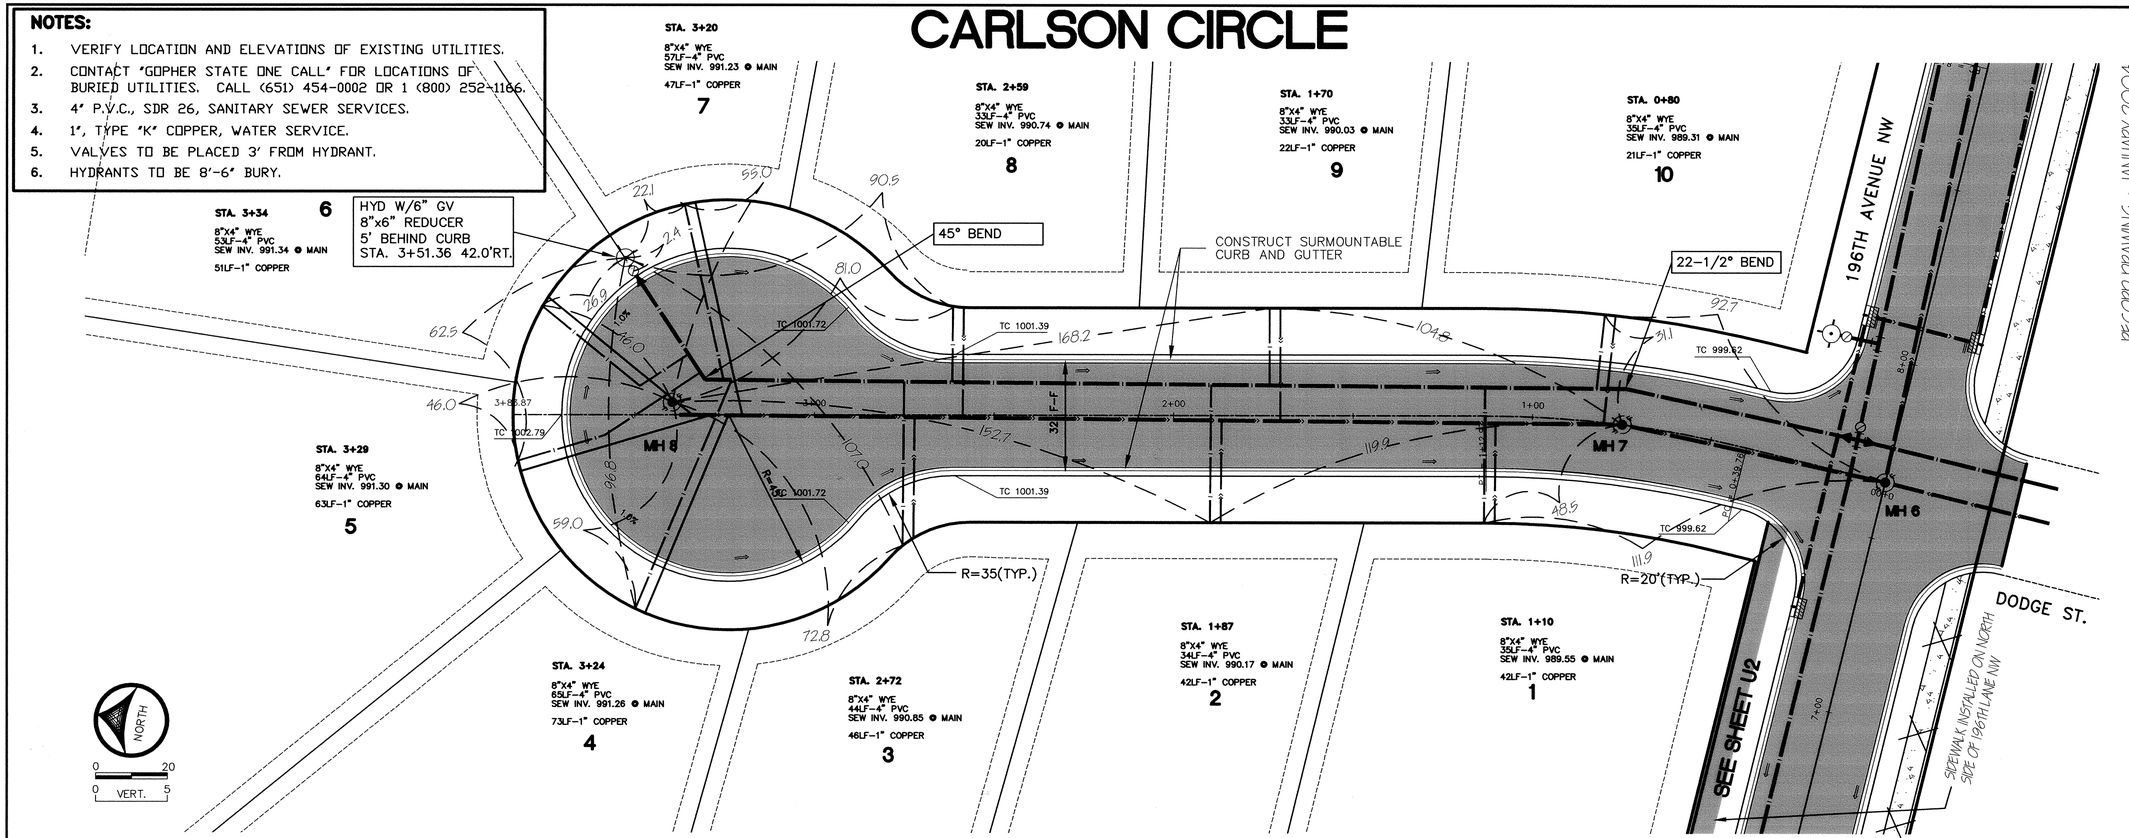


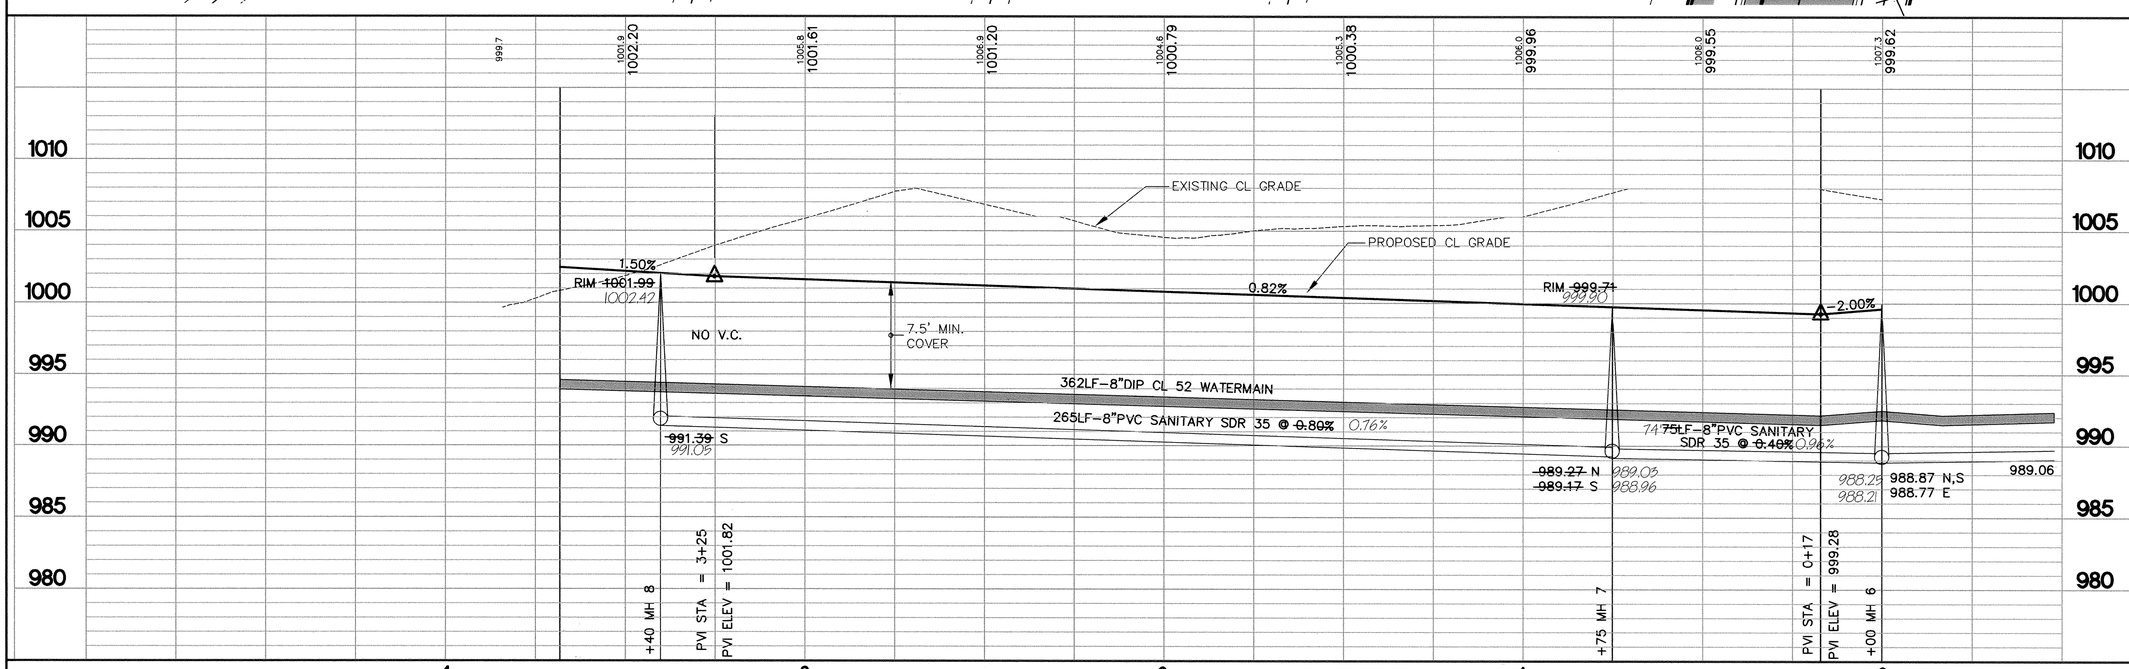


RECORD DRAWING - JANUARY 2004

DRAWN MBW
DATE 1/26/04
SCALE 1"=20
PROJECT R101.001
CHECKED
APPROVED

**SANITARY SEWER, WATERMAIN, STORM SEWER AND STREET CONSTRUCTION**
**HILLSIDE ESTATES 9TH ADDITION**
**196TH LANE NW**
**STA. 0+00 TO 5+00**
CITY OF ELK RIVER, MINNESOTA

OWNER/DEVELOPER
**RIVERSIDE COMPANIES**
19230 EVANS STREET, SUITE 115
ELK RIVER, MINNESOTA
PHONE: 763-241-1801

METRO LAND SURVEYING & ENGINEERING
412 East County Road D, Little Canada, MN 55117
Telephone: (651)766-0112 Fax: (651)766-0612
E-mail: survey@metrols.com

I HEREBY CERTIFY THAT THIS PLAN, SPECIFICATION, OR REPORT WAS PREPARED BY ME OR UNDER MY DIRECT SUPERVISION AND THAT I AM A DULY LICENSED PROFESSIONAL ENGINEER UNDER THE LAWS OF THE STATE OF MINNESOTA.

JOHN C. JOHNSON
DATE 3/21/05 LICENSE NO. 11546

| DATE | REVISIONS | BY |
|---|---|---|
| 6/25/03 | PER CITY REVIEW | PK |

U6

DRAWING NUMBER
HILLSE9.04
8