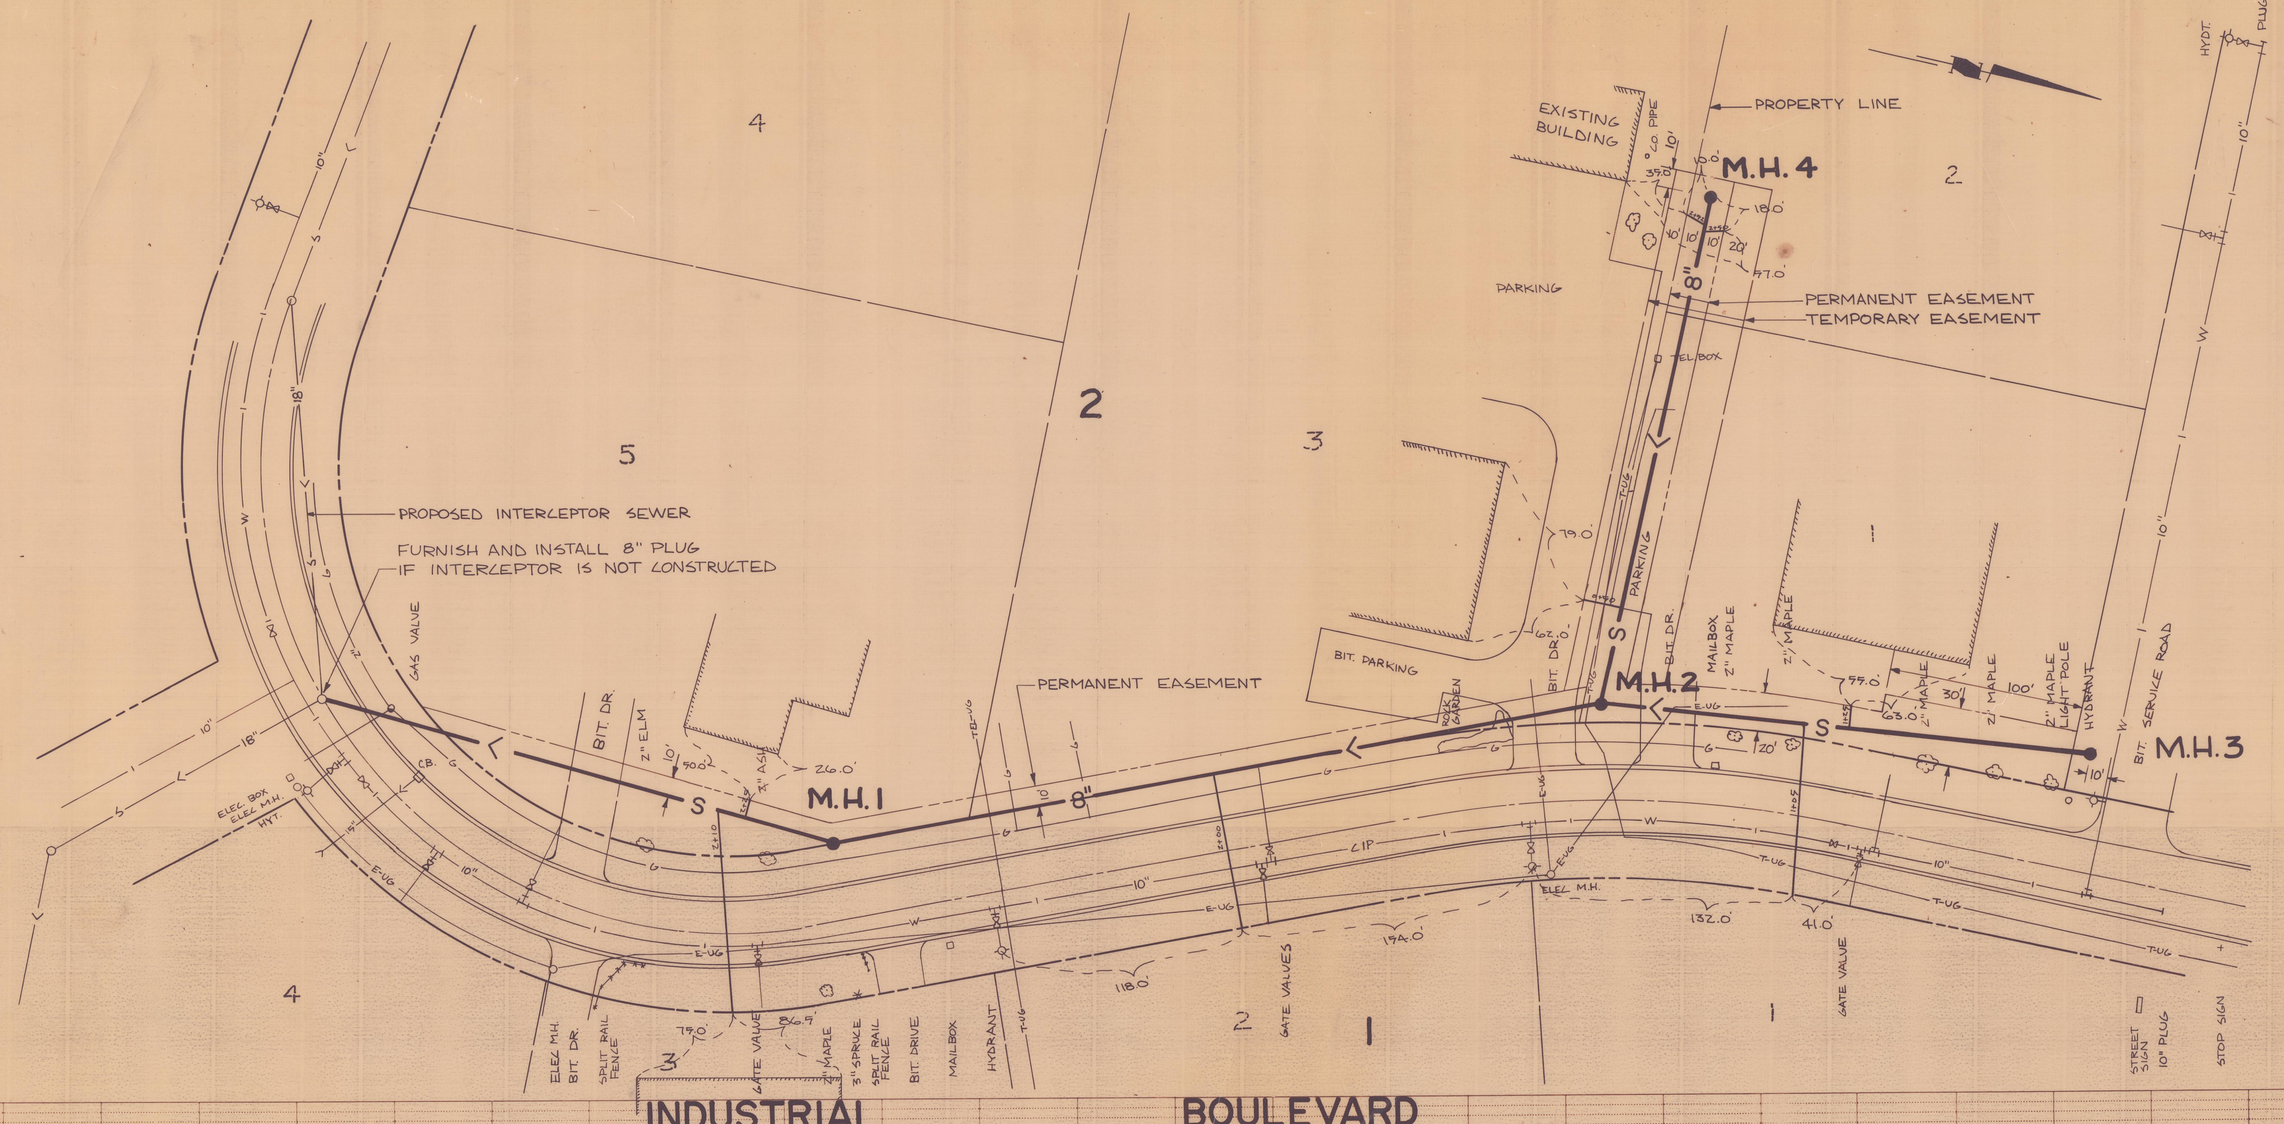

BENCHMARK:

Top nut of hydrant N.E. corner
Industrial Blvd. & Triangle Road.

Elevation: 913.82

Sanitary Sewer 8" PVC Pipe
Sanitary Sewer Service 4" & 6" CISP

THE LOCATIONS OF EXISTING UNDERGROUND UTILITIES ARE SHOWN IN AN APPROXIMATE WAY ONLY. THE EXCAVATING CONTRACTOR SHALL DETERMINE THE EXACT LOCATION OF ALL EXISTING UTILITIES BEFORE COMMENCING WORK. HE AGREES TO BE FULLY RESPONSIBLE FOR ANY AND ALL DAMAGES WHICH MIGHT BE OCCASIONED BY HIS FAILURE TO EXACTLY LOCATE AND PRESERVE ANY AND ALL UNDERGROUND UTILITIES.

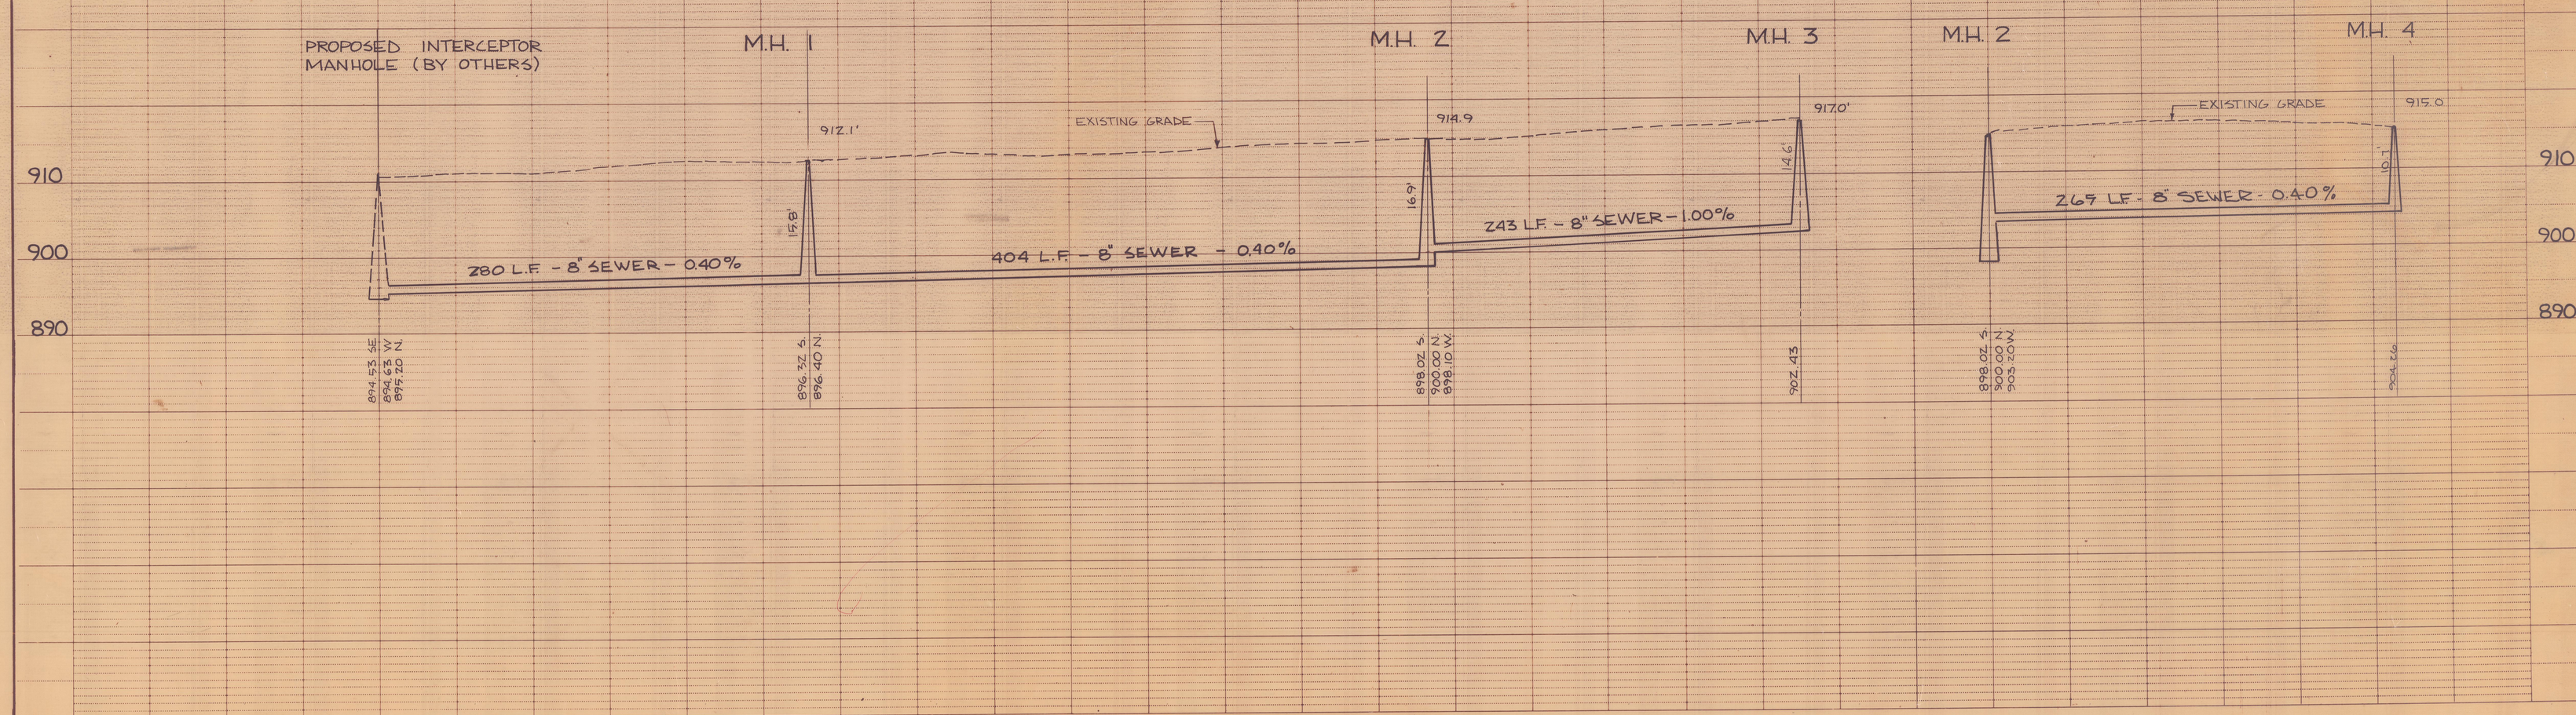

NO.	DATE	BY	REMARKS
C	1-8-82	T.L.C.	AS BUILT
B	11-16-81	M.R.J.	REVISED SEWER GRADE, EXTEND M.H.3
A	7-2-81	J.R.C.	REVISED DEPTH OF SEWER

REVISIONS

DESIGNED P.W.P.
DRAWN M.R.J.
DATE 3-23-81
CHECKED
APPROVED
COMM.

I HEREBY CERTIFY THAT THIS PLAN WAS PREPARED BY ME OR UNDER MY DIRECT SUPERVISION AND THAT I AM A DULY REGISTERED PROFESSIONAL ENGINEER UNDER THE LAWS OF THE STATE OF MINNESOTA.

Paul Pearson

DATE 3-31-81 REG. NO. 12795

McCOMBS-KNUTSON ASSOCIATES, INC.
CONSULTING ENGINEERS ■ LAND SURVEYORS ■ SITE PLANNERS
MINNEAPOLIS, HUTCHINSON and MARSHALL, MINNESOTA

SANITARY SEWER EXTENSIONS

CITY OF ELK RIVER, MINNESOTA

SCALE HORZ. 1" = 50' VERT. 1" = 10'
BOOK F160 L432 PAGE 50 14
FILE NO. 5934

ELK RIVER INDUSTRIAL PARK

SHEET 3 OF 4 REV. C