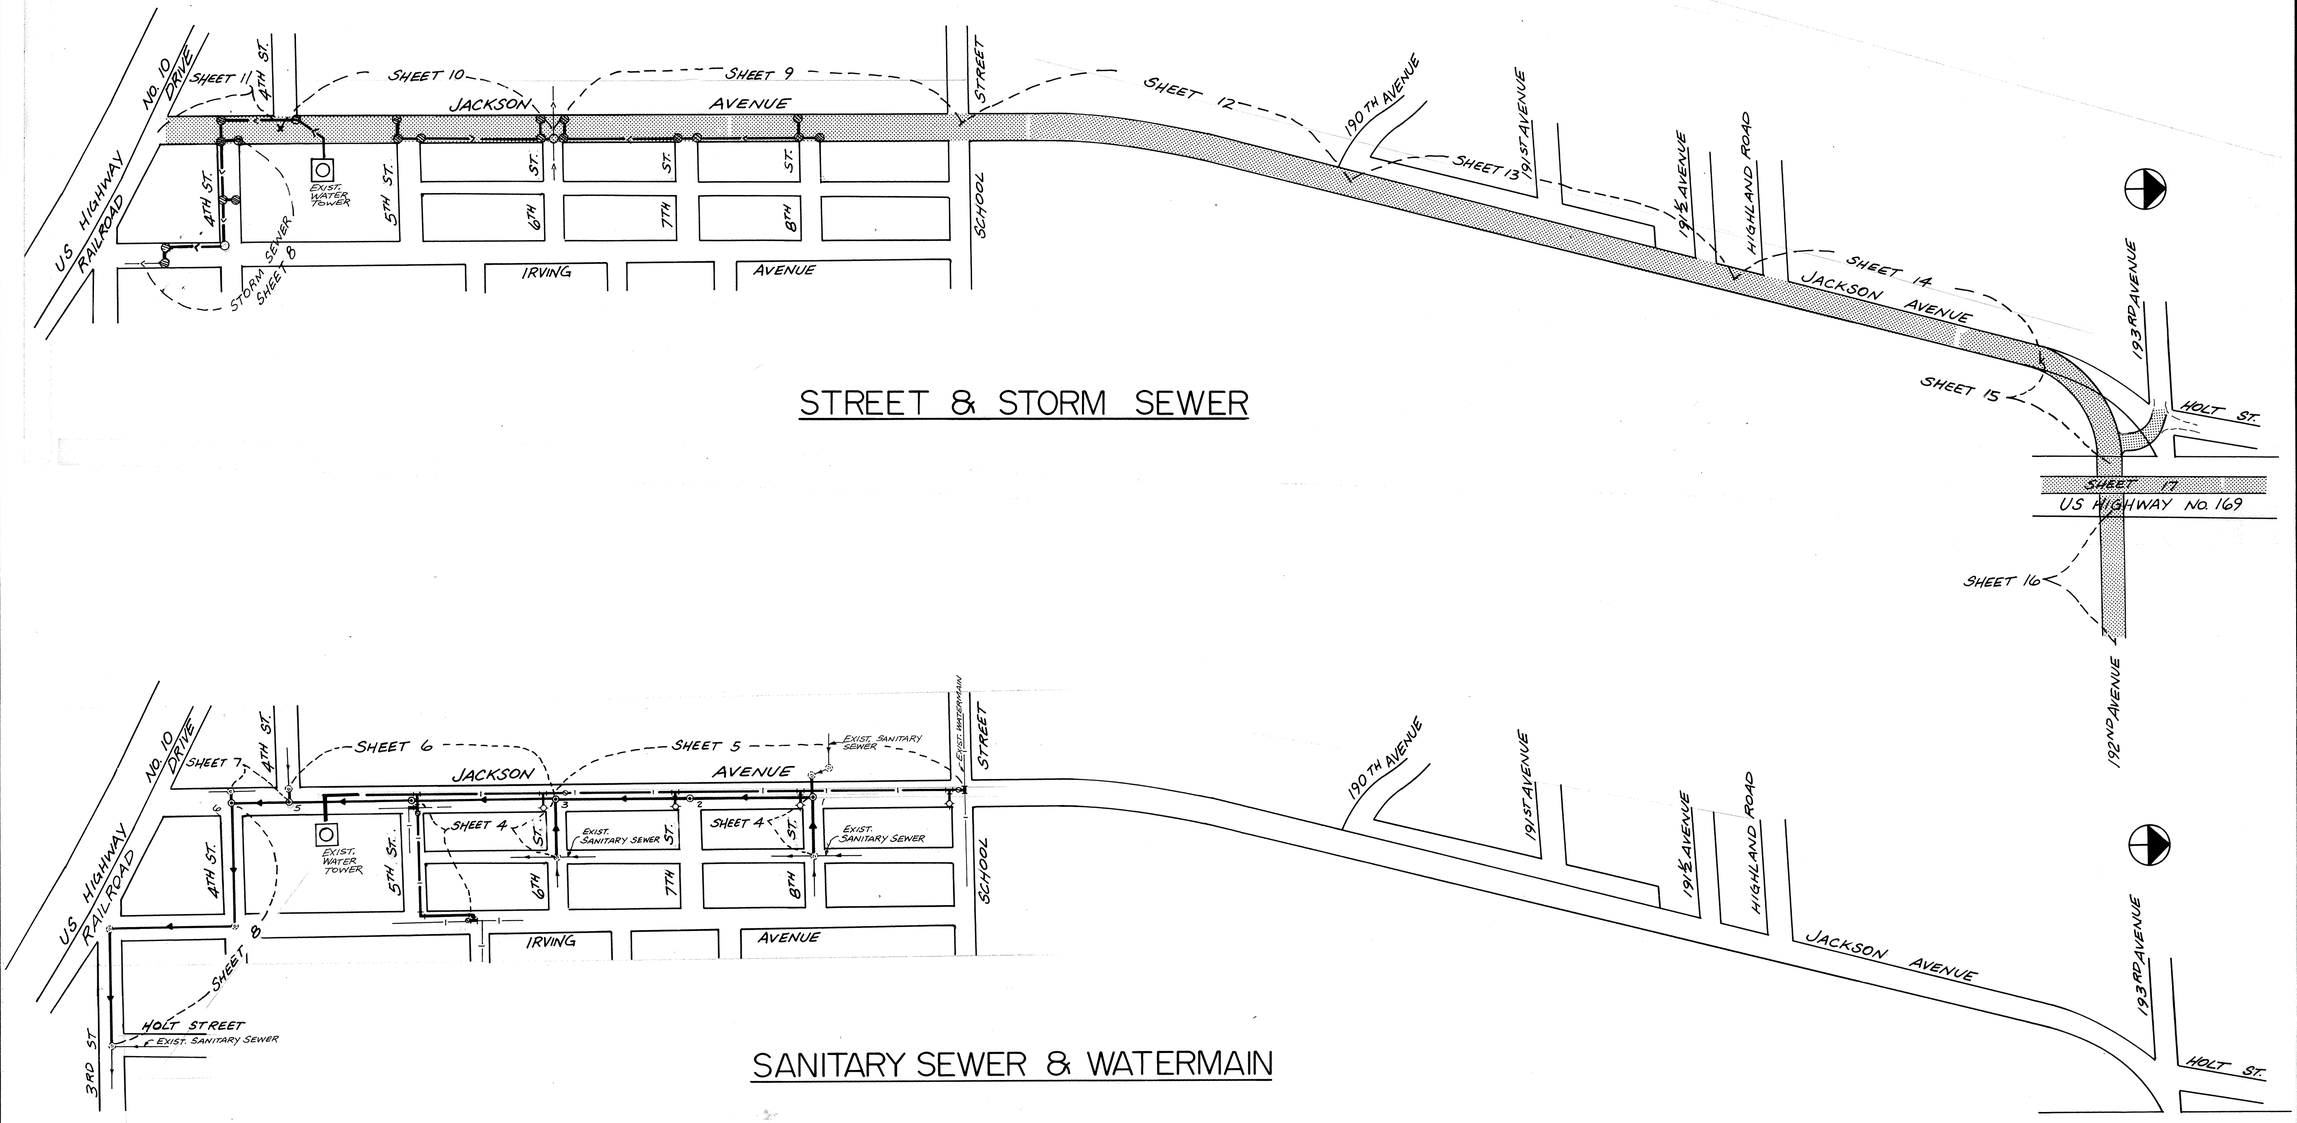

STREET & STORM SEWER

SANITARY SEWER & WATERMAIN

RECORD PLAN NOV. 1988

CONSULTING ENGINEERS
Maier Stewart & Associates Inc.
1959 SLOAN PLACE (612)774-6021 ST. PAUL, MINNESOTA 55117

REVISIONS	DATE	DESCRIPTION

DESIGNED
CHECKED
DRAWN ARJ
GRAPHIC SCALE
HORIZ. None
VERT.

CITY OF ELK RIVER
JACKSON AVENUE
LOCATION MAP

DATE AUG. 1987 | SHEET 3 OF 28 SHEETS | PROJECT NO. 230-032

223

DRAWING NUMBER
DRAWING NUMBER
DRAWING NUMBER
JACKS.87
3