8TH STREET

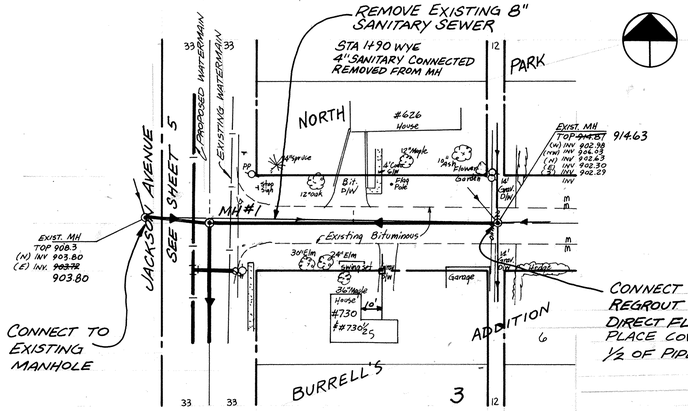

AT PROPERTY LINE/N. GARAGE WALL
10' EAST OF EAST CENTRAL WALL
4" SANITARY 10' BELOW ℄
STA. 1+20
WATER OFF JACKSON AVE
SEE SHEET 5

6TH STREET

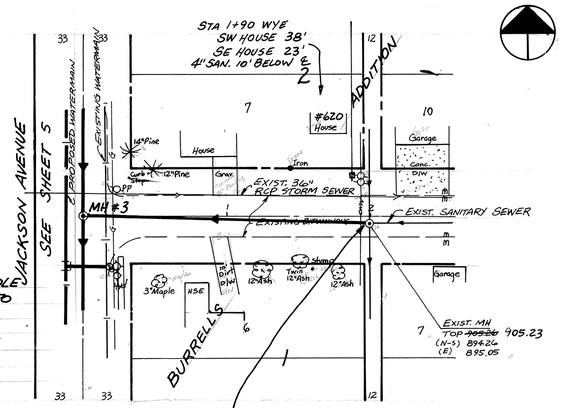

NOTE: SEE SHEET 8 FOR STREET RESTORATION DETAIL

5TH STREET/IRVING AVE.

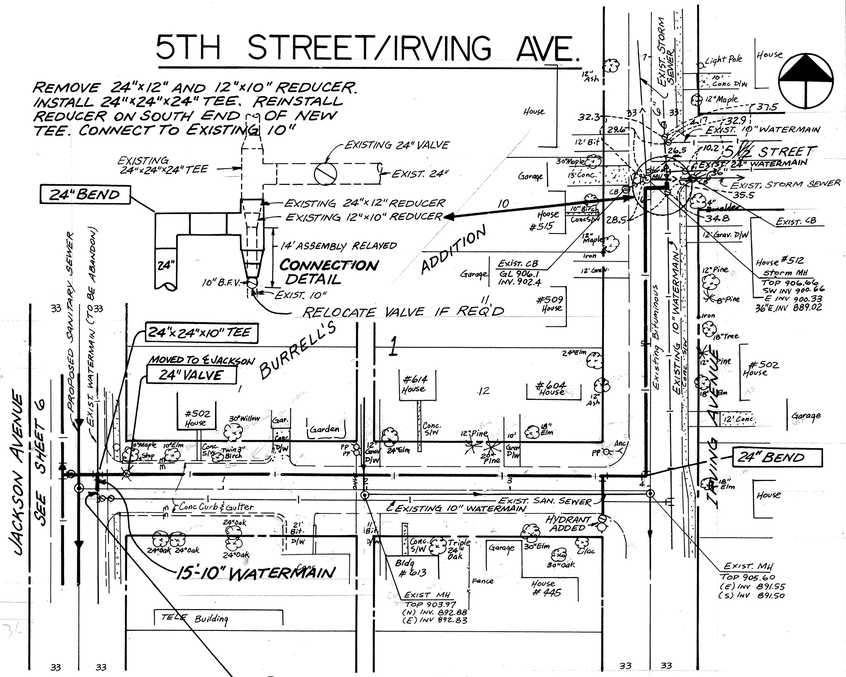

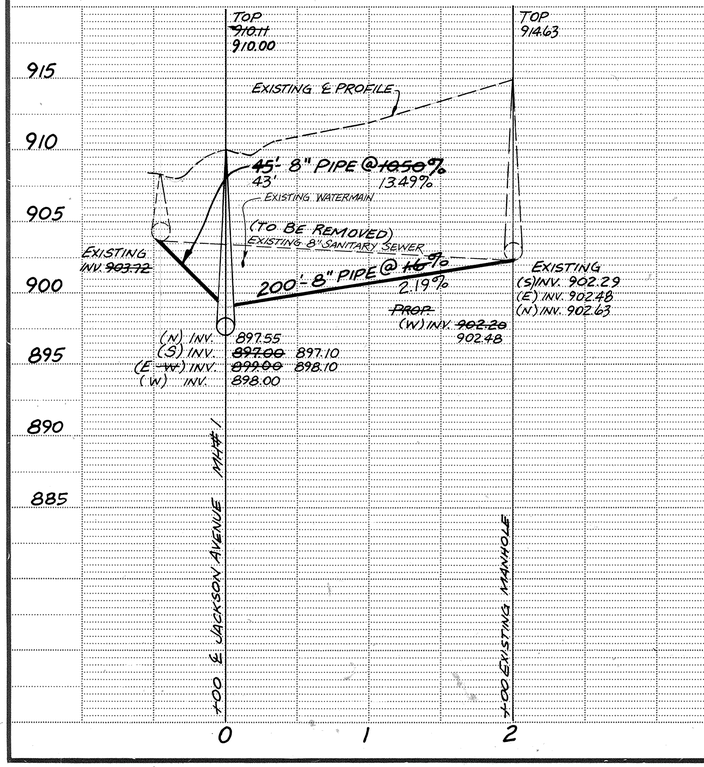

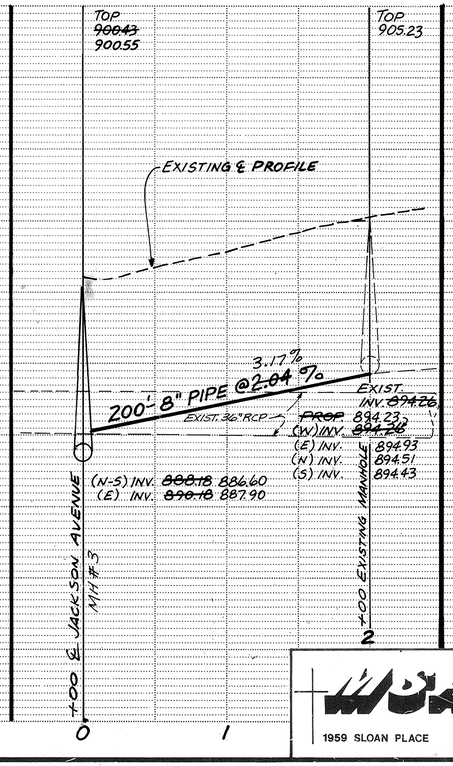

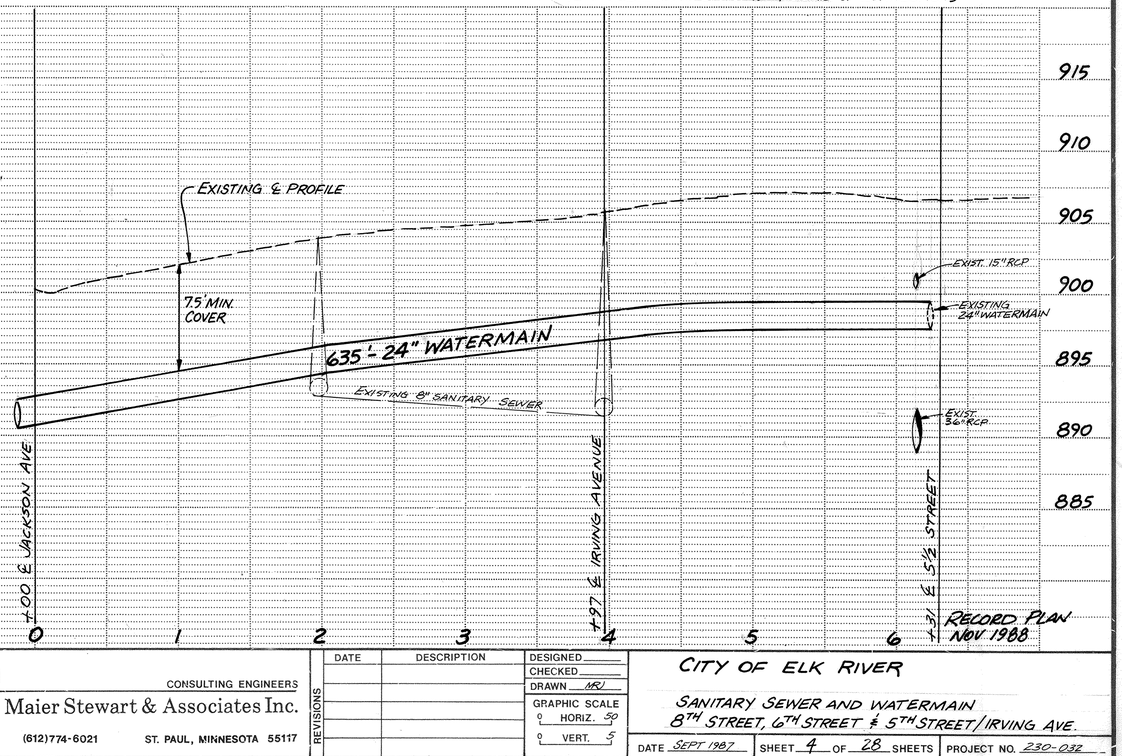

RECORD PLAN NOV. 1988

CONSULTING ENGINEERS	DESIGNED	CITY OF ELK RIVER
Maier Stewart & Associates Inc.	CHECKED	SANITARY SEWER AND WATERMAIN
1959 SLOAN PLACE (612)774-6021 ST. PAUL, MINNESOTA 55117	DRAWN MRI	8TH STREET, 6TH STREET & 5TH STREET/IRVING AVE.
REVISIONS: DATE / DESCRIPTION	GRAPHIC SCALE HORIZ. 50 VERT. 5	DATE SEPT 1987 SHEET 4 OF 28 SHEETS PROJECT NO. 230-032

222

DRAWING NUMBER

DRAWING NUMBER

DRAWING NUMBER
JACKS 87
4