JACKSON AVENUE

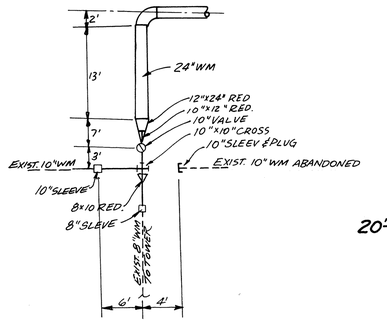

WATER TOWER TIE-IN

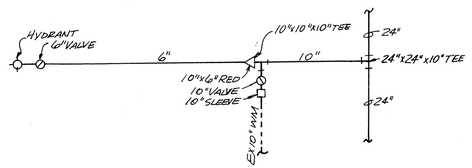

HYDRANT, 10"WM, 24"WM, AT 5TH ST & JACKSON AVE

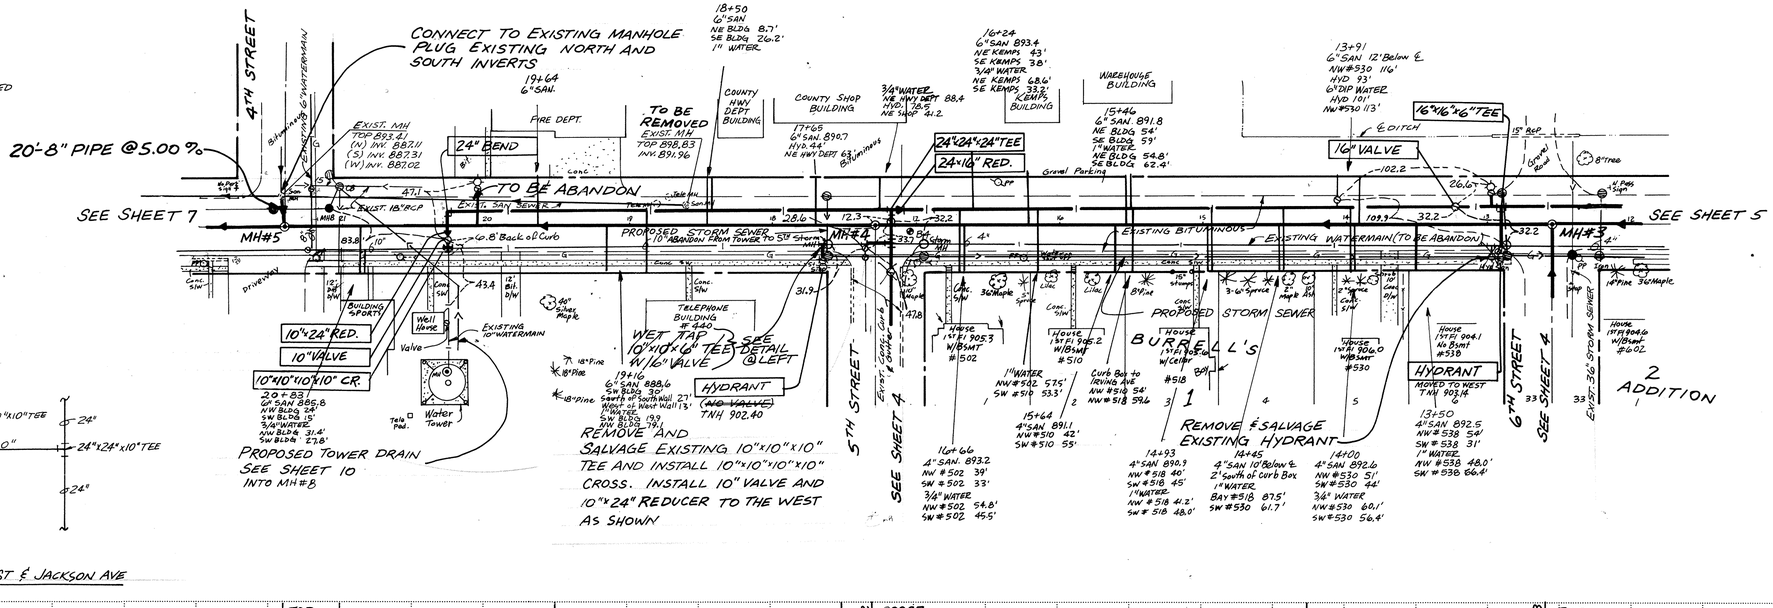

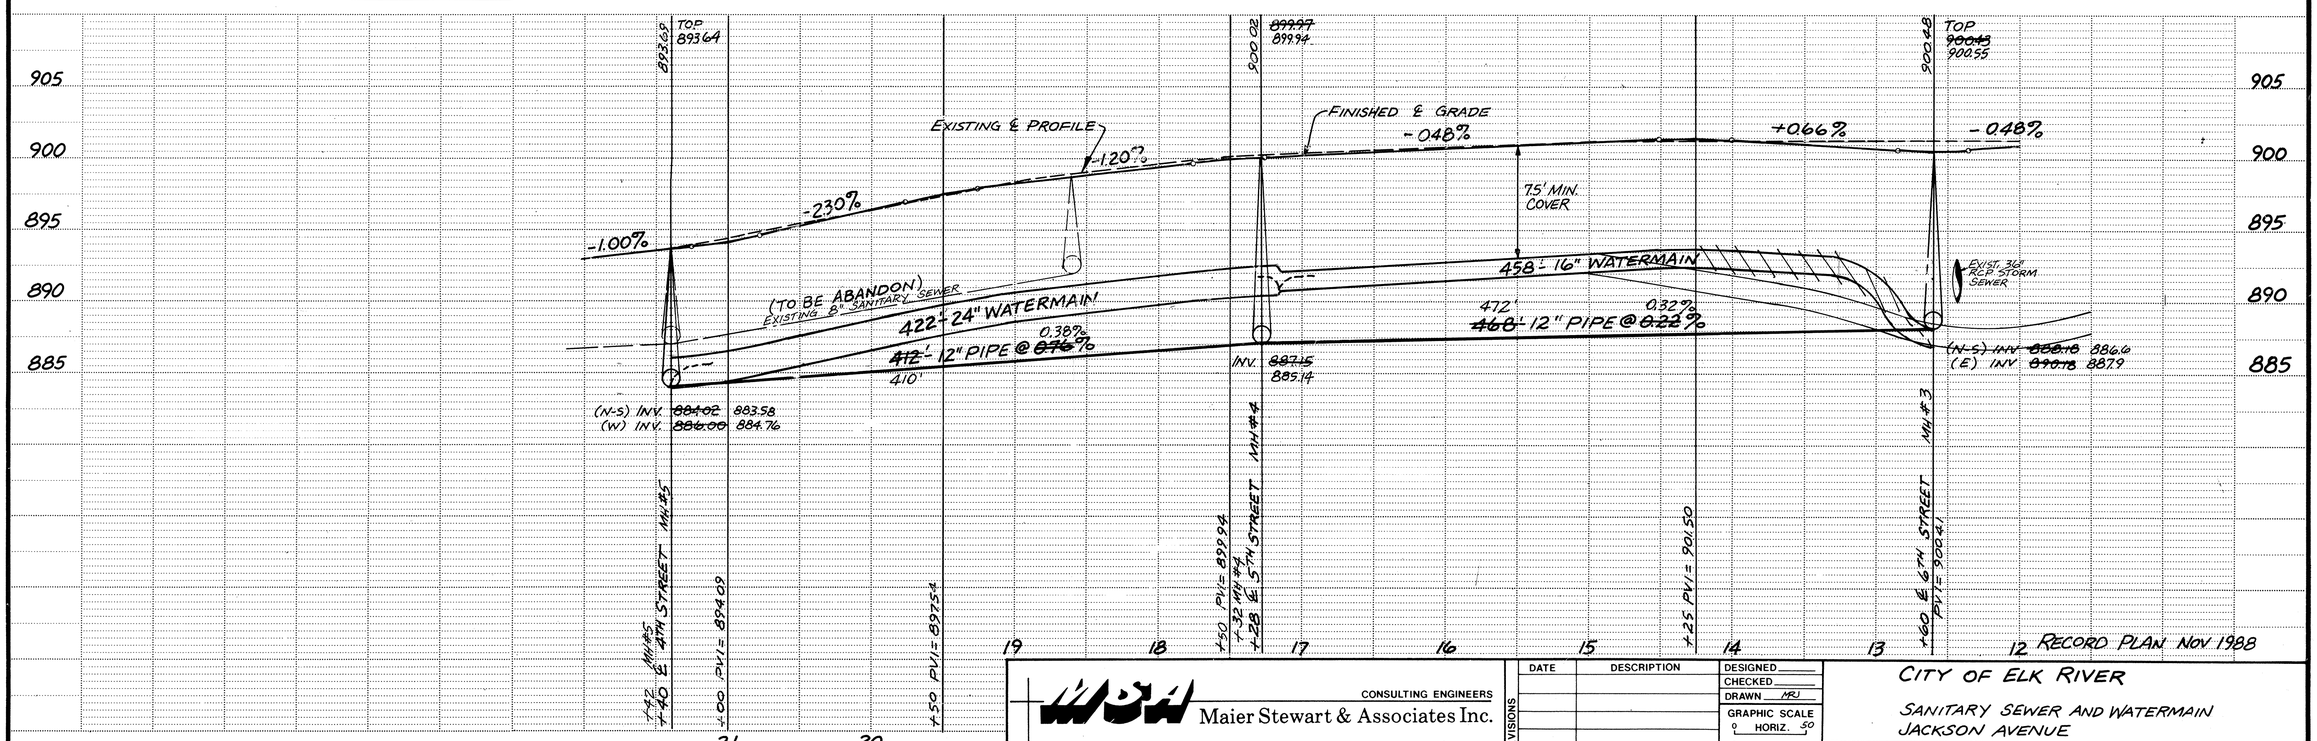

RECORD PLAN NOV 1988

REVISIONS	DATE	DESCRIPTION

DESIGNED ____ CHECKED ____ DRAWN MRJ

GRAPHIC SCALE 0 HORIZ. 50 0 VERT. 5

Maier Stewart & Associates Inc.
CONSULTING ENGINEERS
480 CEDAR STREET (612)227-9475 ST. PAUL, MINNESOTA 55101

CITY OF ELK RIVER

SANITARY SEWER AND WATERMAIN JACKSON AVENUE

DATE MAY 1987 | SHEET 6 OF 28 SHEETS | PROJECT NO. 230-032

MINNESOTA BLUEPRINT

220

DRAWING NUMBER

DRAWING NUMBER

DRAWING NUMBER
JACKS.87