

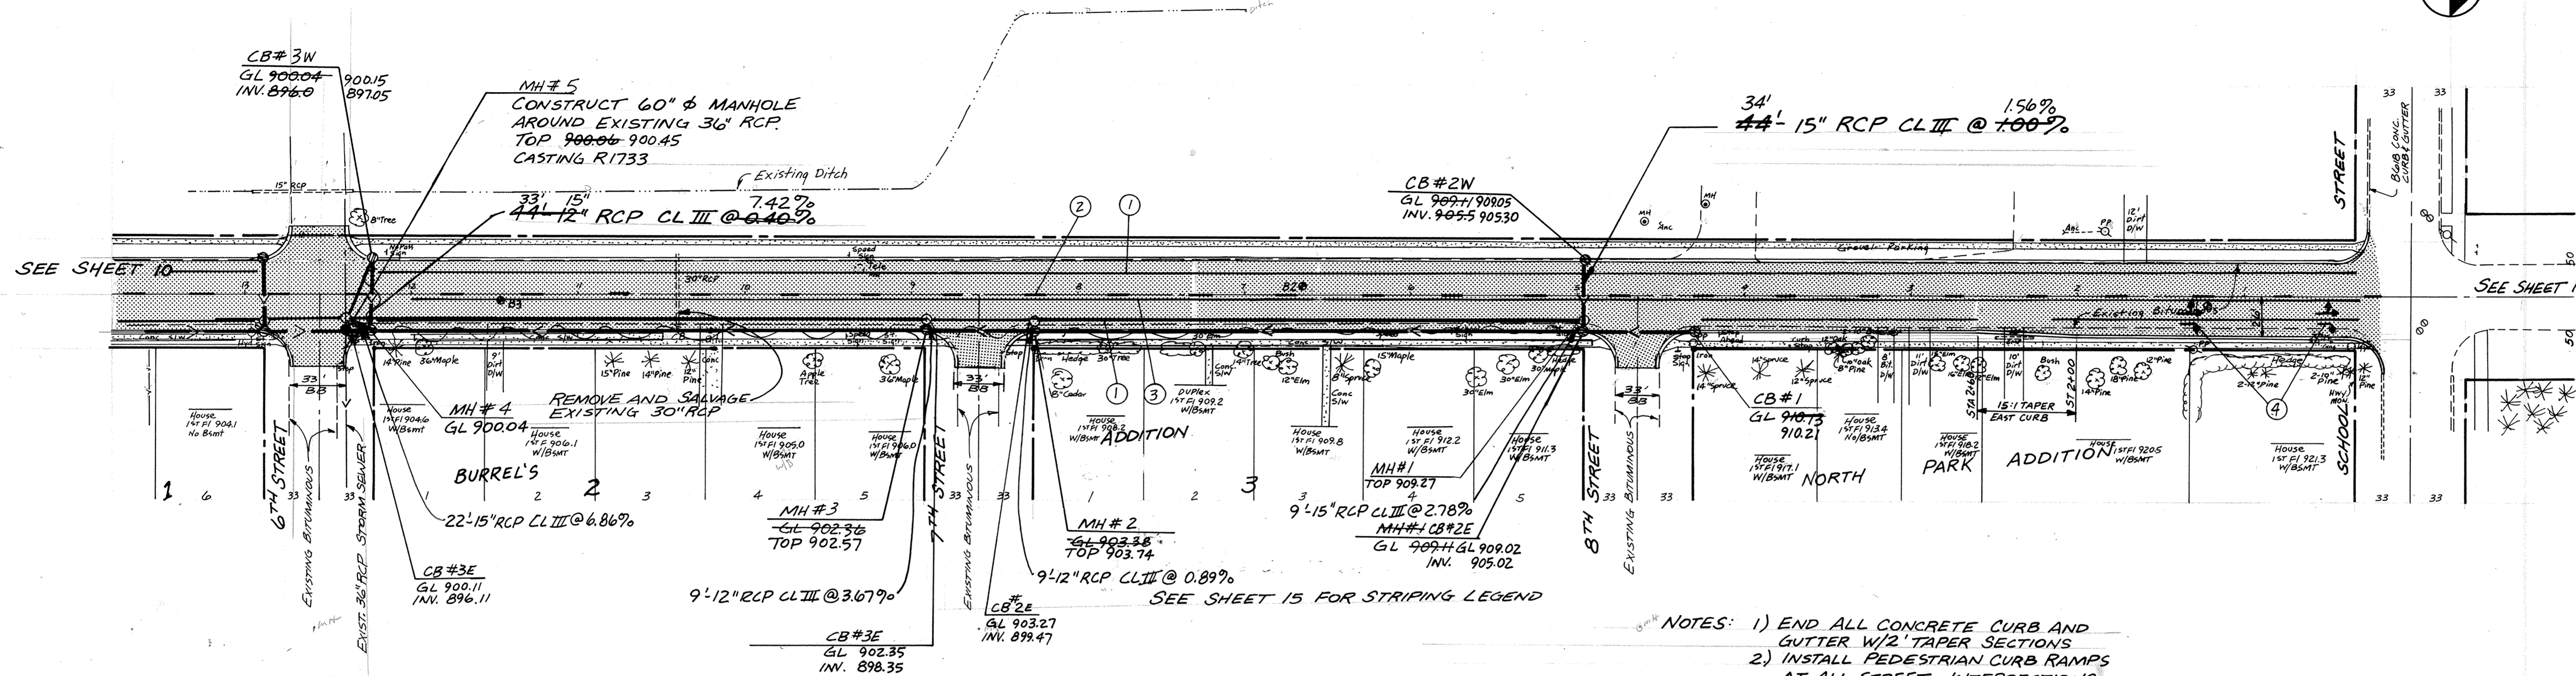


JACKSON AVENUE

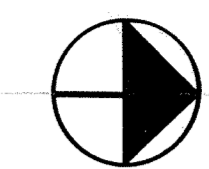

- NOTES:
- 1) END ALL CONCRETE CURB AND GUTTER W/2' TAPER SECTIONS
 - 2) INSTALL PEDESTRIAN CURB RAMPS AT ALL STREET INTERSECTIONS
 - 3) STRAIGHT LINE CUT, TACK AND MATCH EXISTING BITUMINOUS
 - 4) REMOVE & RELOCATE EXIST. SIGNS AS DIRECTED BY ENGINEER

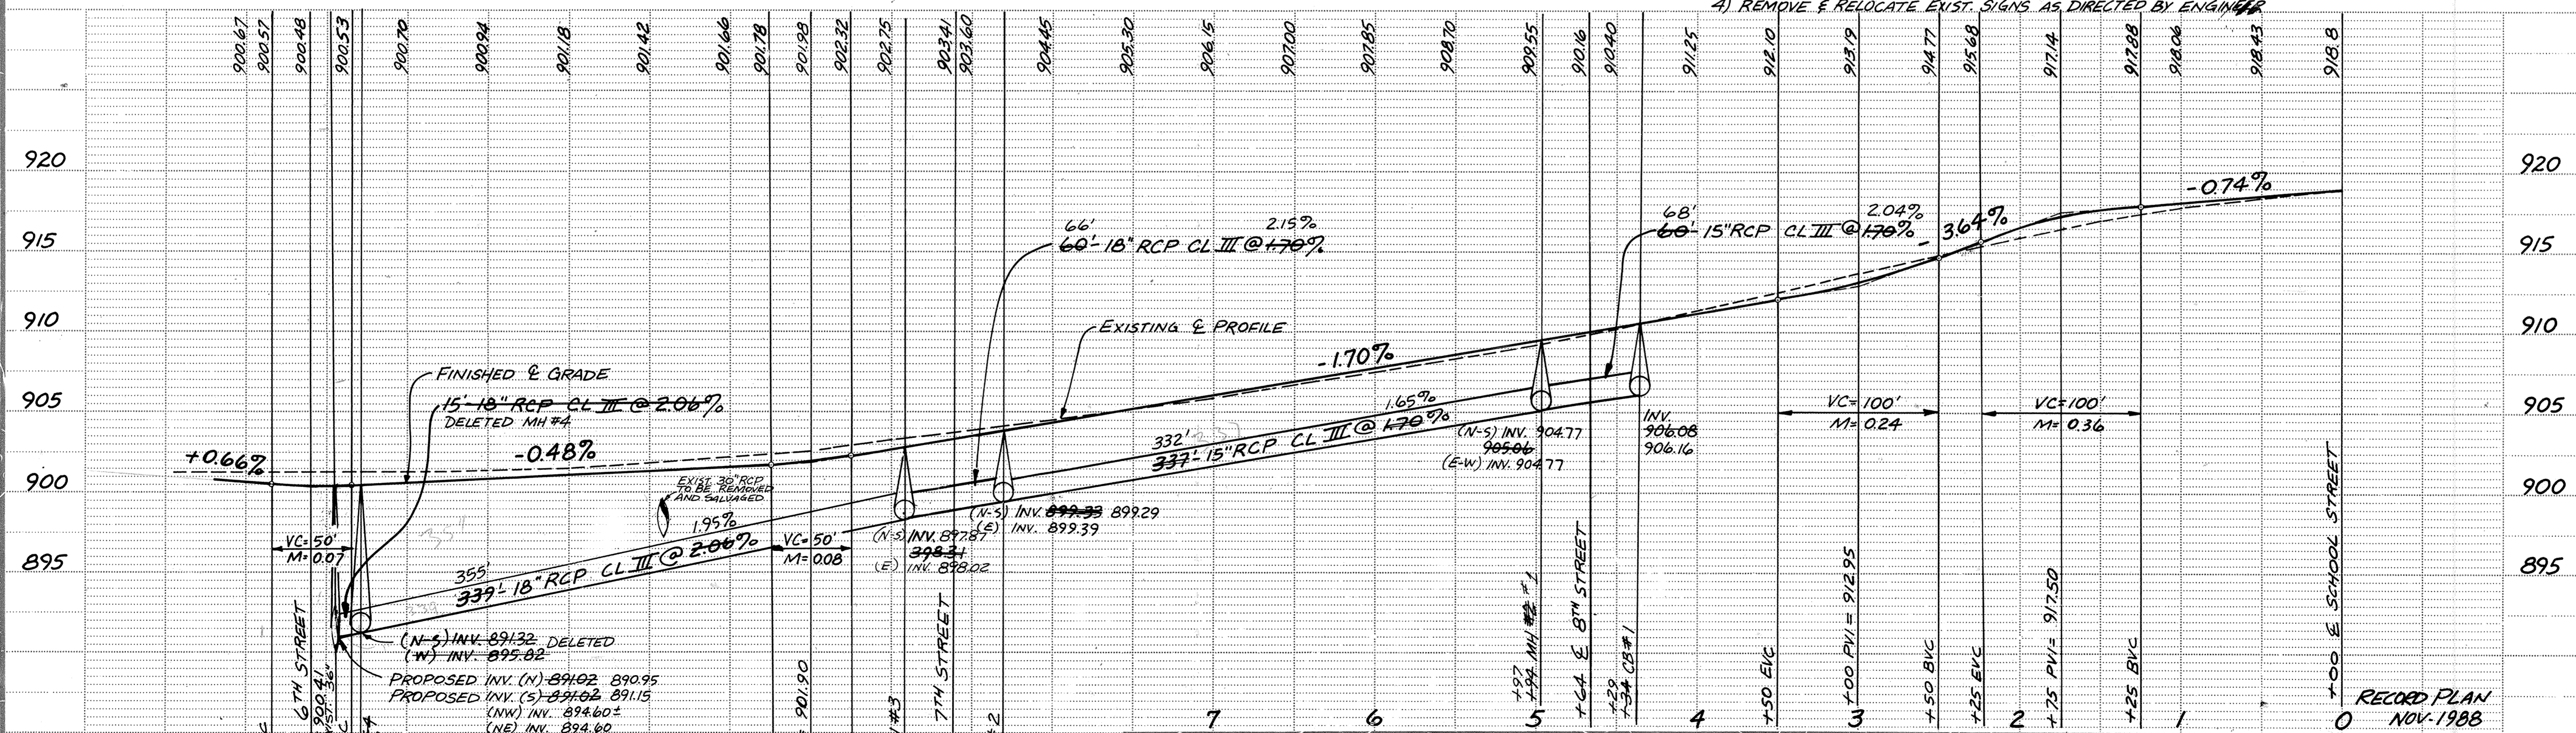

CONSULTING ENGINEERS
400 CEDAR STREET (612) 227-9475 ST. PAUL, MINNESOTA 55101

REVISIONS	DATE	DESCRIPTION

DESIGNED: _____
CHECKED: _____
DRAWN: MRJ
GRAPHIC SCALE
0 HORIZ. 50
0 VERT. 5

CITY OF ELK RIVER
STREET CONSTRUCTION
JACKSON AVENUE

DATE MAY 1987 SHEET 9 OF 28 SHEETS PROJECT NO. 230-032

DRAWING NUMBER JACKS 87